
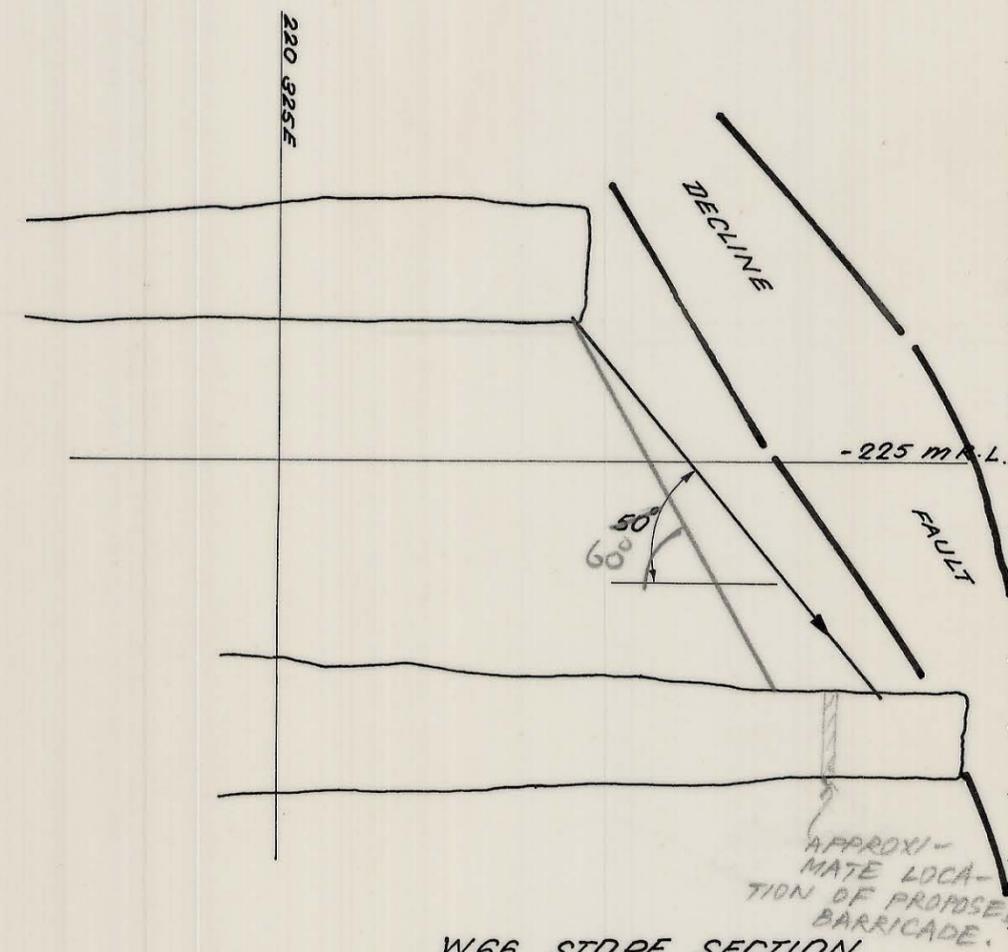


MAL,
 COULD YOU PLEASE MARK THIS
 HOLE ON W66 220 NEXT WORK.
 DJK.

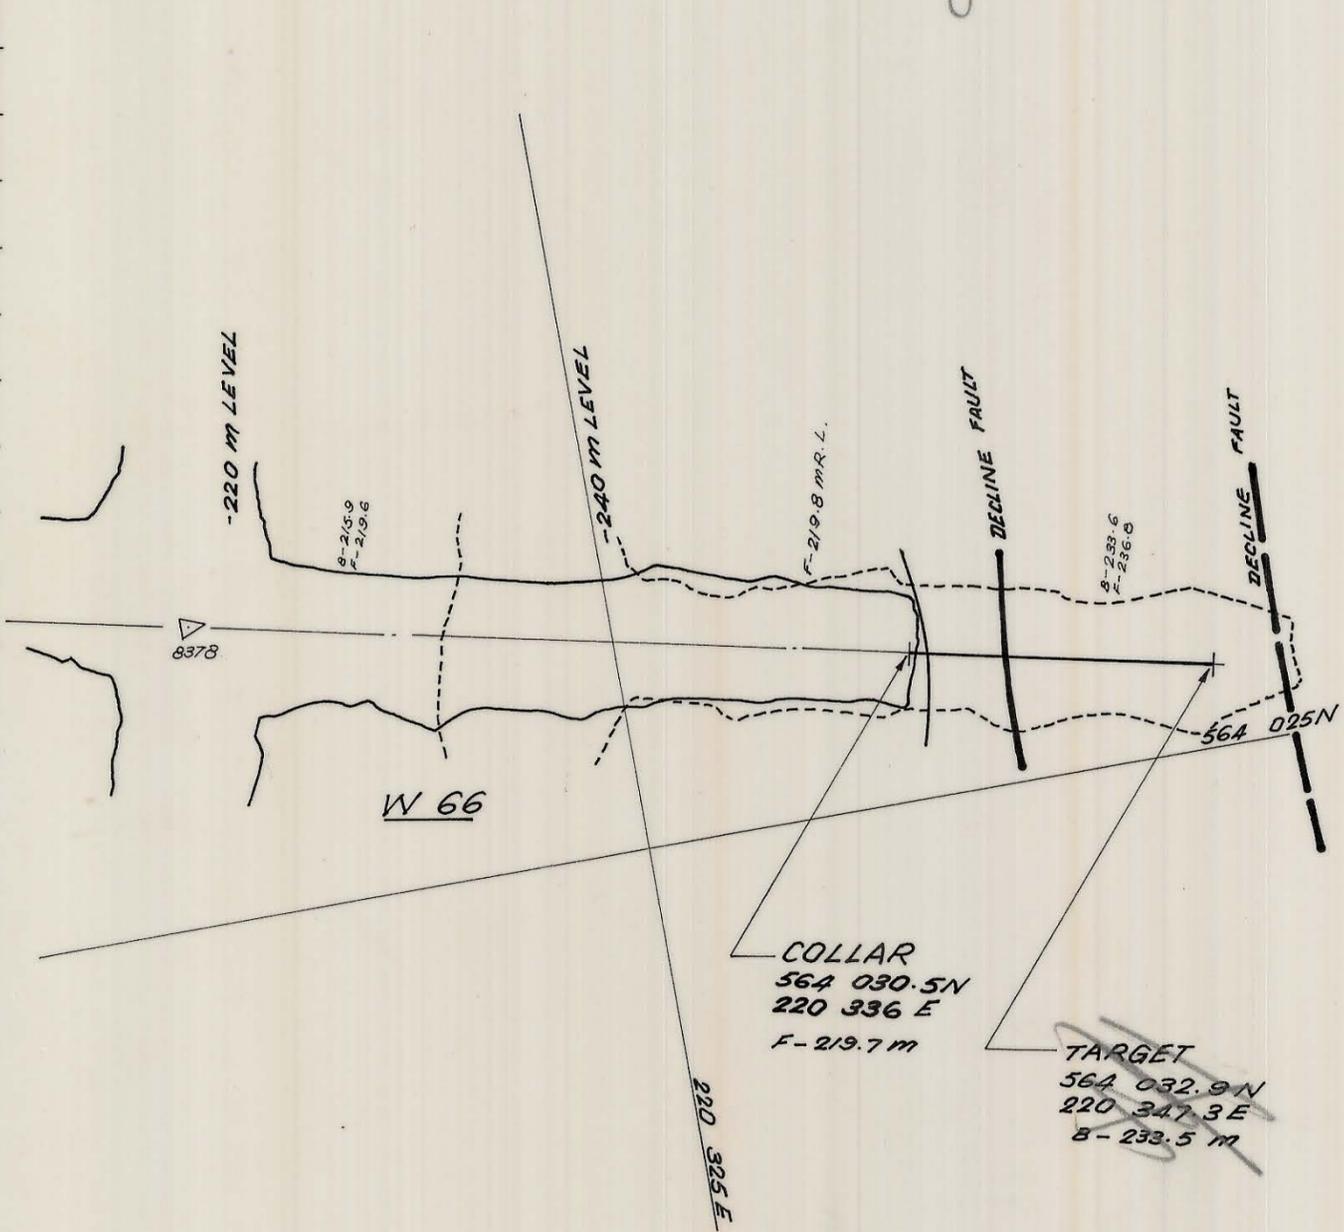

LENGTH OF HOLE = 78 m 16m
 BEARING = 102°
 INCLINATION = 50° 60°

REF PLAN 03DM12-156 140, -156 147.	GEOLOGY		SCALE 1: 250	
	SURVEY			
	PLANNING	P.B. 10-0-87	DOLPHIN MINE CONCRETE HOLE FROM -220 LEVEL TO -240 LEVEL, W 66.	
	ROCK MEC.			
	MINE SURF.			
G.M.S.		DRAWING NUMBER	03DM13-3006	
T.S.S.				