


5 cm

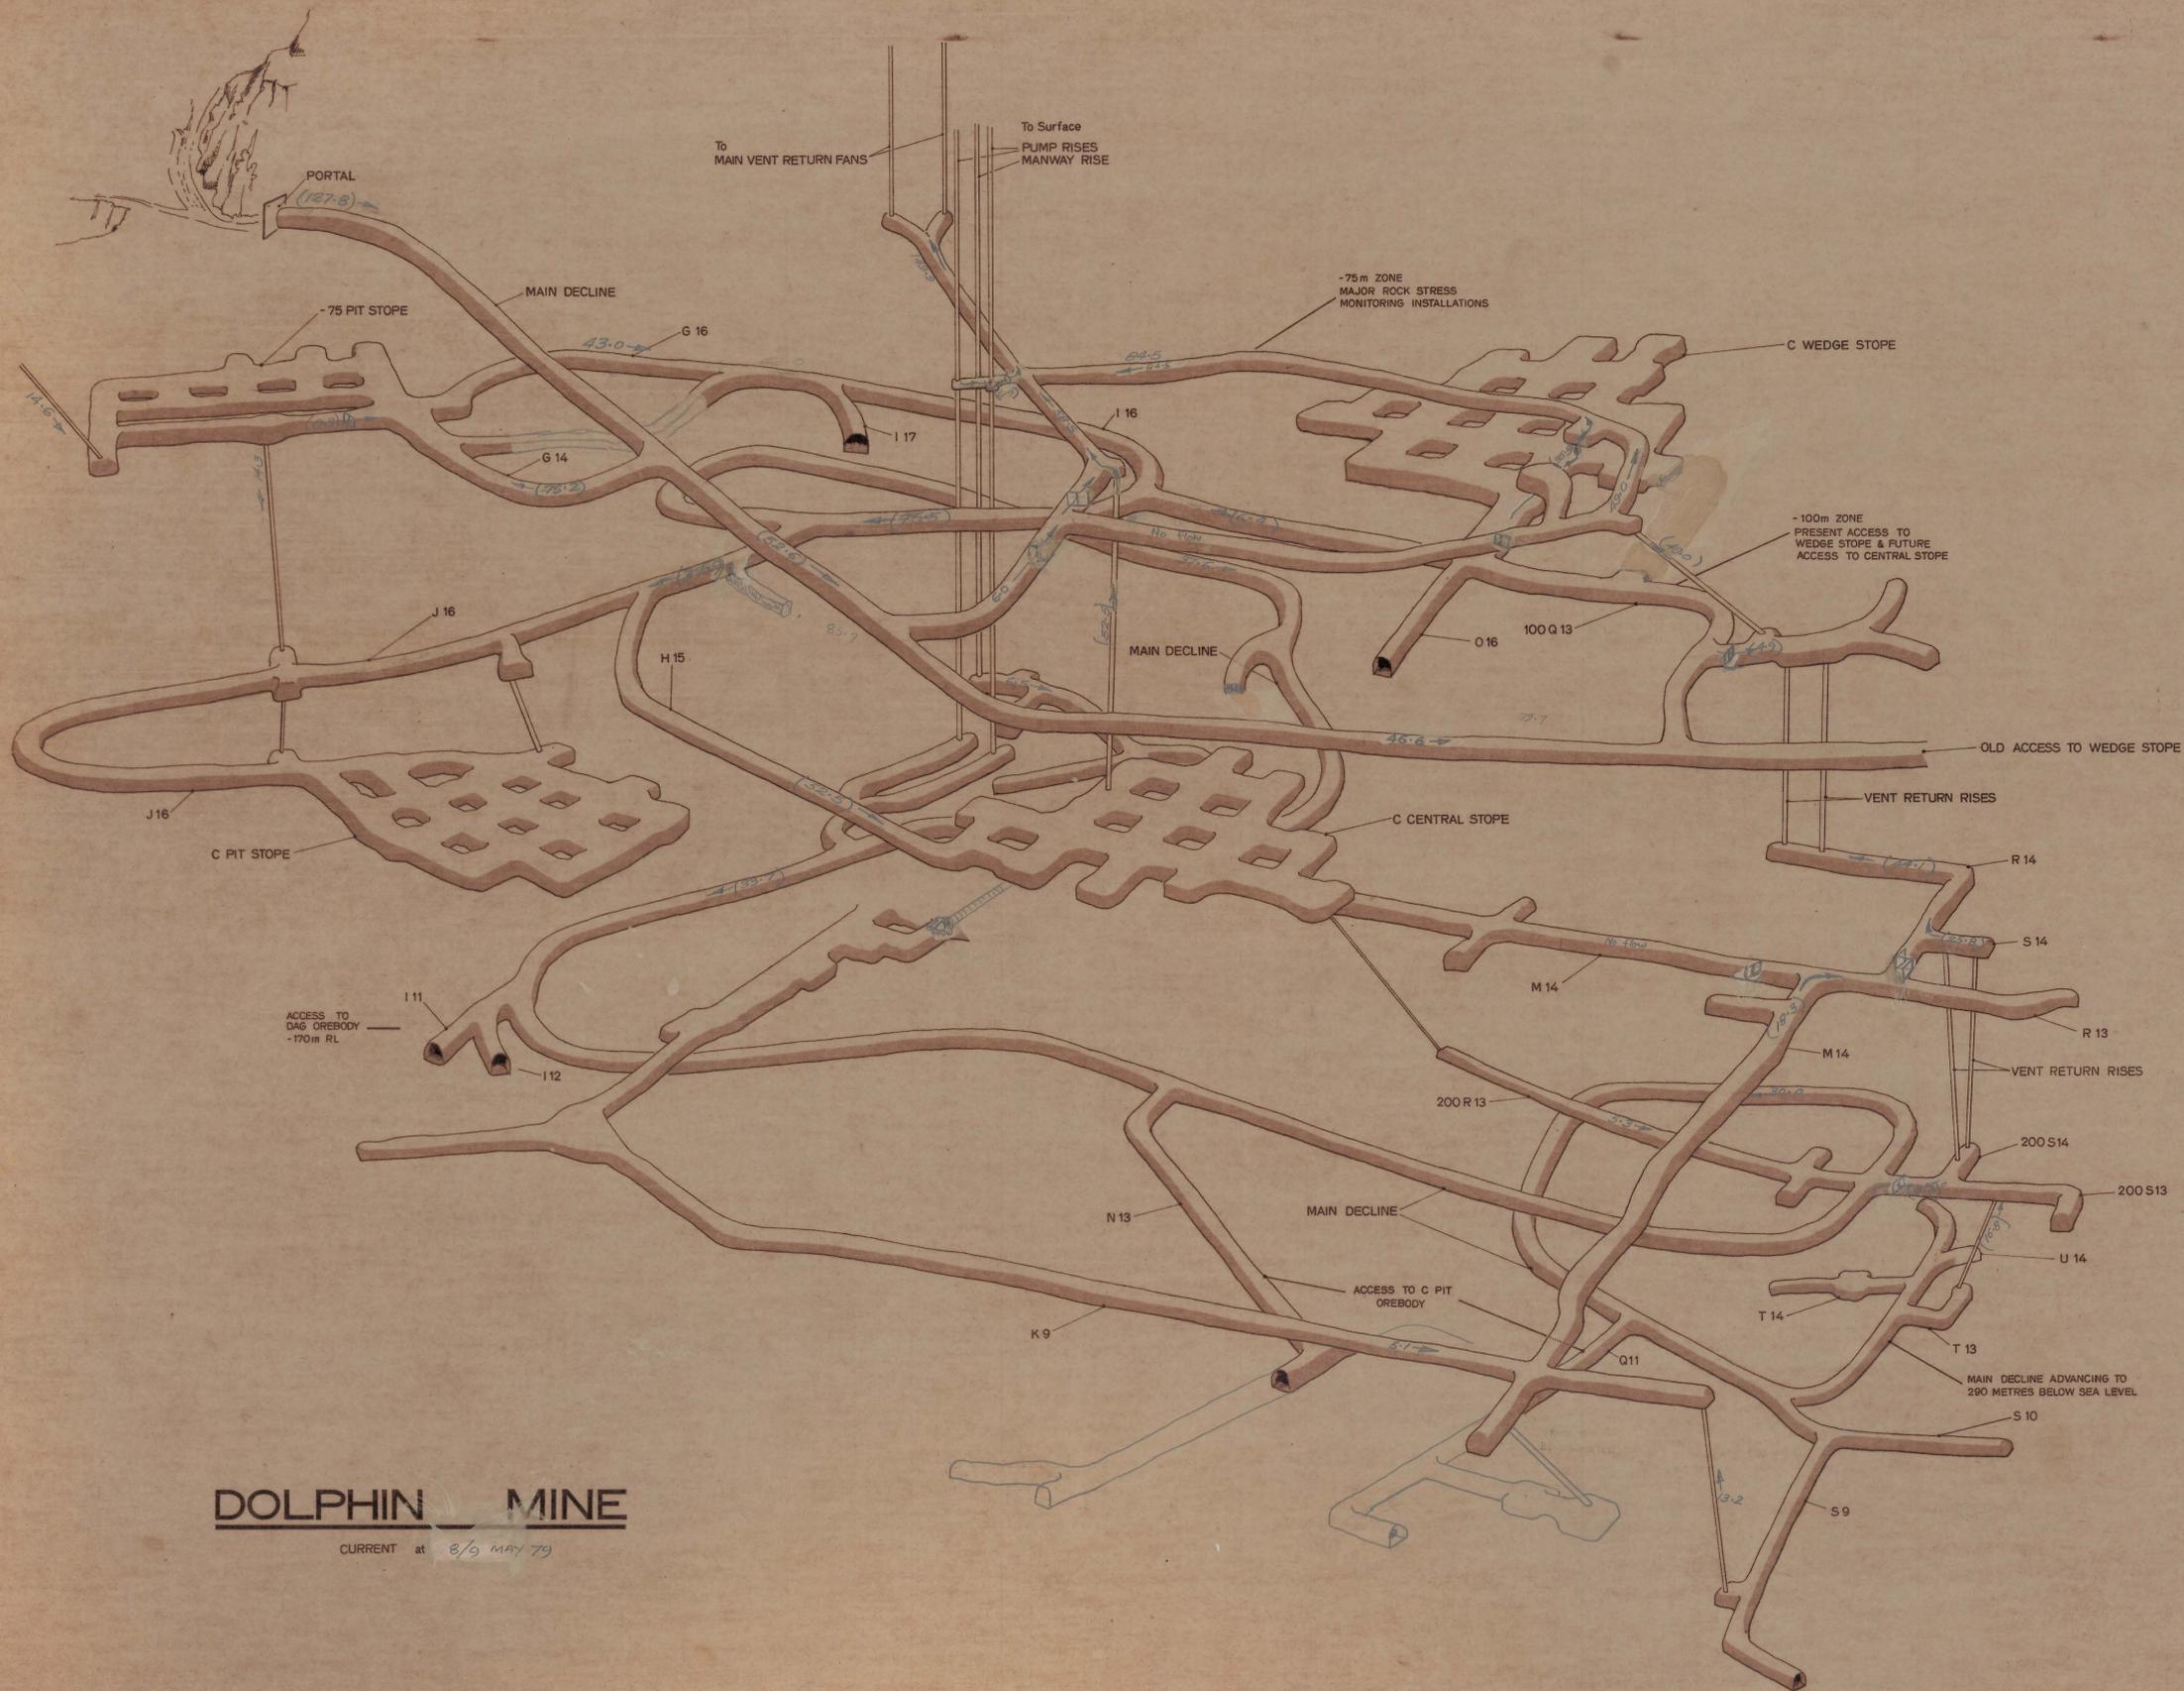

**DOLPHIN MINE**  
 CURRENT at 8/9 MAY 79