


05 DM 09 - ORIGINAL

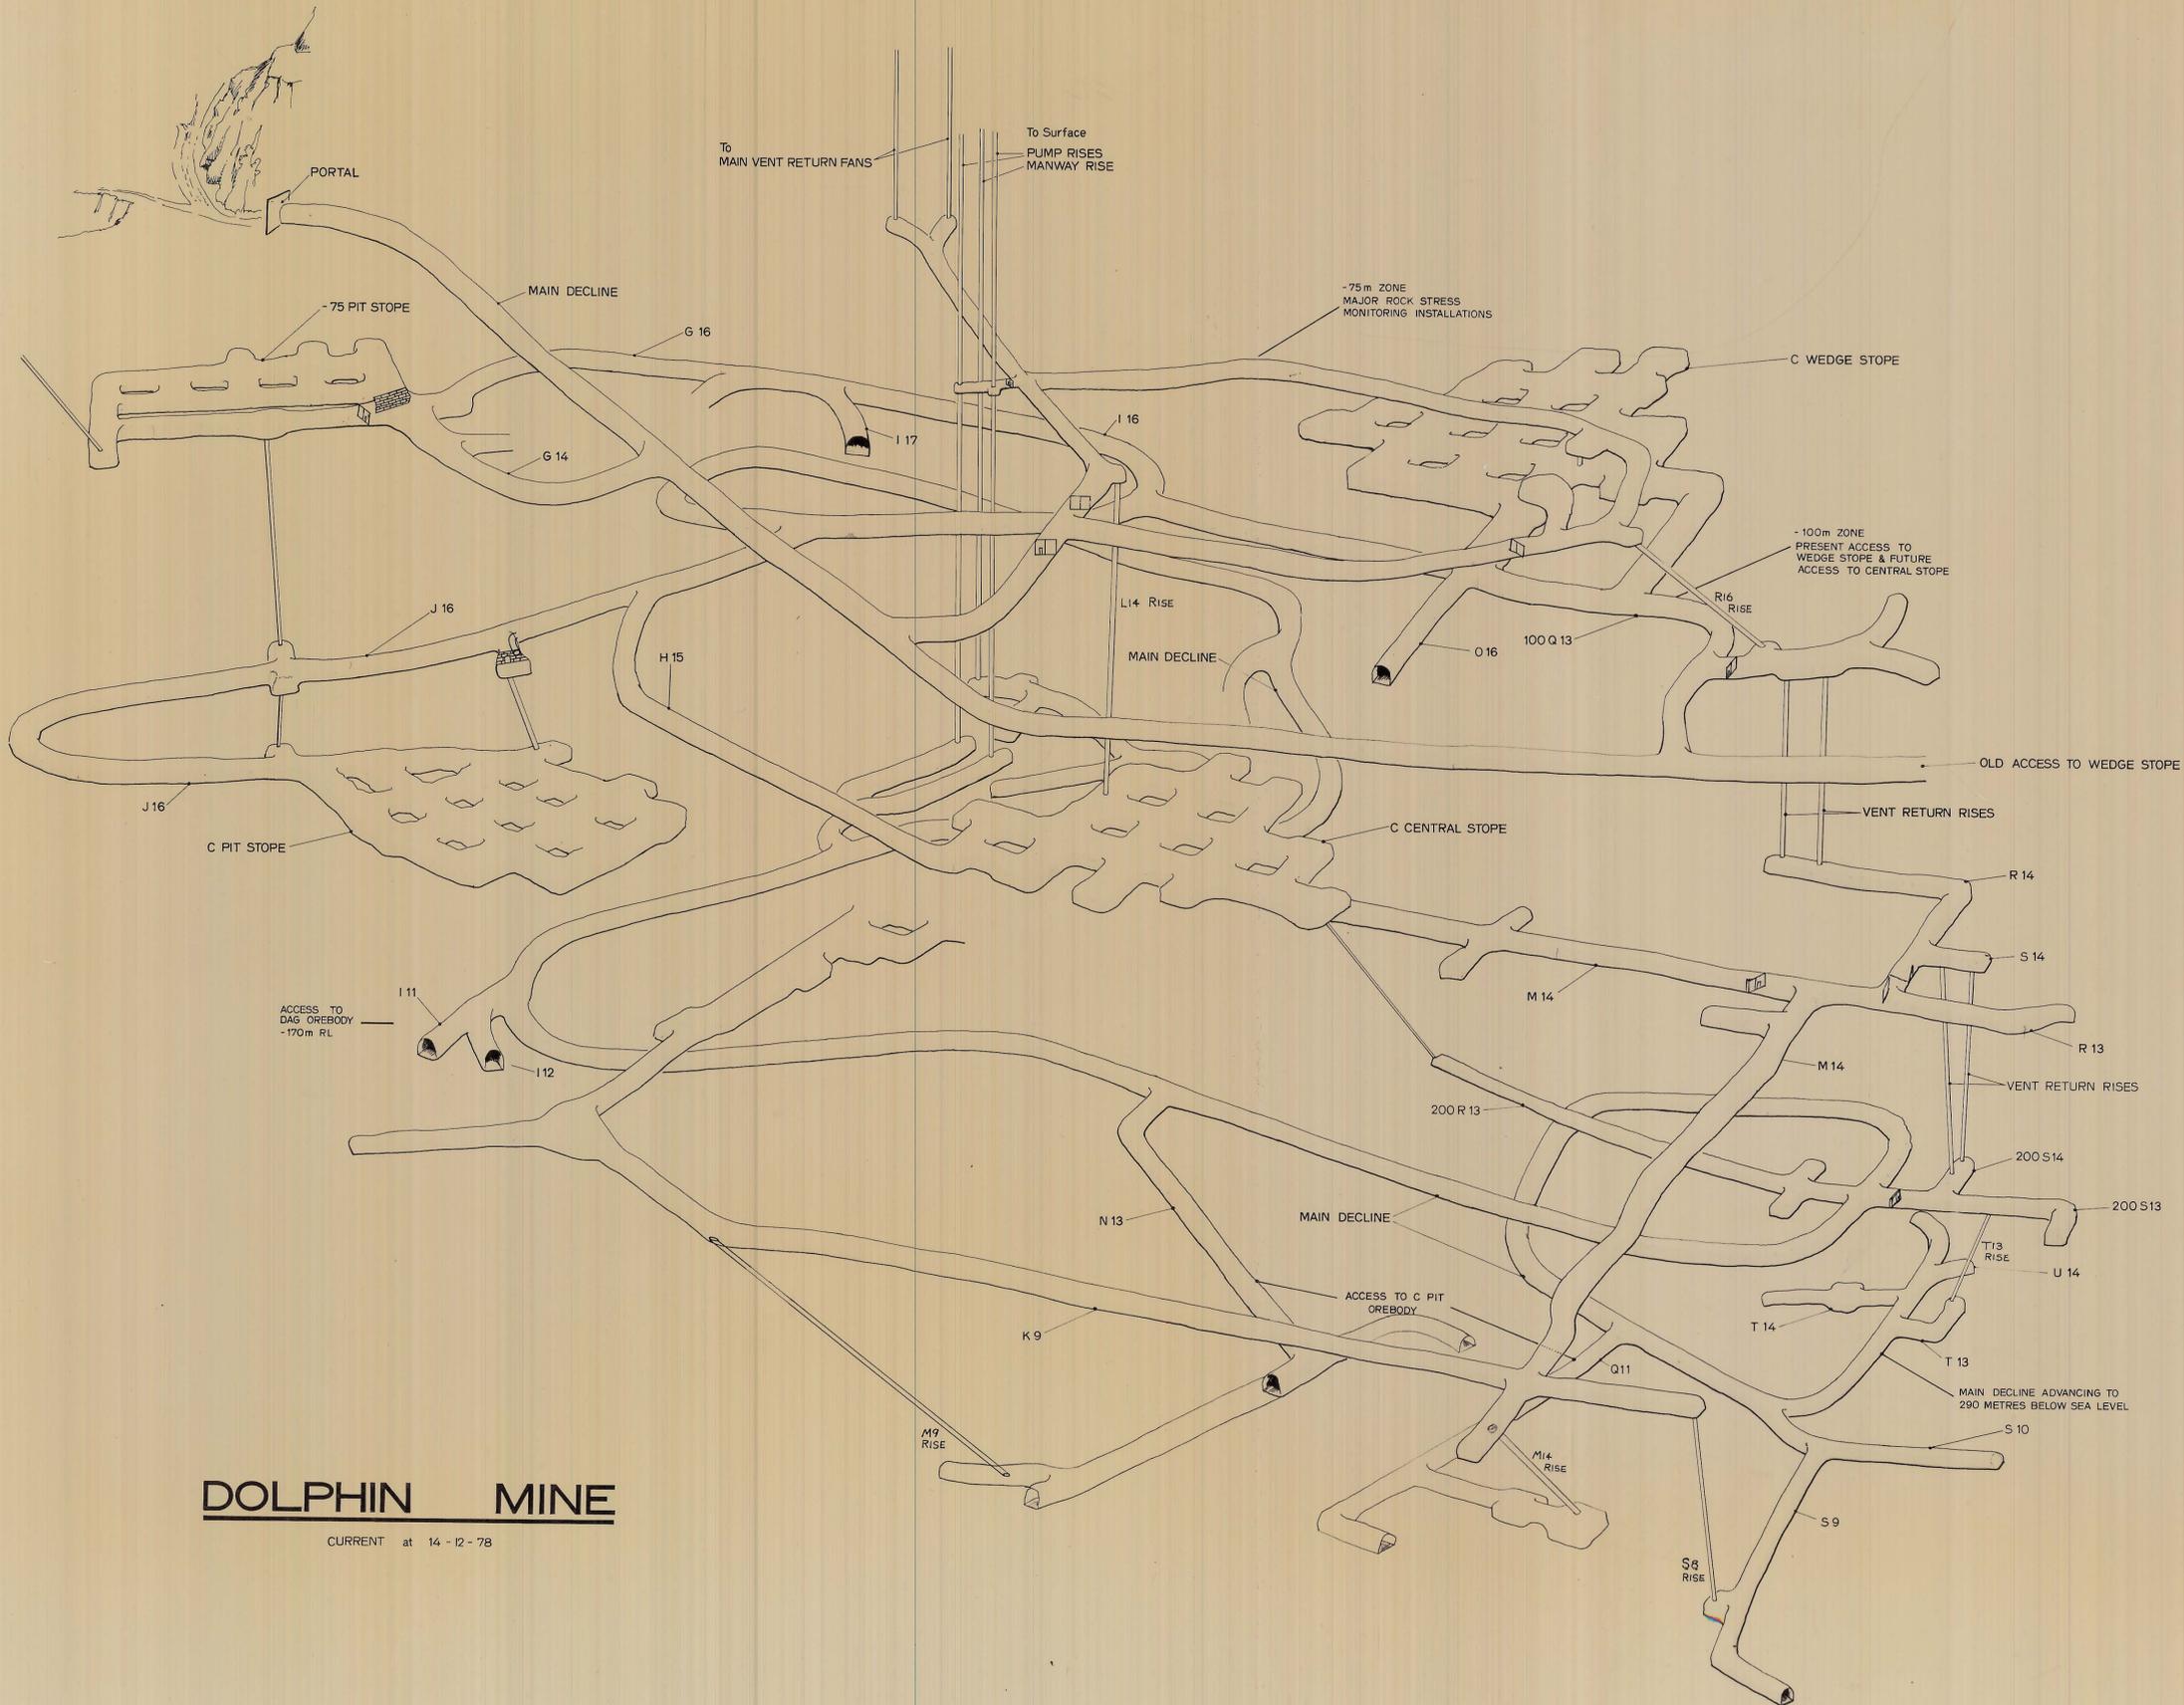

# DOLPHIN MINE

CURRENT at 14 - 12 - 78