


0374\_3434

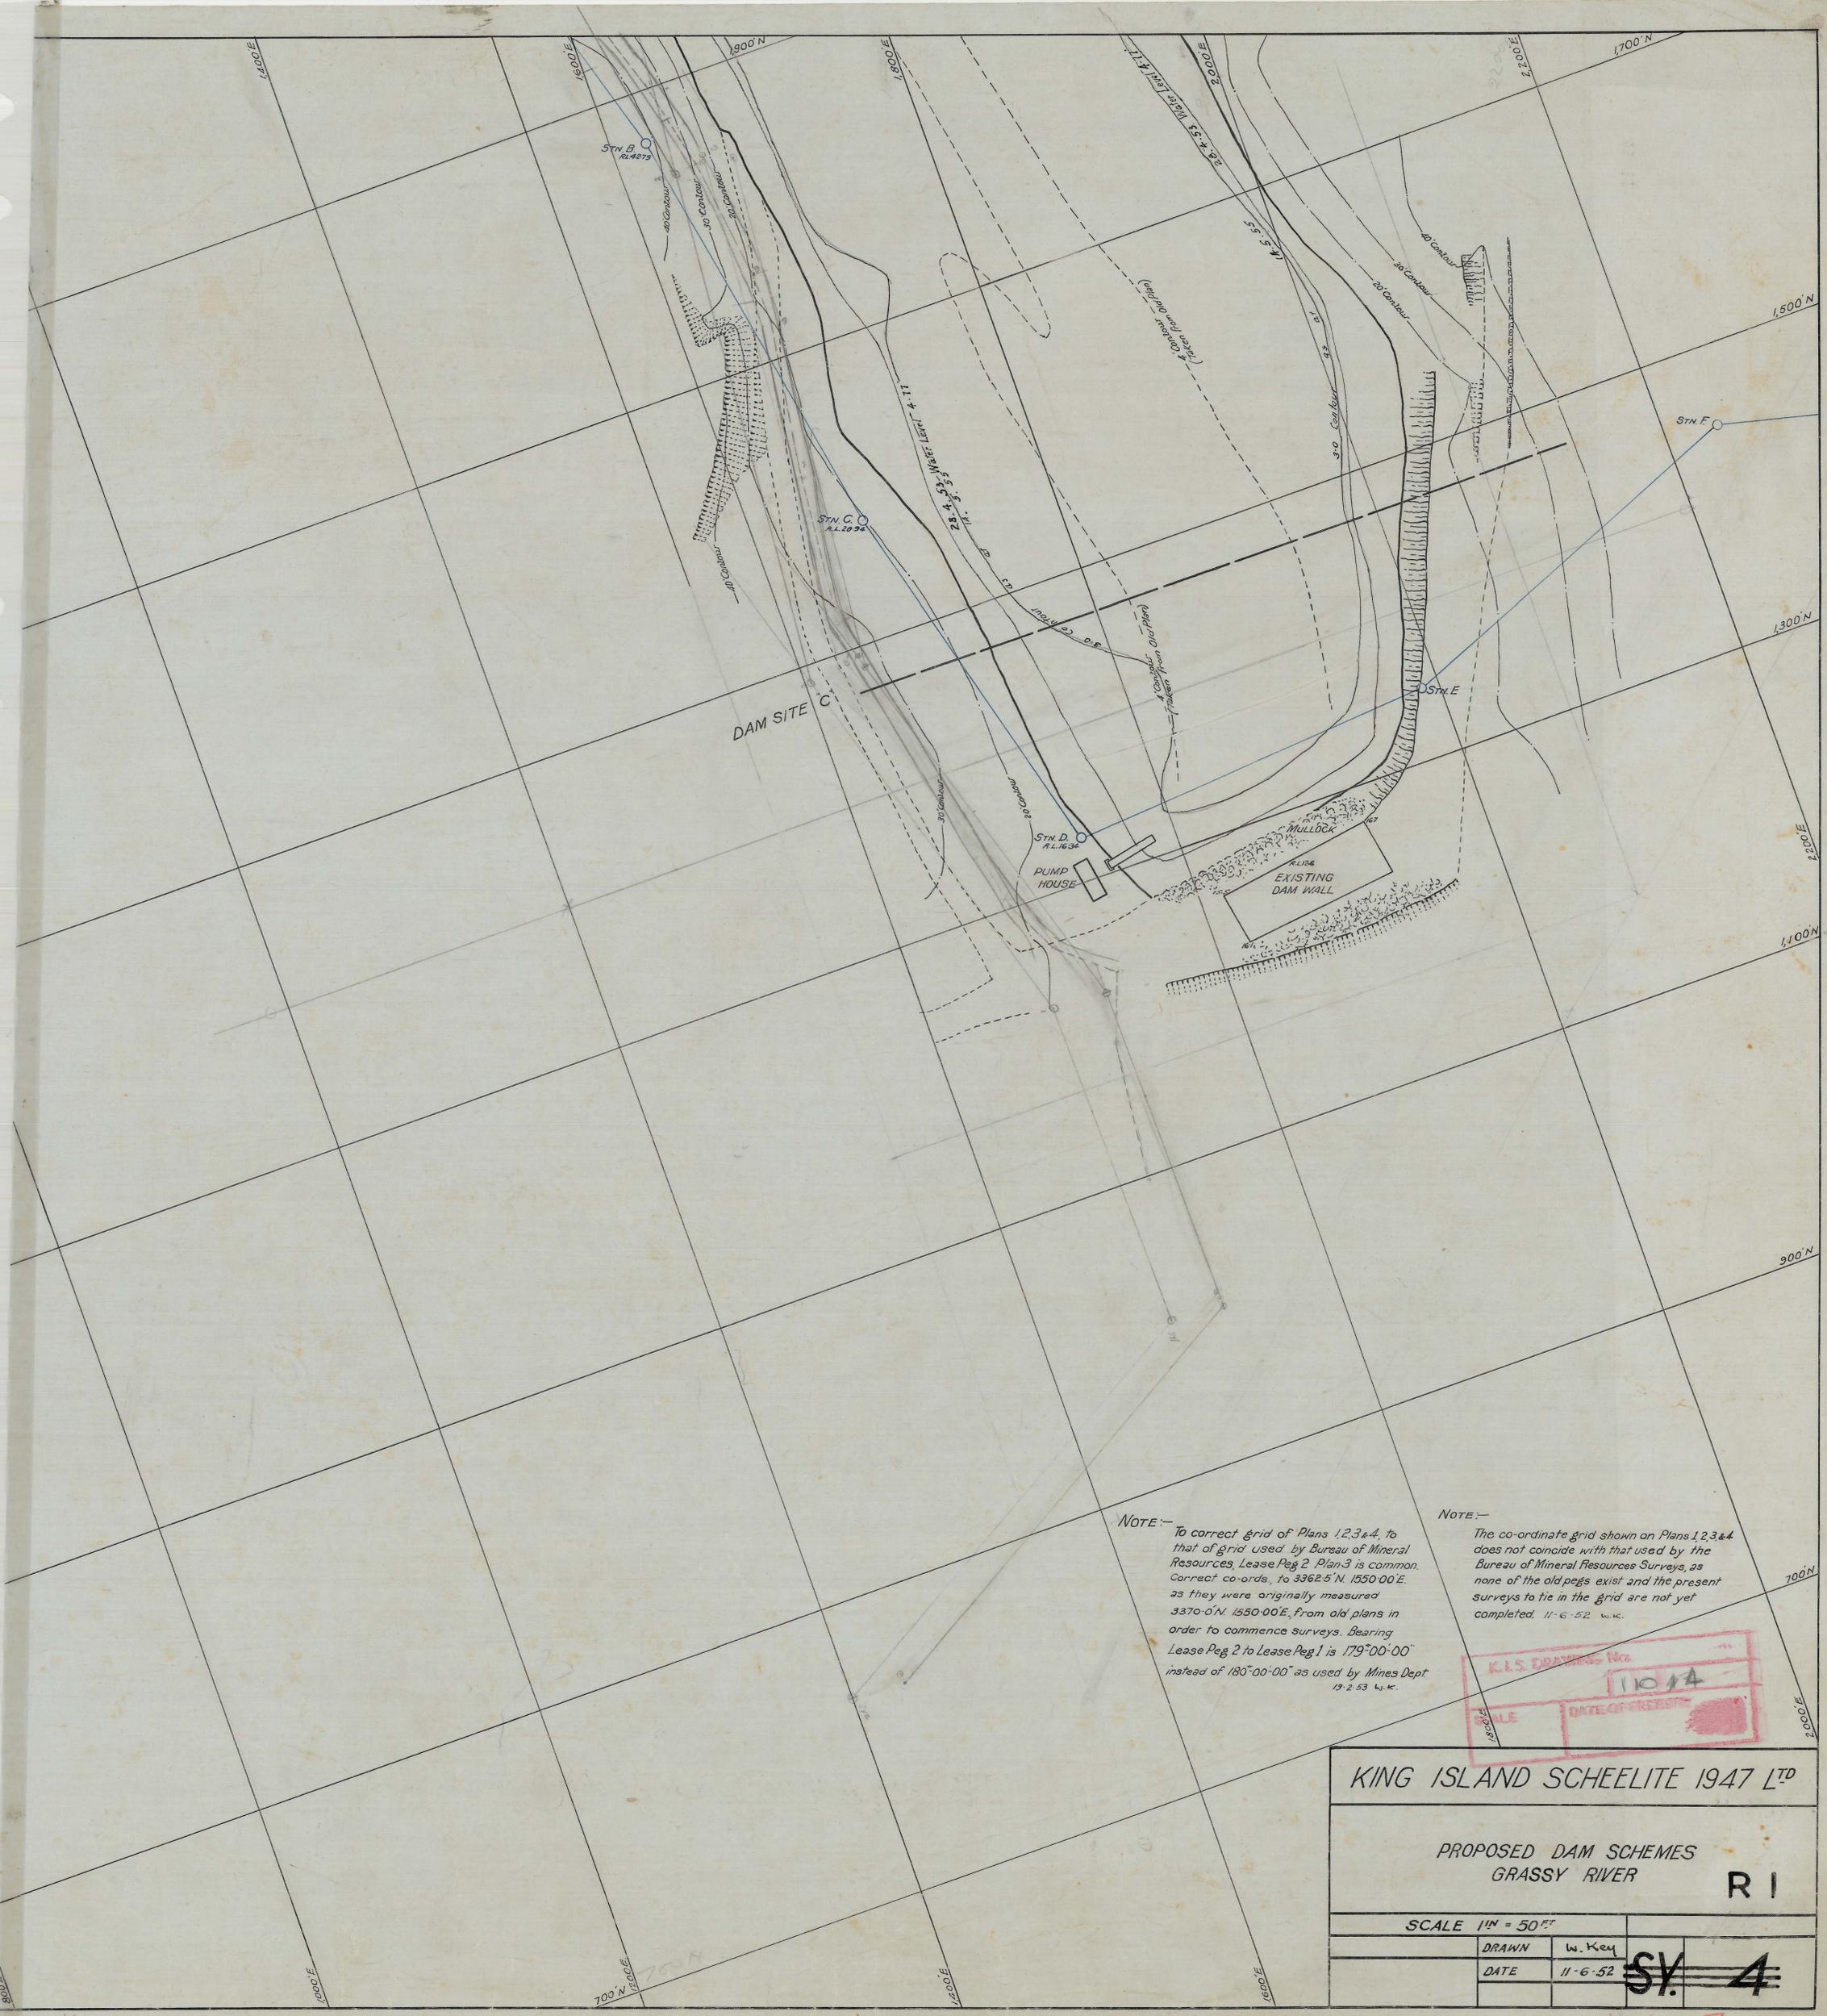

NOTE -  
 To correct grid of Plans 1,2,3&4 to that of grid used by Bureau of Mineral Resources, Lease Peg 2. Plan 3 is common. Correct co-ords. to 3362.5'N, 1550.00'E. as they were originally measured 3370.0'N, 1550.00'E. from old plans in order to commence surveys. Bearing Lease Peg 2 to Lease Peg 1 is 179°00'00" instead of 180°00'00" as used by Mines Dept 13-2-53 W.K.

NOTE -  
 The co-ordinate grid shown on Plans 1,2,3&4 does not coincide with that used by the Bureau of Mineral Resources Surveys, as none of the old pegs exist and the present surveys to tie in the grid are not yet completed. 11-6-52 W.K.

K.I.S. DRAWINGS No. 11014  
 SCALE DATE OF PREPARED

KING ISLAND SCHEELITE 1947 LTD

PROPOSED DAM SCHEMES  
 GRASSY RIVER R I

SCALE 1" = 50 FT

DRAWN	W. Key
DATE	11-6-52

SY. 4

1-10-7