


0374_3460



Note: Undermined outline conventional
 as from 26-2-75
 M.D.B.

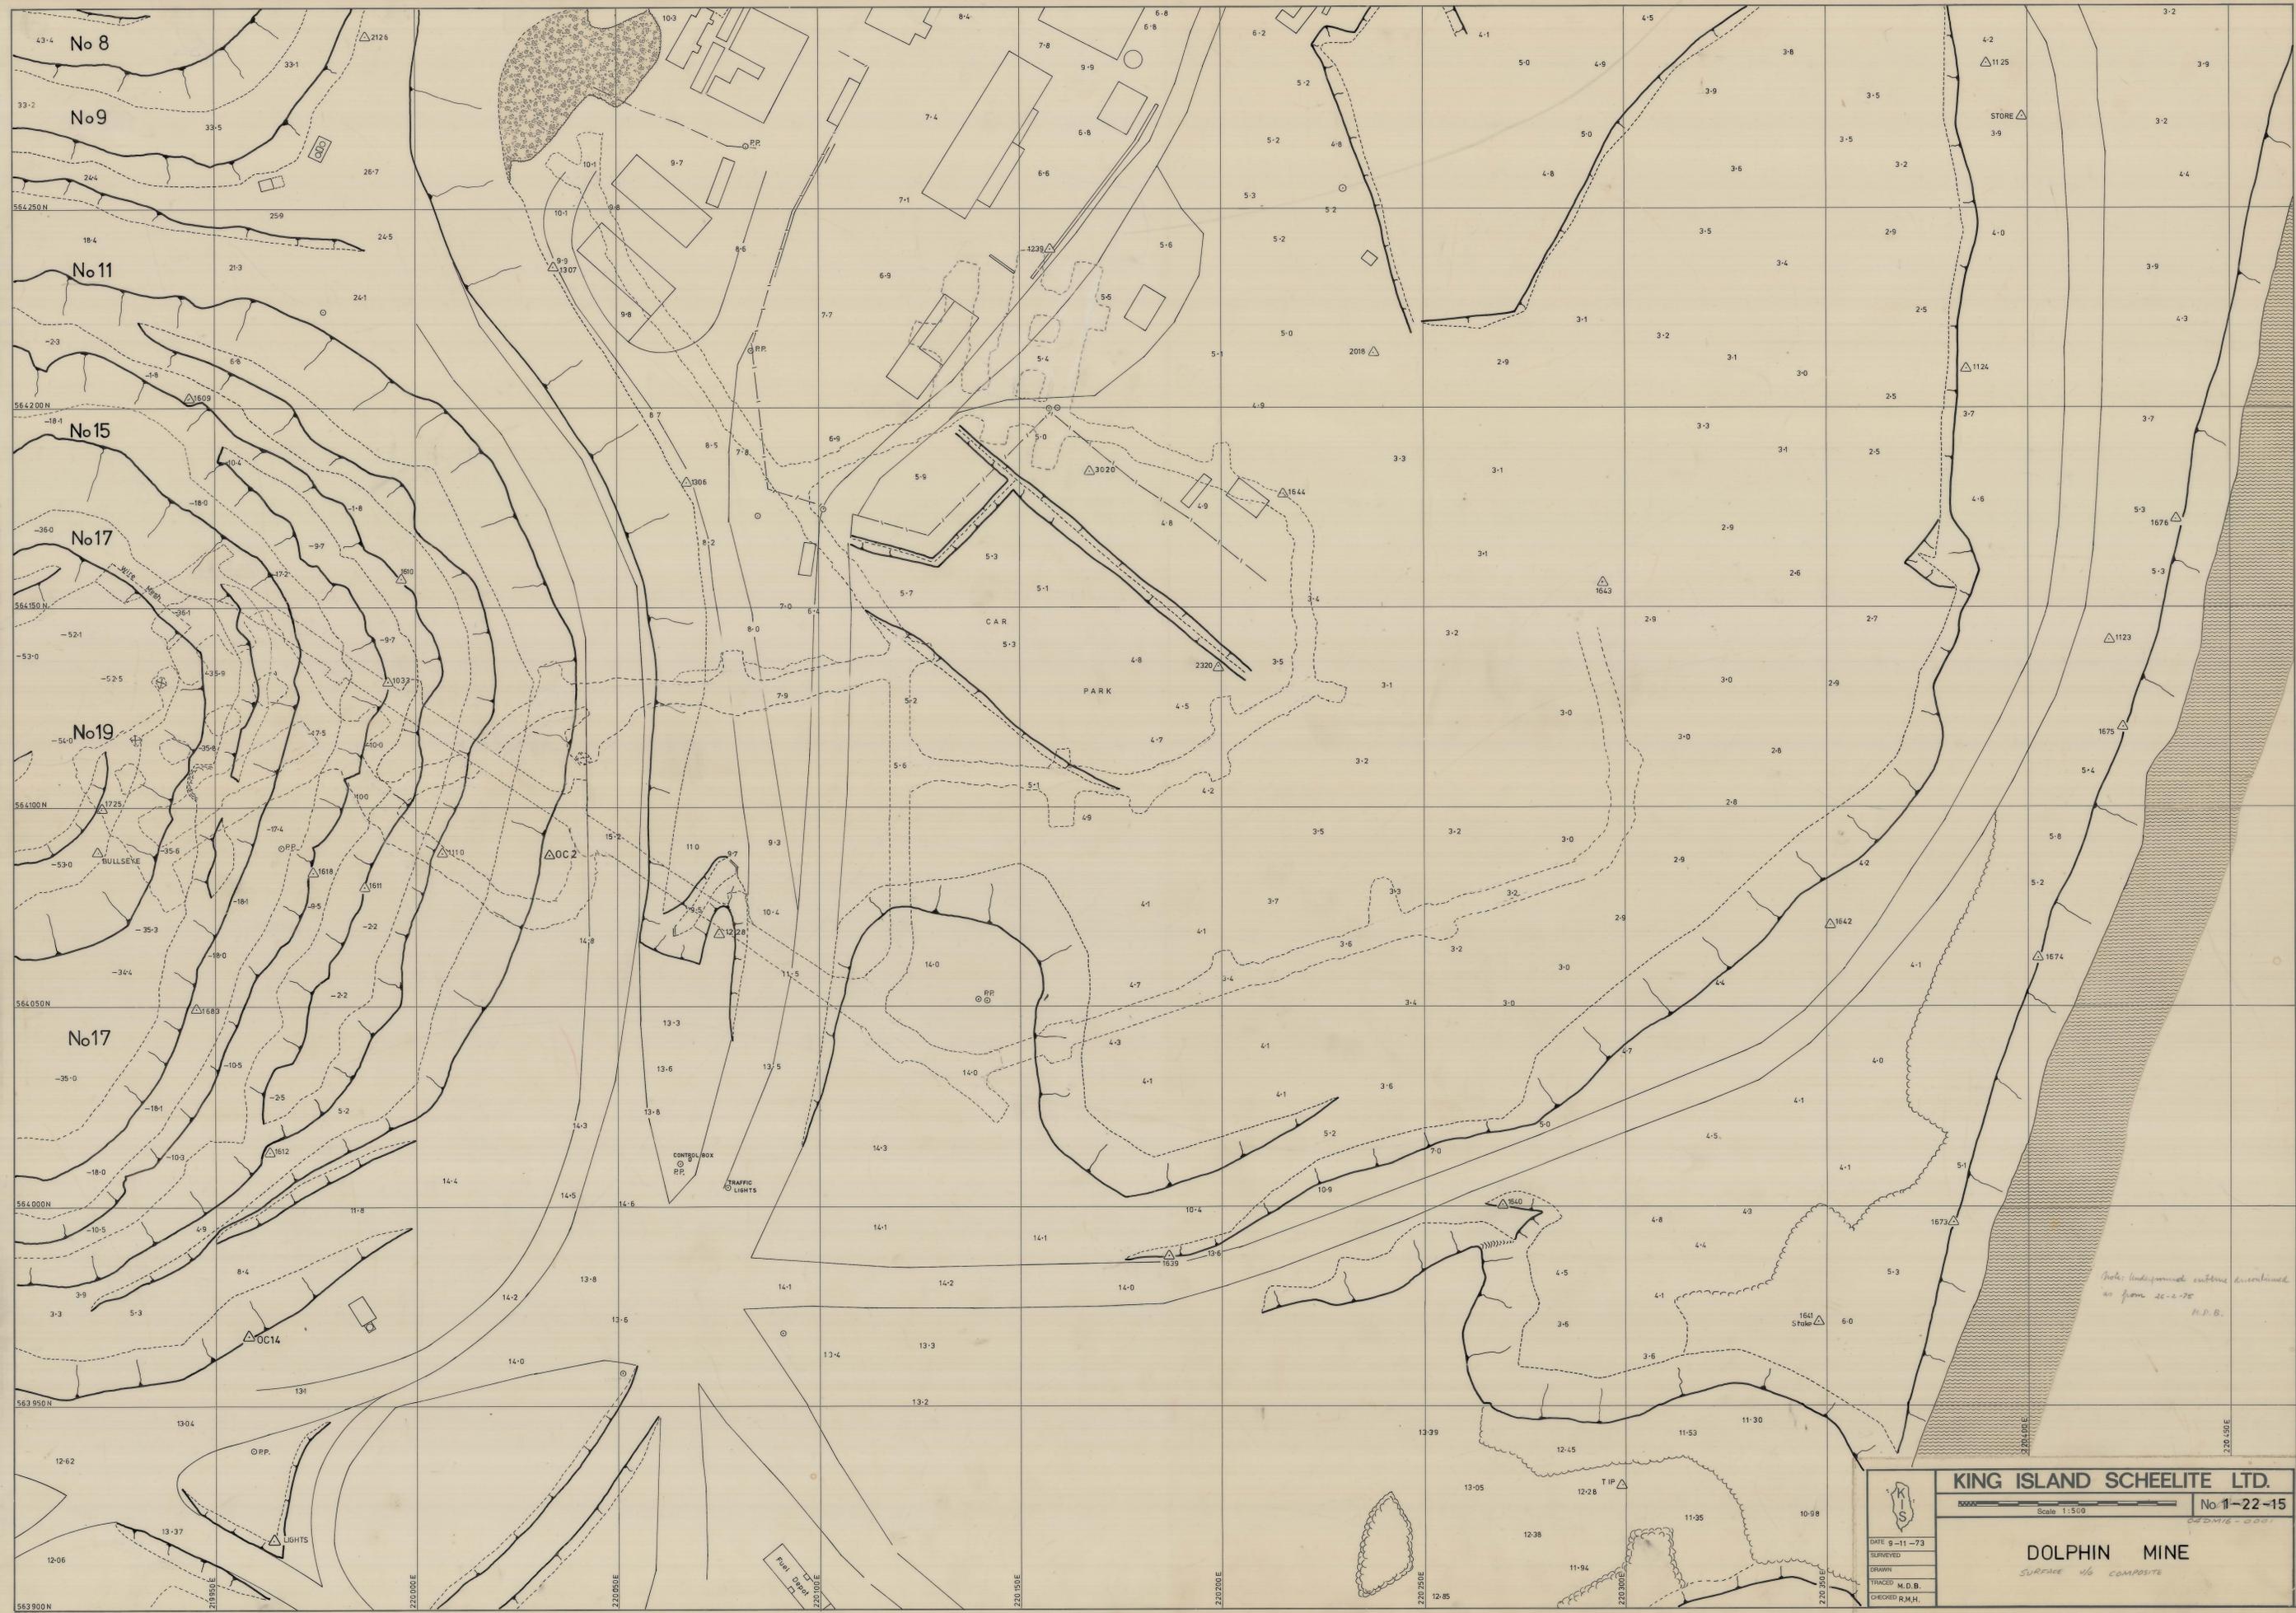

KING ISLAND SCHEELITE LTD.	
Scale 1:500	
No 1-22-15	
DOLPHIN MINE	
SURFACE 4/6 COMPOSITE	
DATE 9-11-73	
SURVEYED	
DRAWN	
TRACED M.D.B.	
CHECKED R.M.H.	