


5 cm

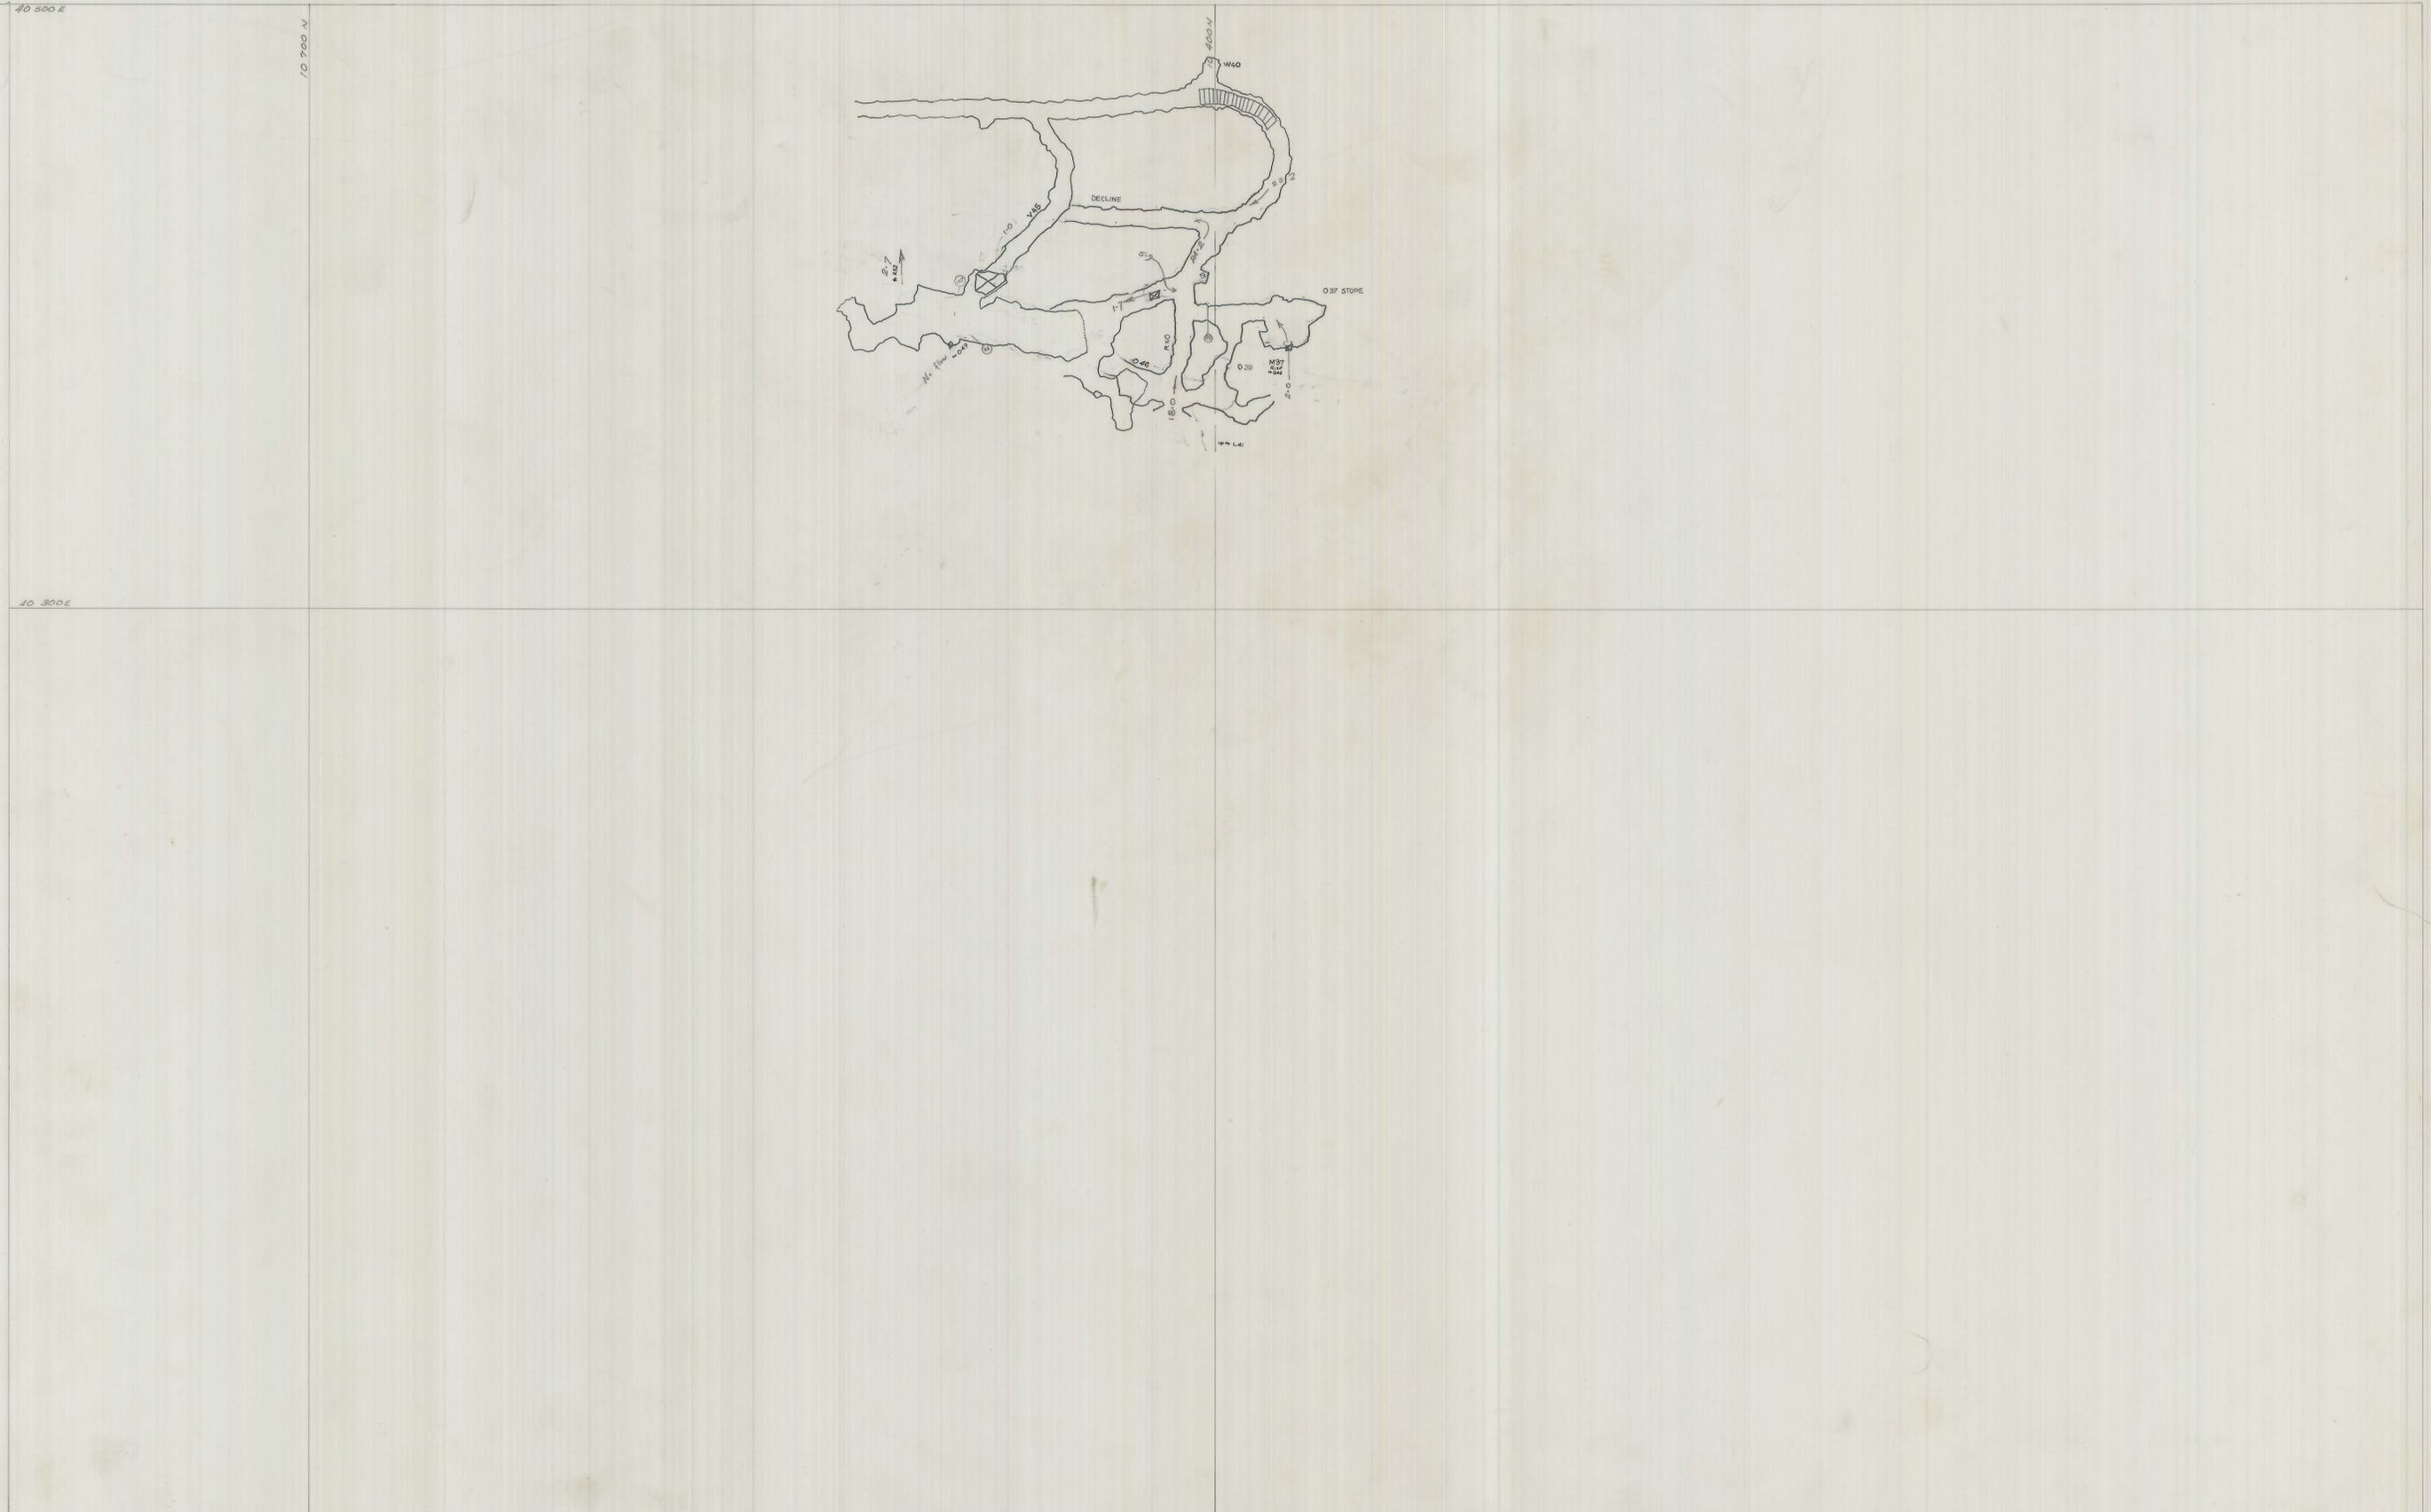

SCALE 1:1000

LOCATION BOLD HEAD

SUBJECT AIRFLOW PLAN

B FAULT BLOCK

FEB 81



north

KIS KING ISLAND SCHEELITE
A DIVISION OF WARMAN INTERNATIONAL

GRASSY KING ISLAND

PLAN NUMBER
05B405-100512