


5 cm

0374_3485



SCALE 1

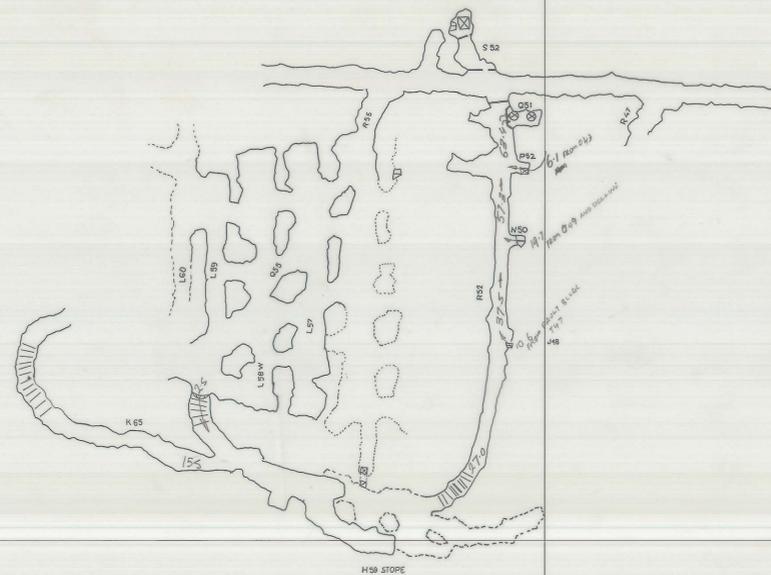

north

LOCATION

SUBJECT

KIS KING ISLAND SCHEELITE
A DIVISION OF WAGNER INTERNATIONAL
 GRASSY KING ISLAND
 PLAN NUMBER