


05BH05-100131

0374_3487

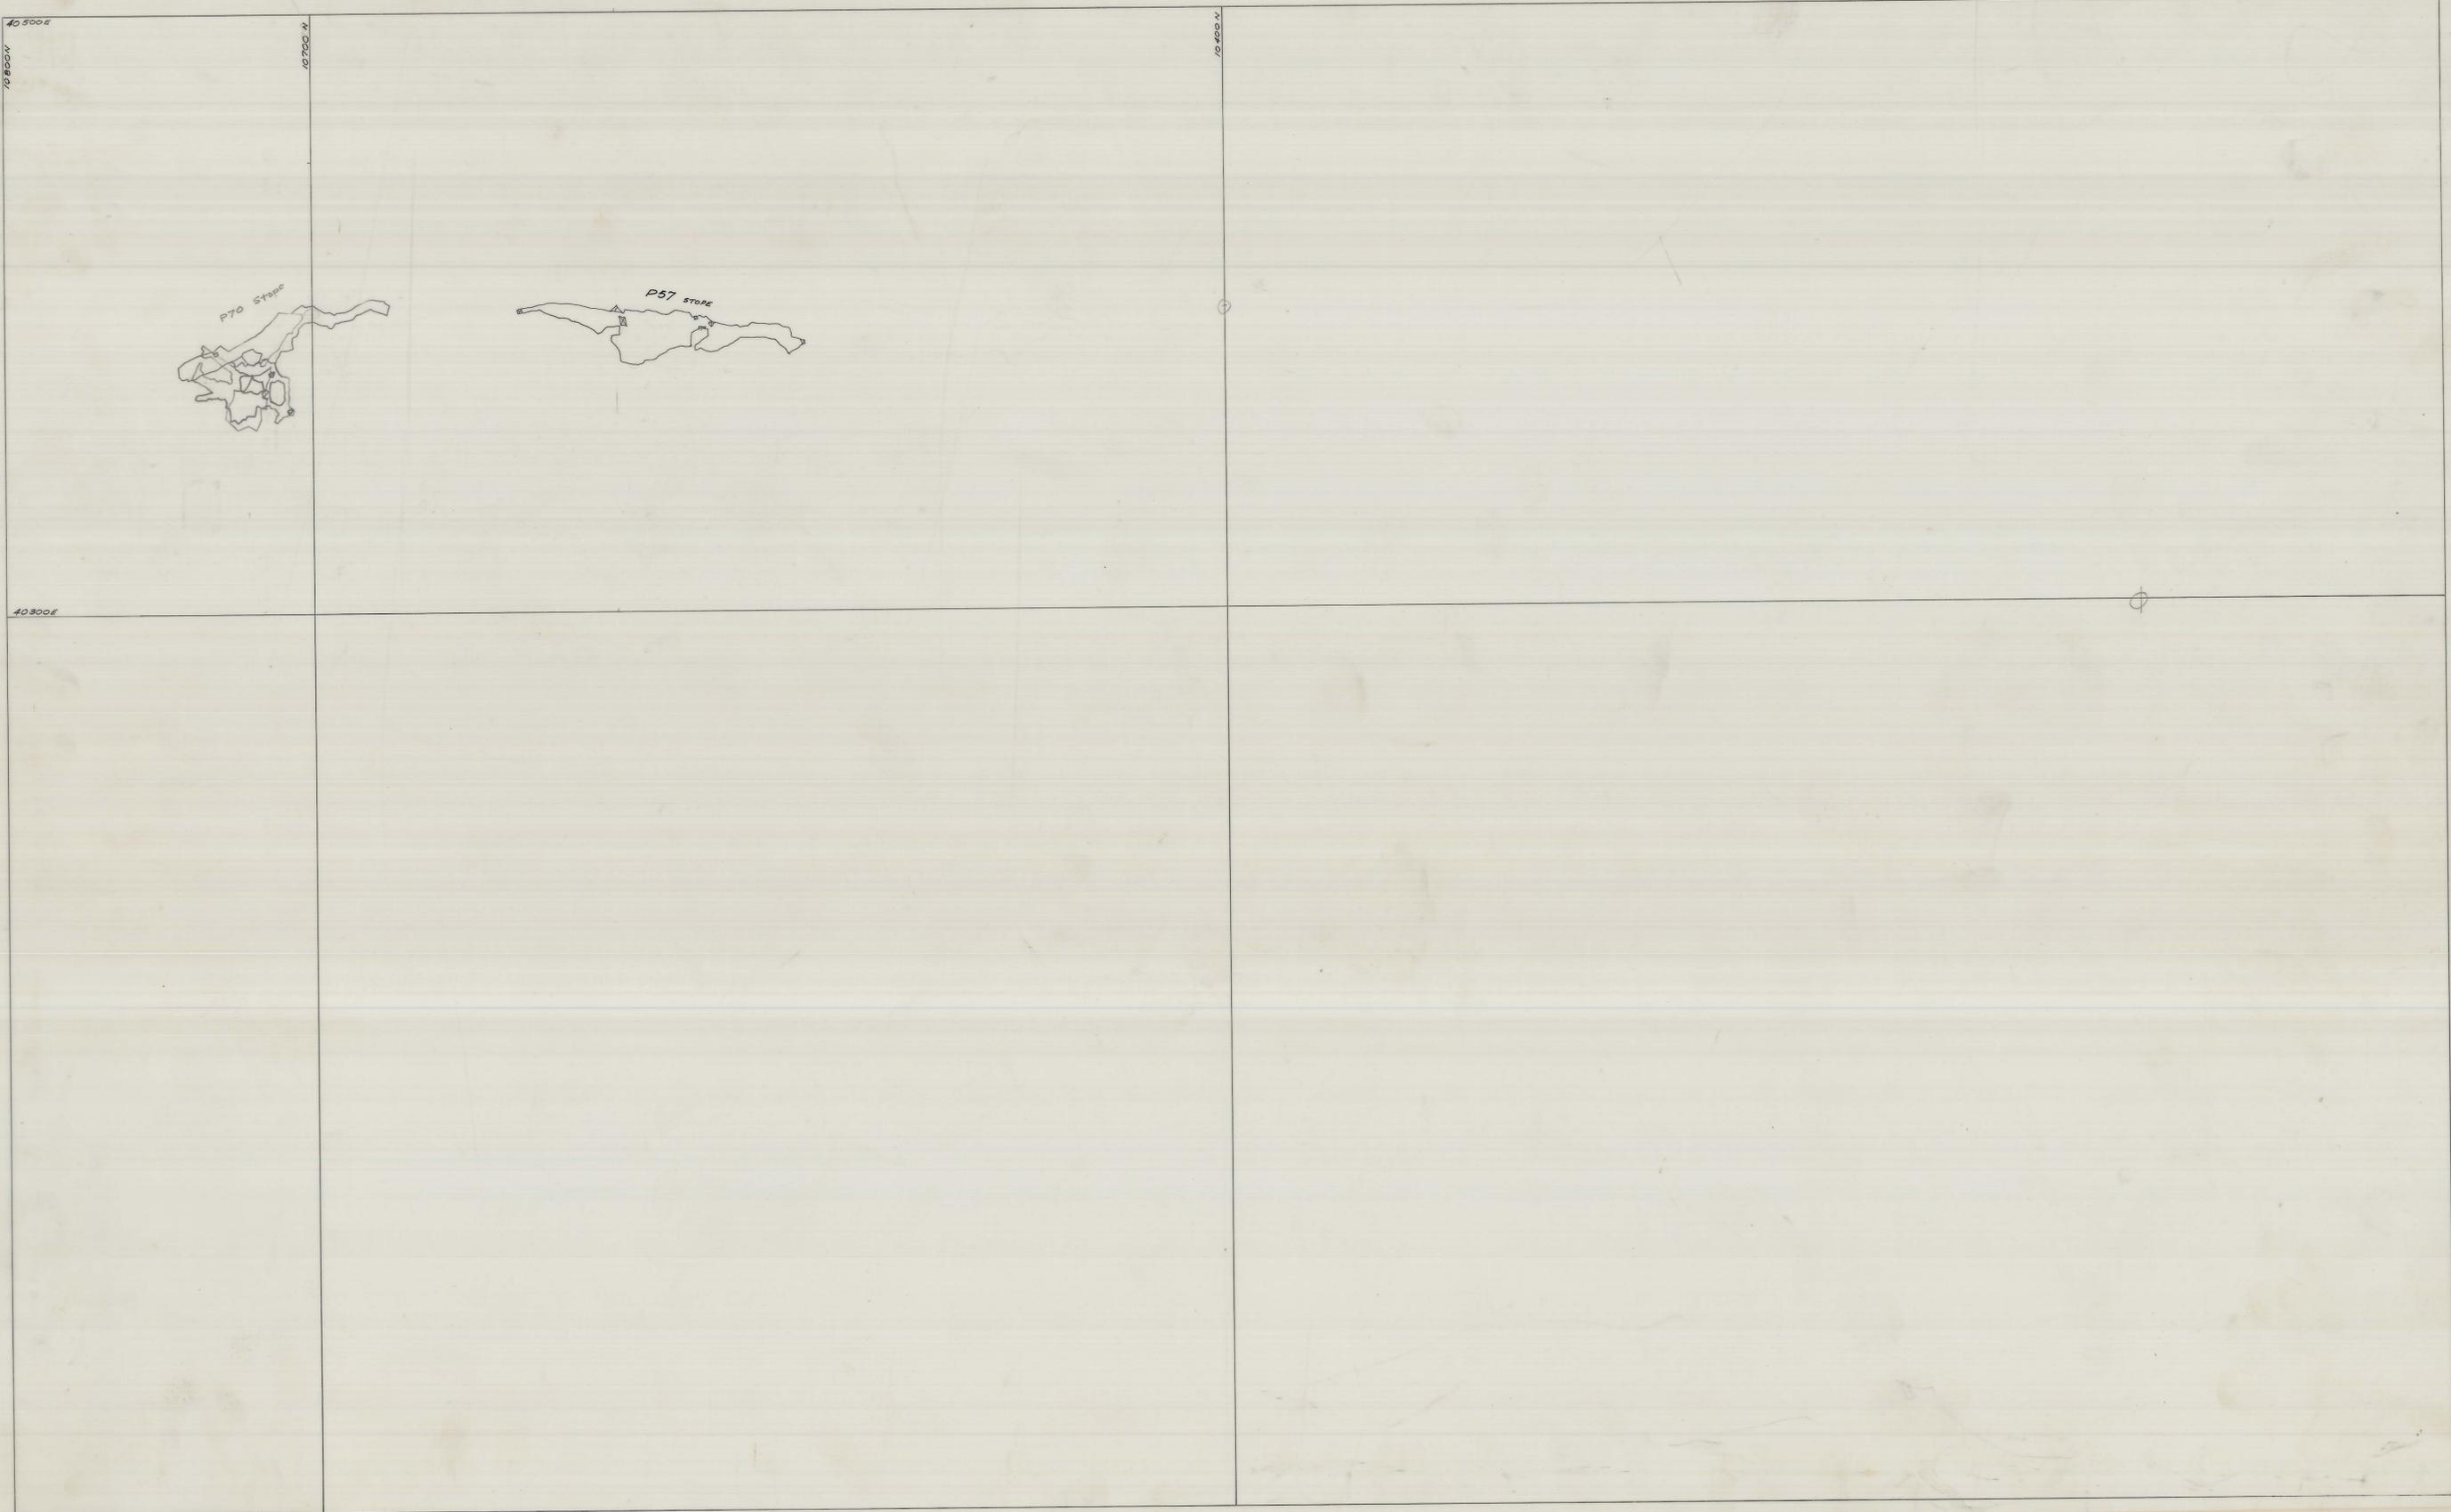

SCALE 1:1000	 north	LOCATION BOLD HEAD	 KING ISLAND SCHEELITE A DIVISION OF WARMAN INTERNATIONAL GRASSY KING ISLAND PLAN NUMBER 05BH05-100131
		SUBJECT AIRFLOW PLAN P70 & P57 stopes	