


5 cm



SCALE 1 : 1000

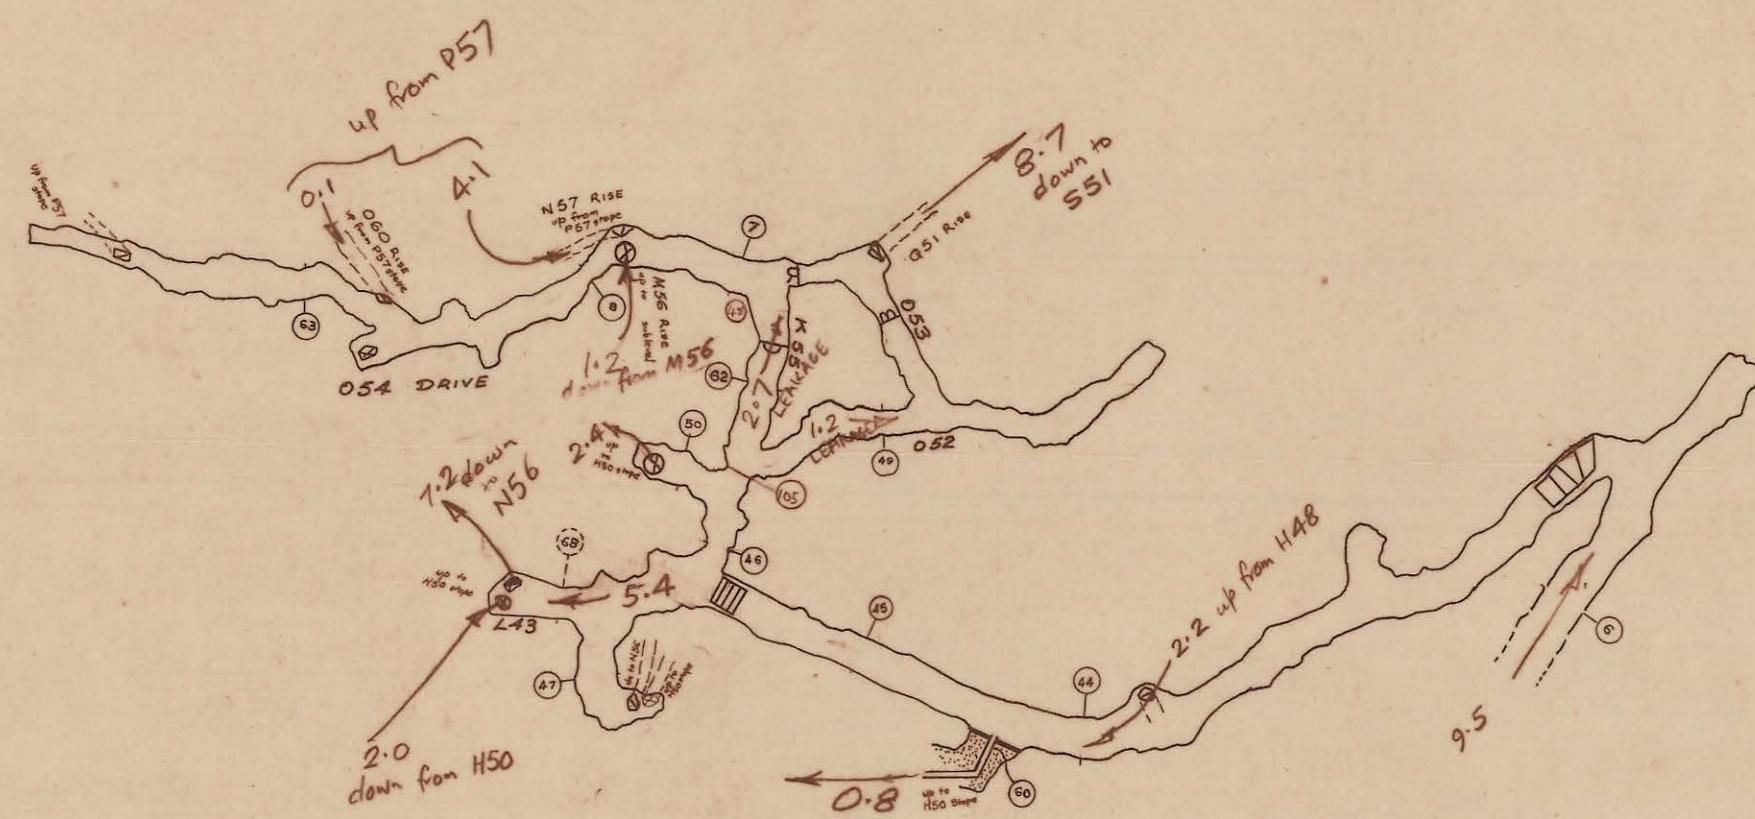

LOCATION

BOLD HEAD

SUBJECT

AIRFLOW PLAN  
A Lens Development

17/18 Nov 79

**KIS** KING ISLAND SCHEELITE  
A DIVISION OF HERMAN INTERNATIONAL

GRASSY KING ISLAND

PLAN NUMBER

05BH05-100A10