


05BH05-3037

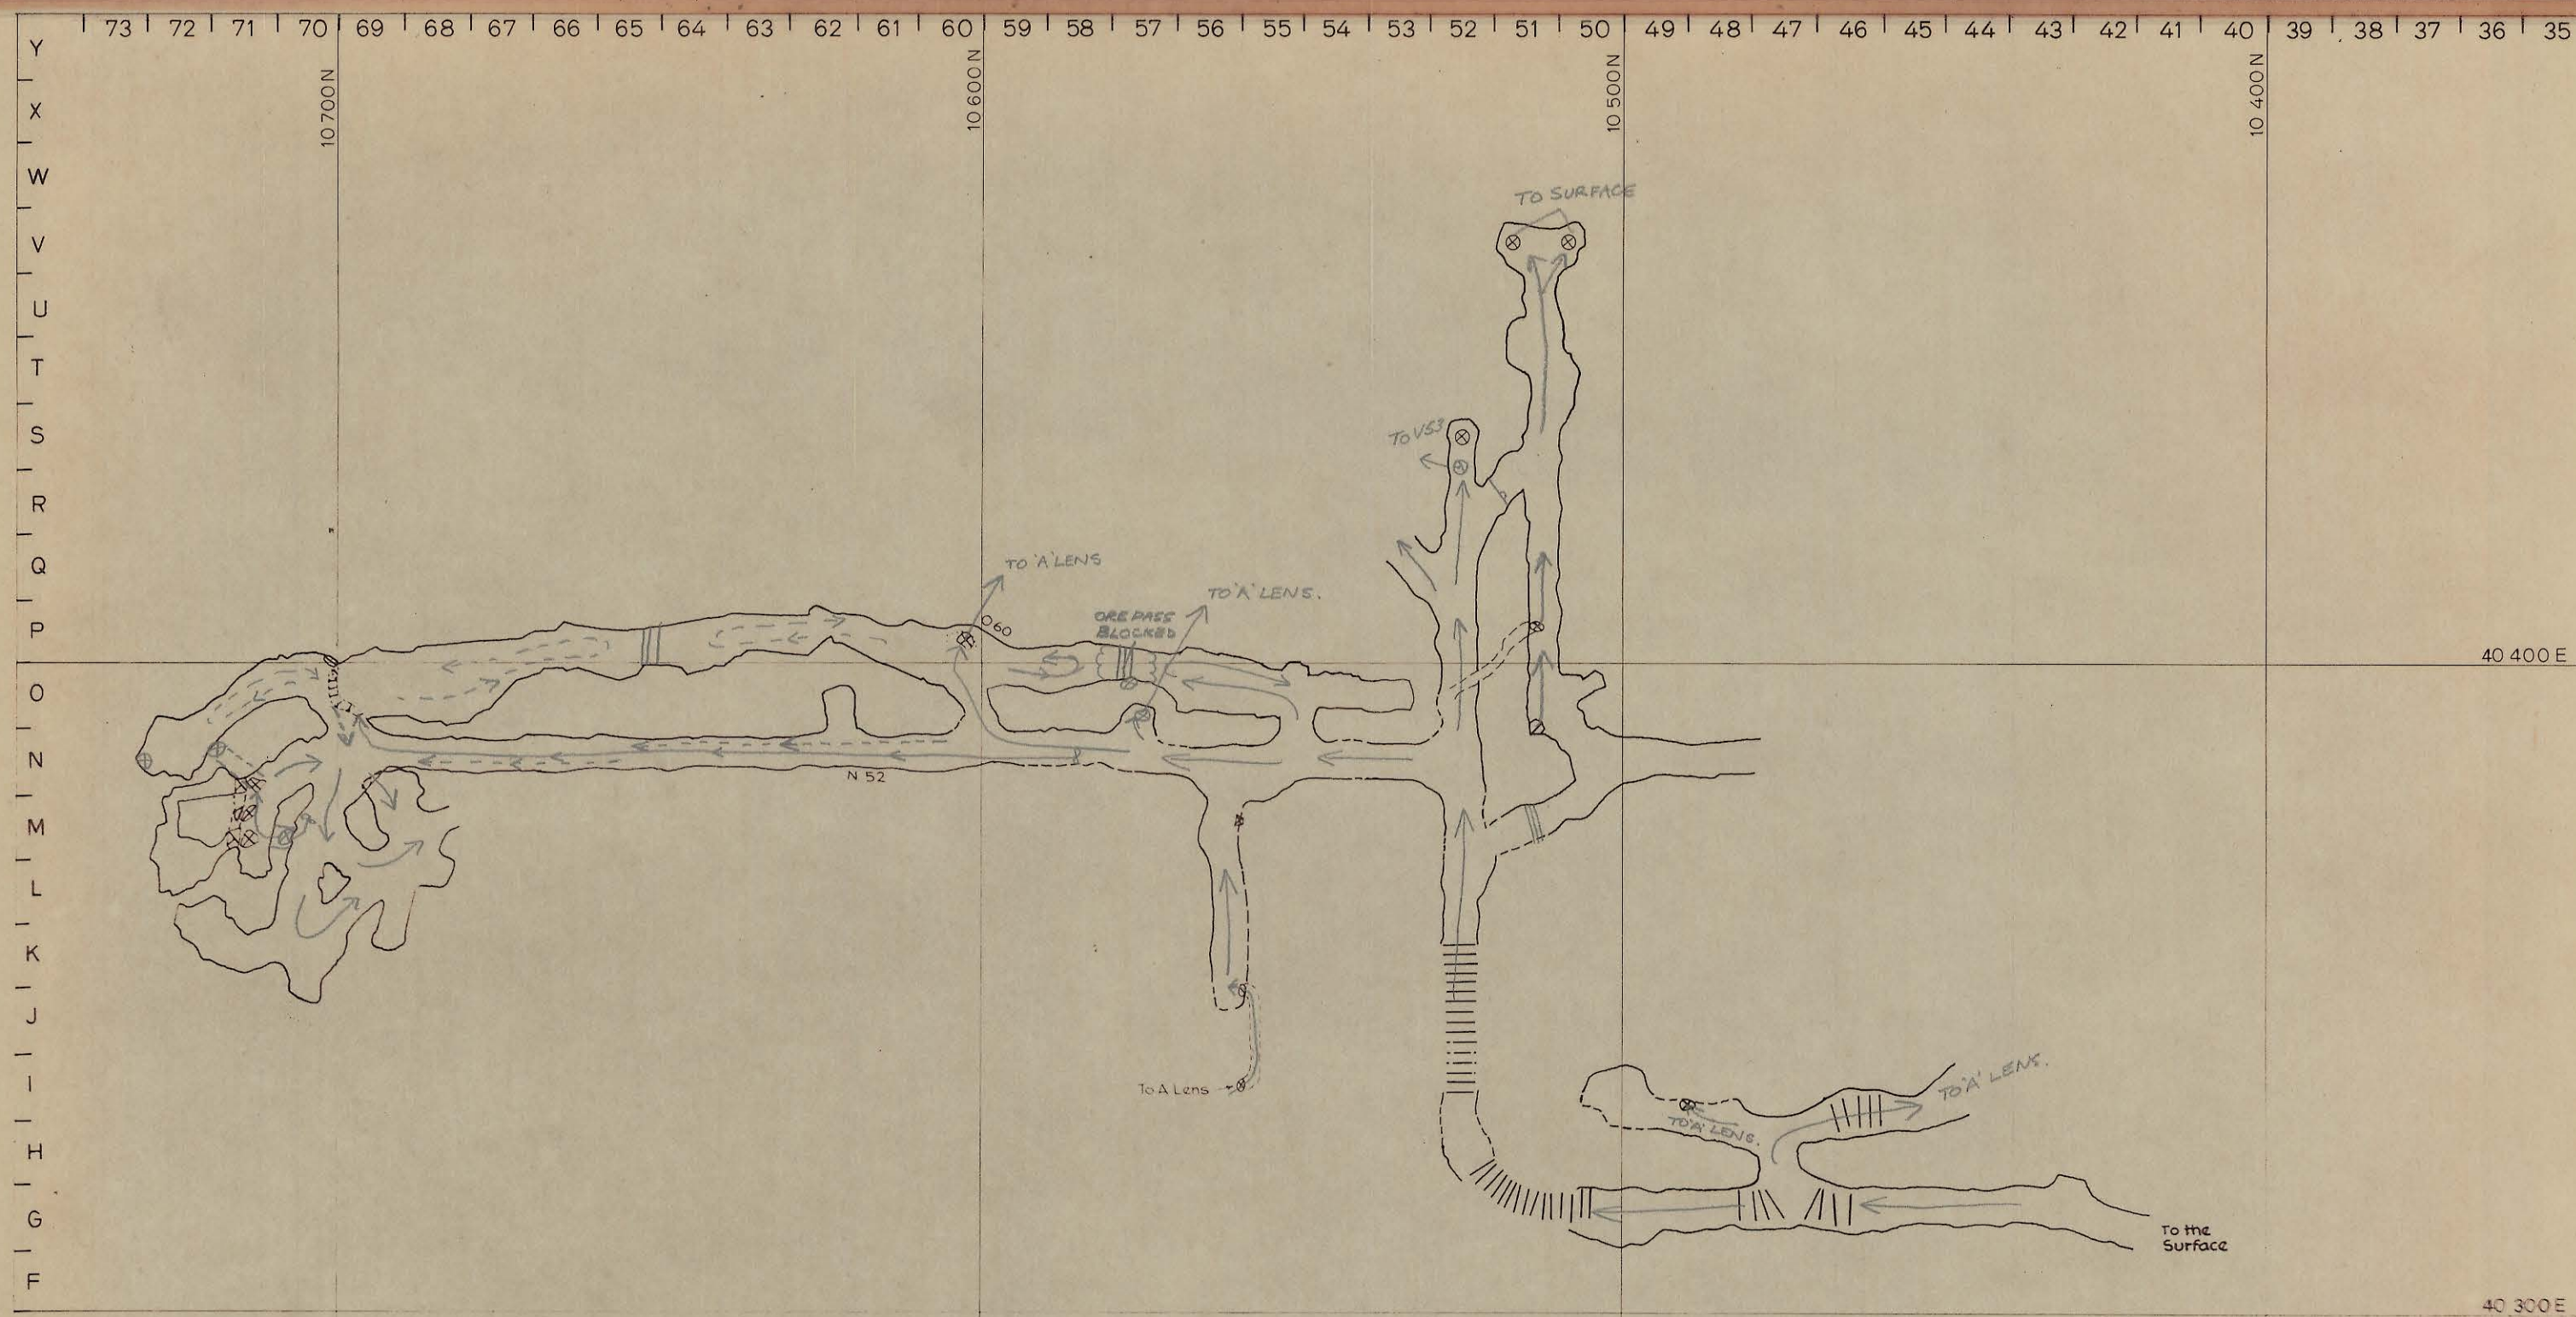

SCALE 1:1000

05BH05-3037

DATE
SURVEYED
DRAWN
TRACED
CHECKED

BOLD HEAD MINE VENTILATION.
UPPER B LENS
AIRFLOW SURVEY (SMOKE TUBES)

PERIOD ending 6-7-77 058405-3037