


0374_3520

5 cm

05BH05-3038

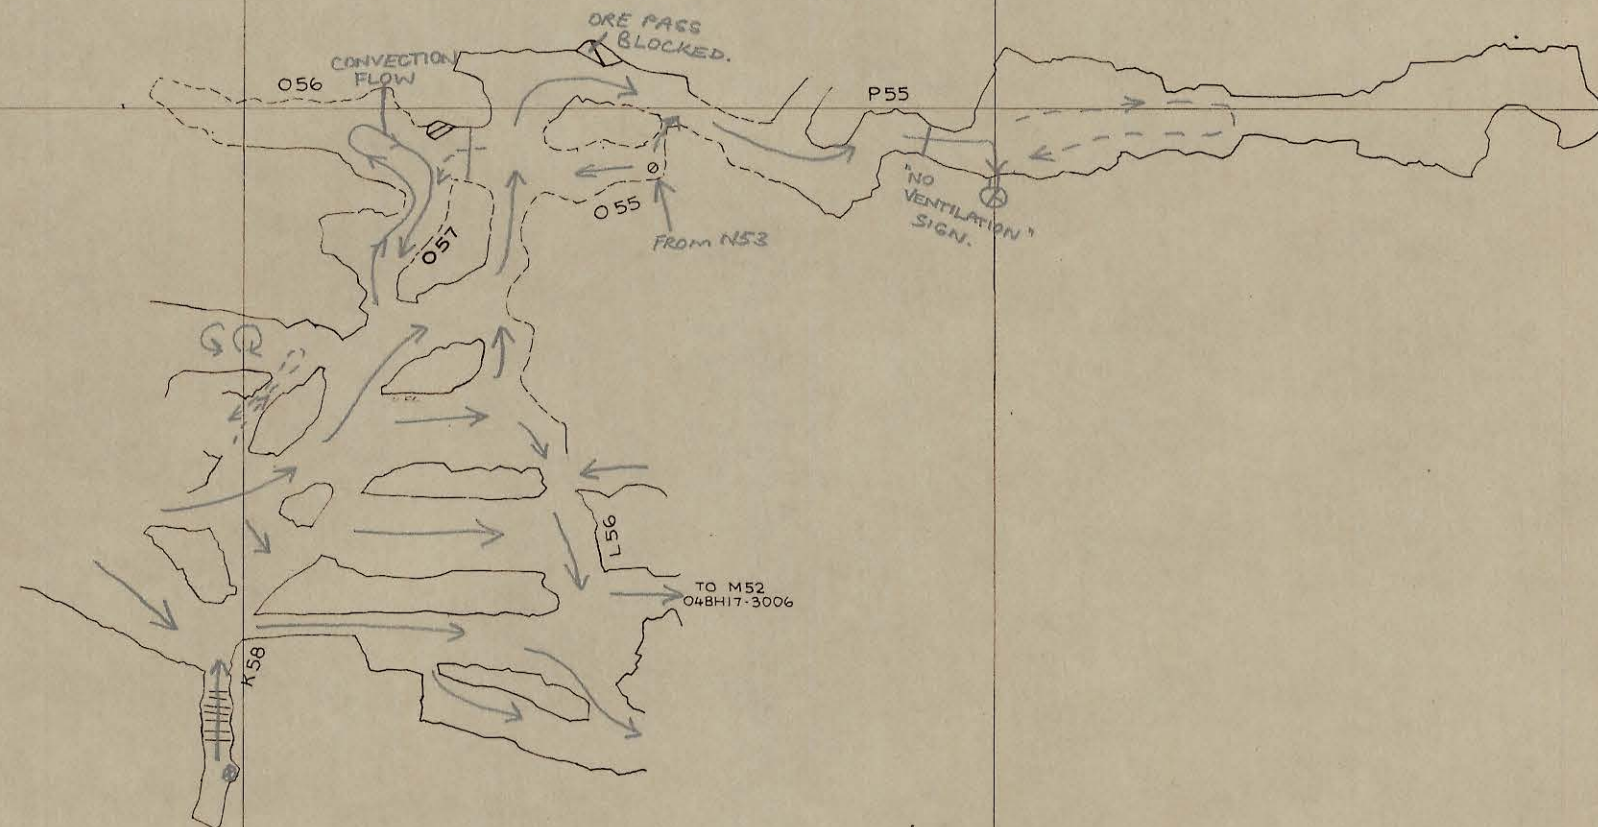

DATE
SURVEYED
DRAWN
TRACED
CHECKED

KING ISLAND SCHEELITE LTD.

SCALE 1: 1000

05BH05-3038

BOLD HEAD MINE VENTILATION.

MAIN B LENS 987 LEVEL

SMOKE TUBE SURVEY

6-7-77

05BH05-3038

PERIOD ending