


27 JUN 1981


0374_3523

05 DMO2- 3005


5 cm

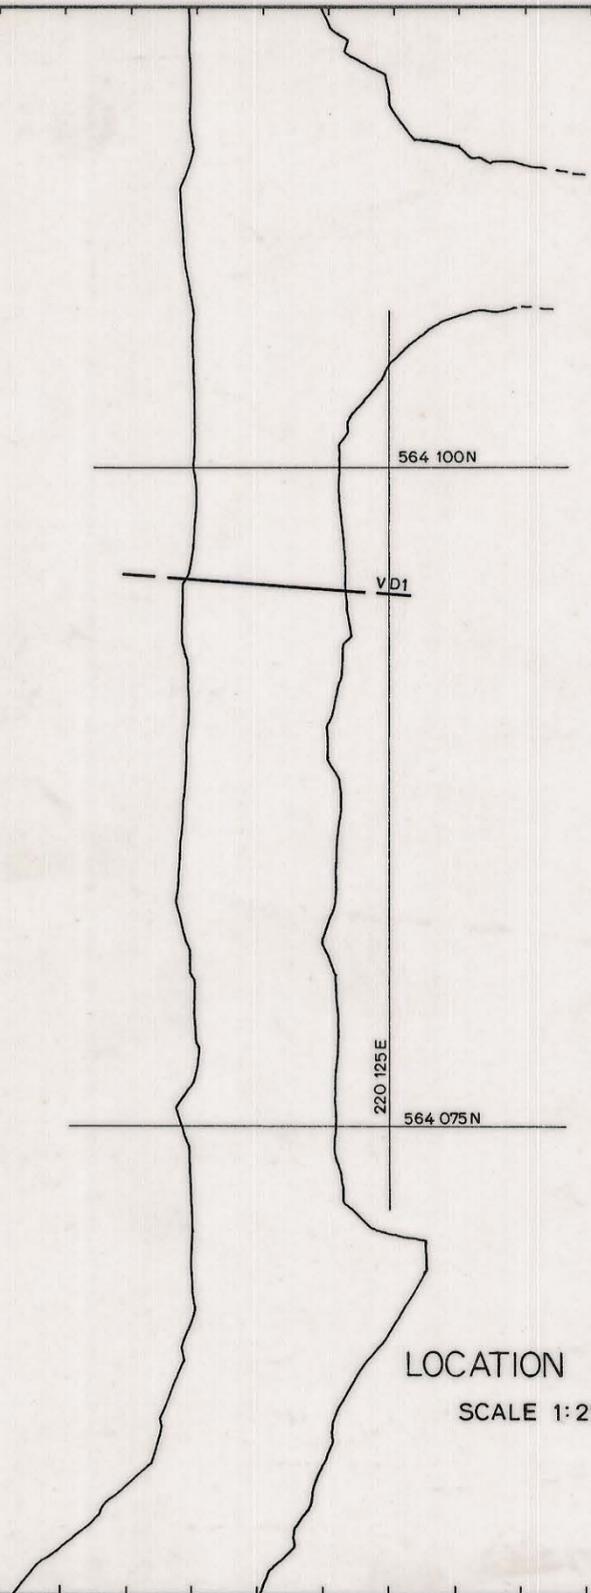

LOCATION PLAN
SCALE 1:250

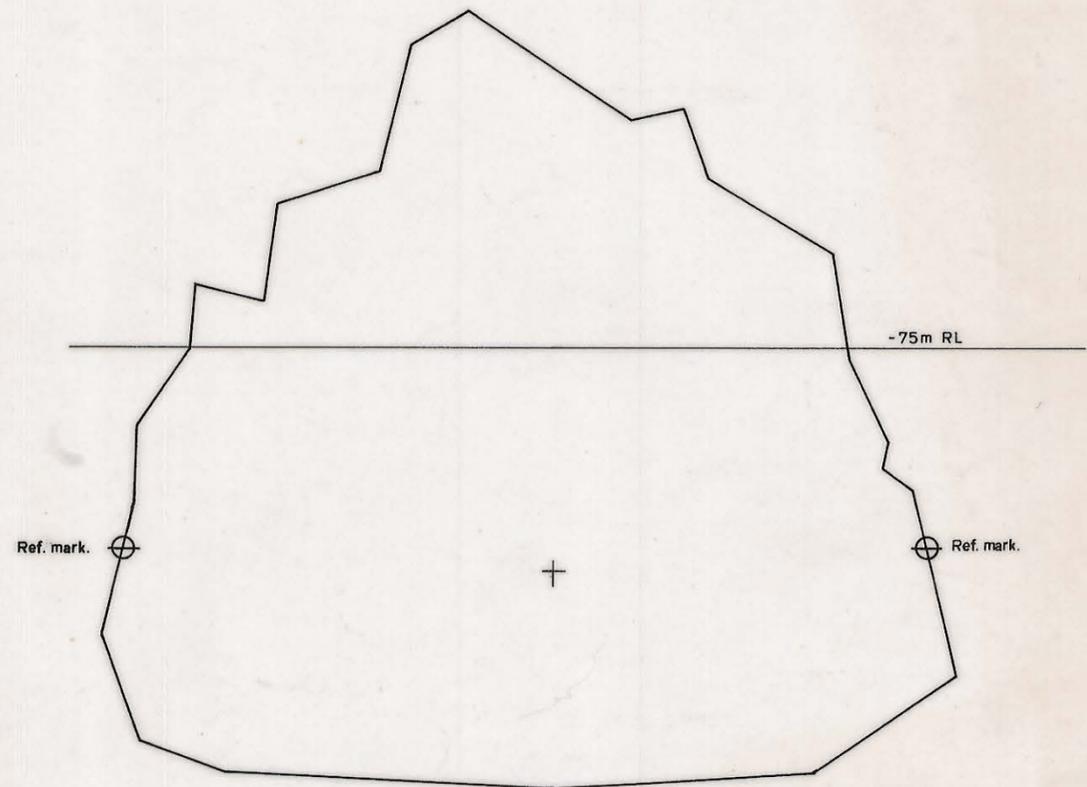

X- SECTION
SCALE 1:50

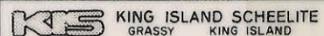REF PLAN	GEOLOGY			
	SURVEY			
	PLANNING			
	ROCK MEC.			
	GRADE CON.			
	DRAFTING			
T.S.S.			DRAWING NUMBER 05 DM 02 - 3005	

VENT DOOR POSITION 1