




Adjoins 1-22-54

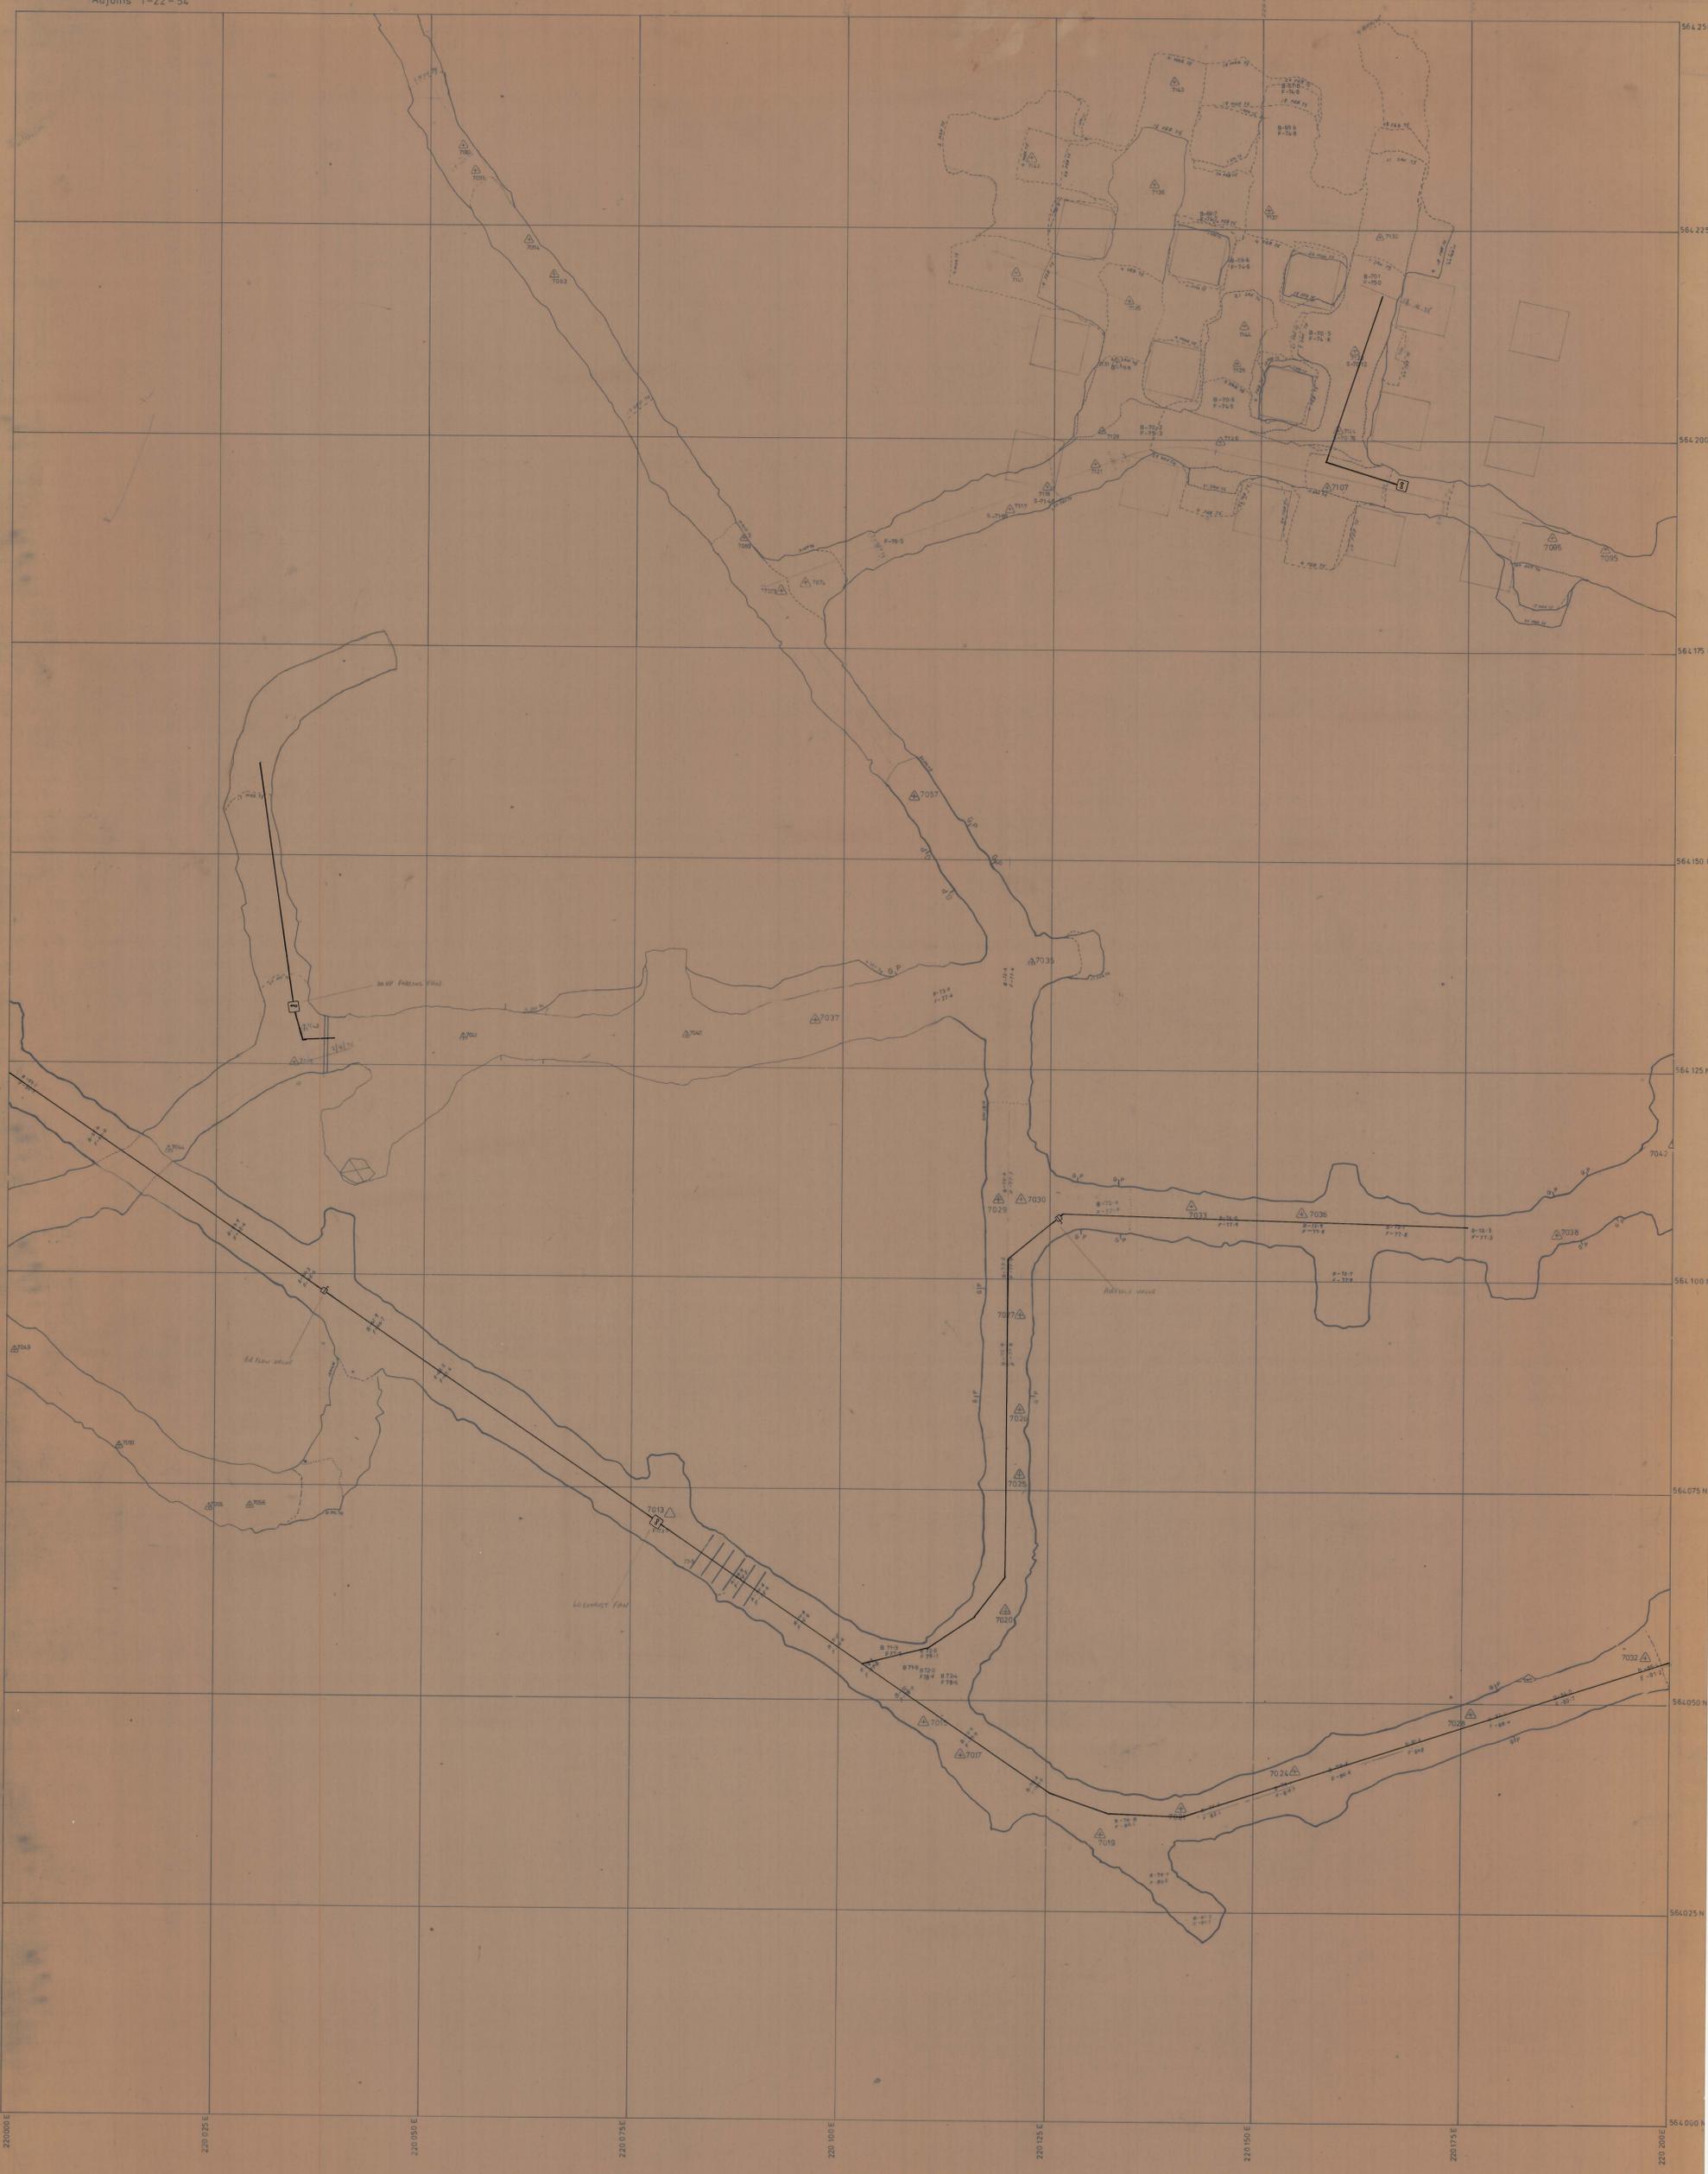

KING ISLAND SCHEELITE LTD.
DOLPHIN MINE

SCALE 1:250

OSDM05-0004
1-22-54

REVISED 2-4-75