



5 cm

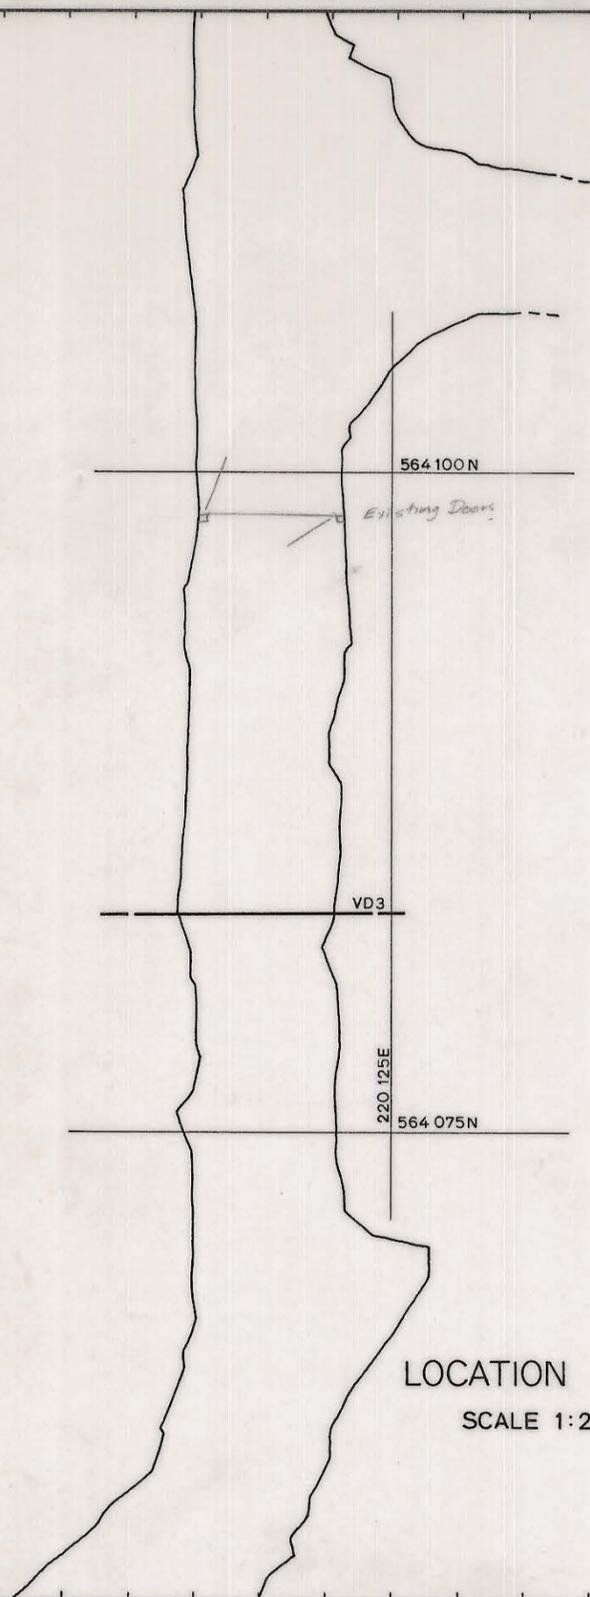

LOCATION PLAN
SCALE 1:250

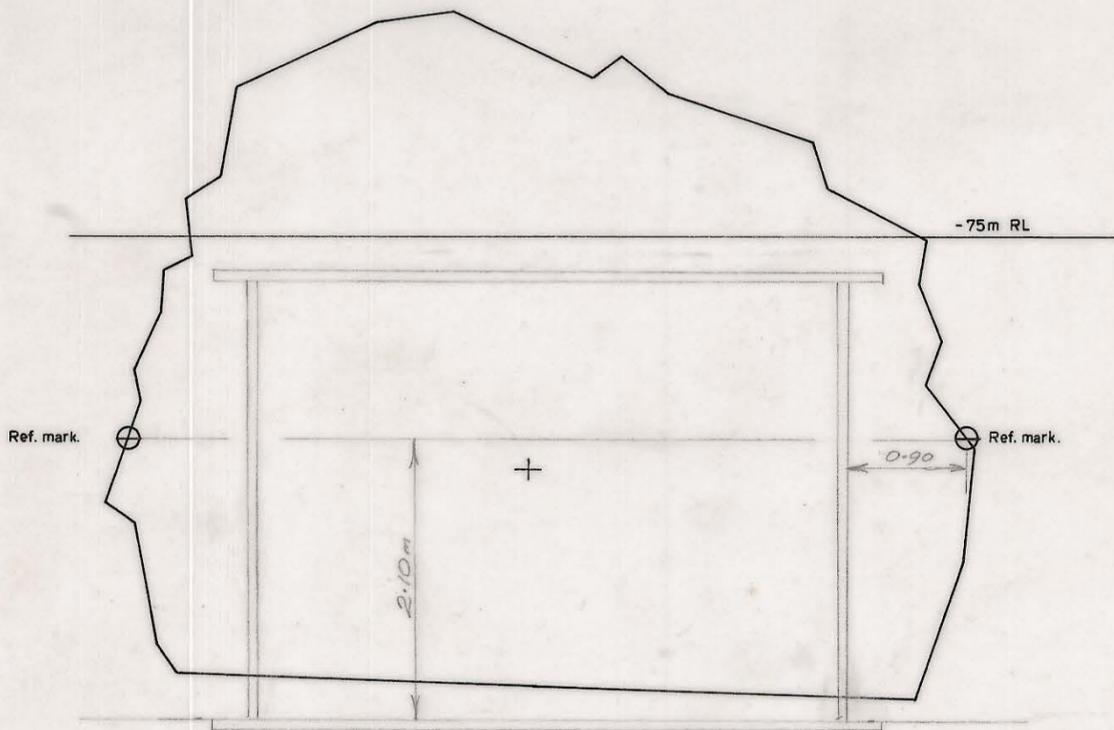

X-SECTION
Looking N
SCALE 1:50

REF PLAN

GEOLOGY

SURVEY

PLANNING

ROCK MEC.

GRADE CON.

DRAFTING

T.S.S.

KIS KING ISLAND SCHEELITE
GRASSY KING ISLAND

VENT DOOR POSITION 3

DRAWING NUMBER 05 DM 02 - 3004