


OSDM05-1001

11-22-48
DOLPHIN POWER
INSTALLATIONS

0374_3530

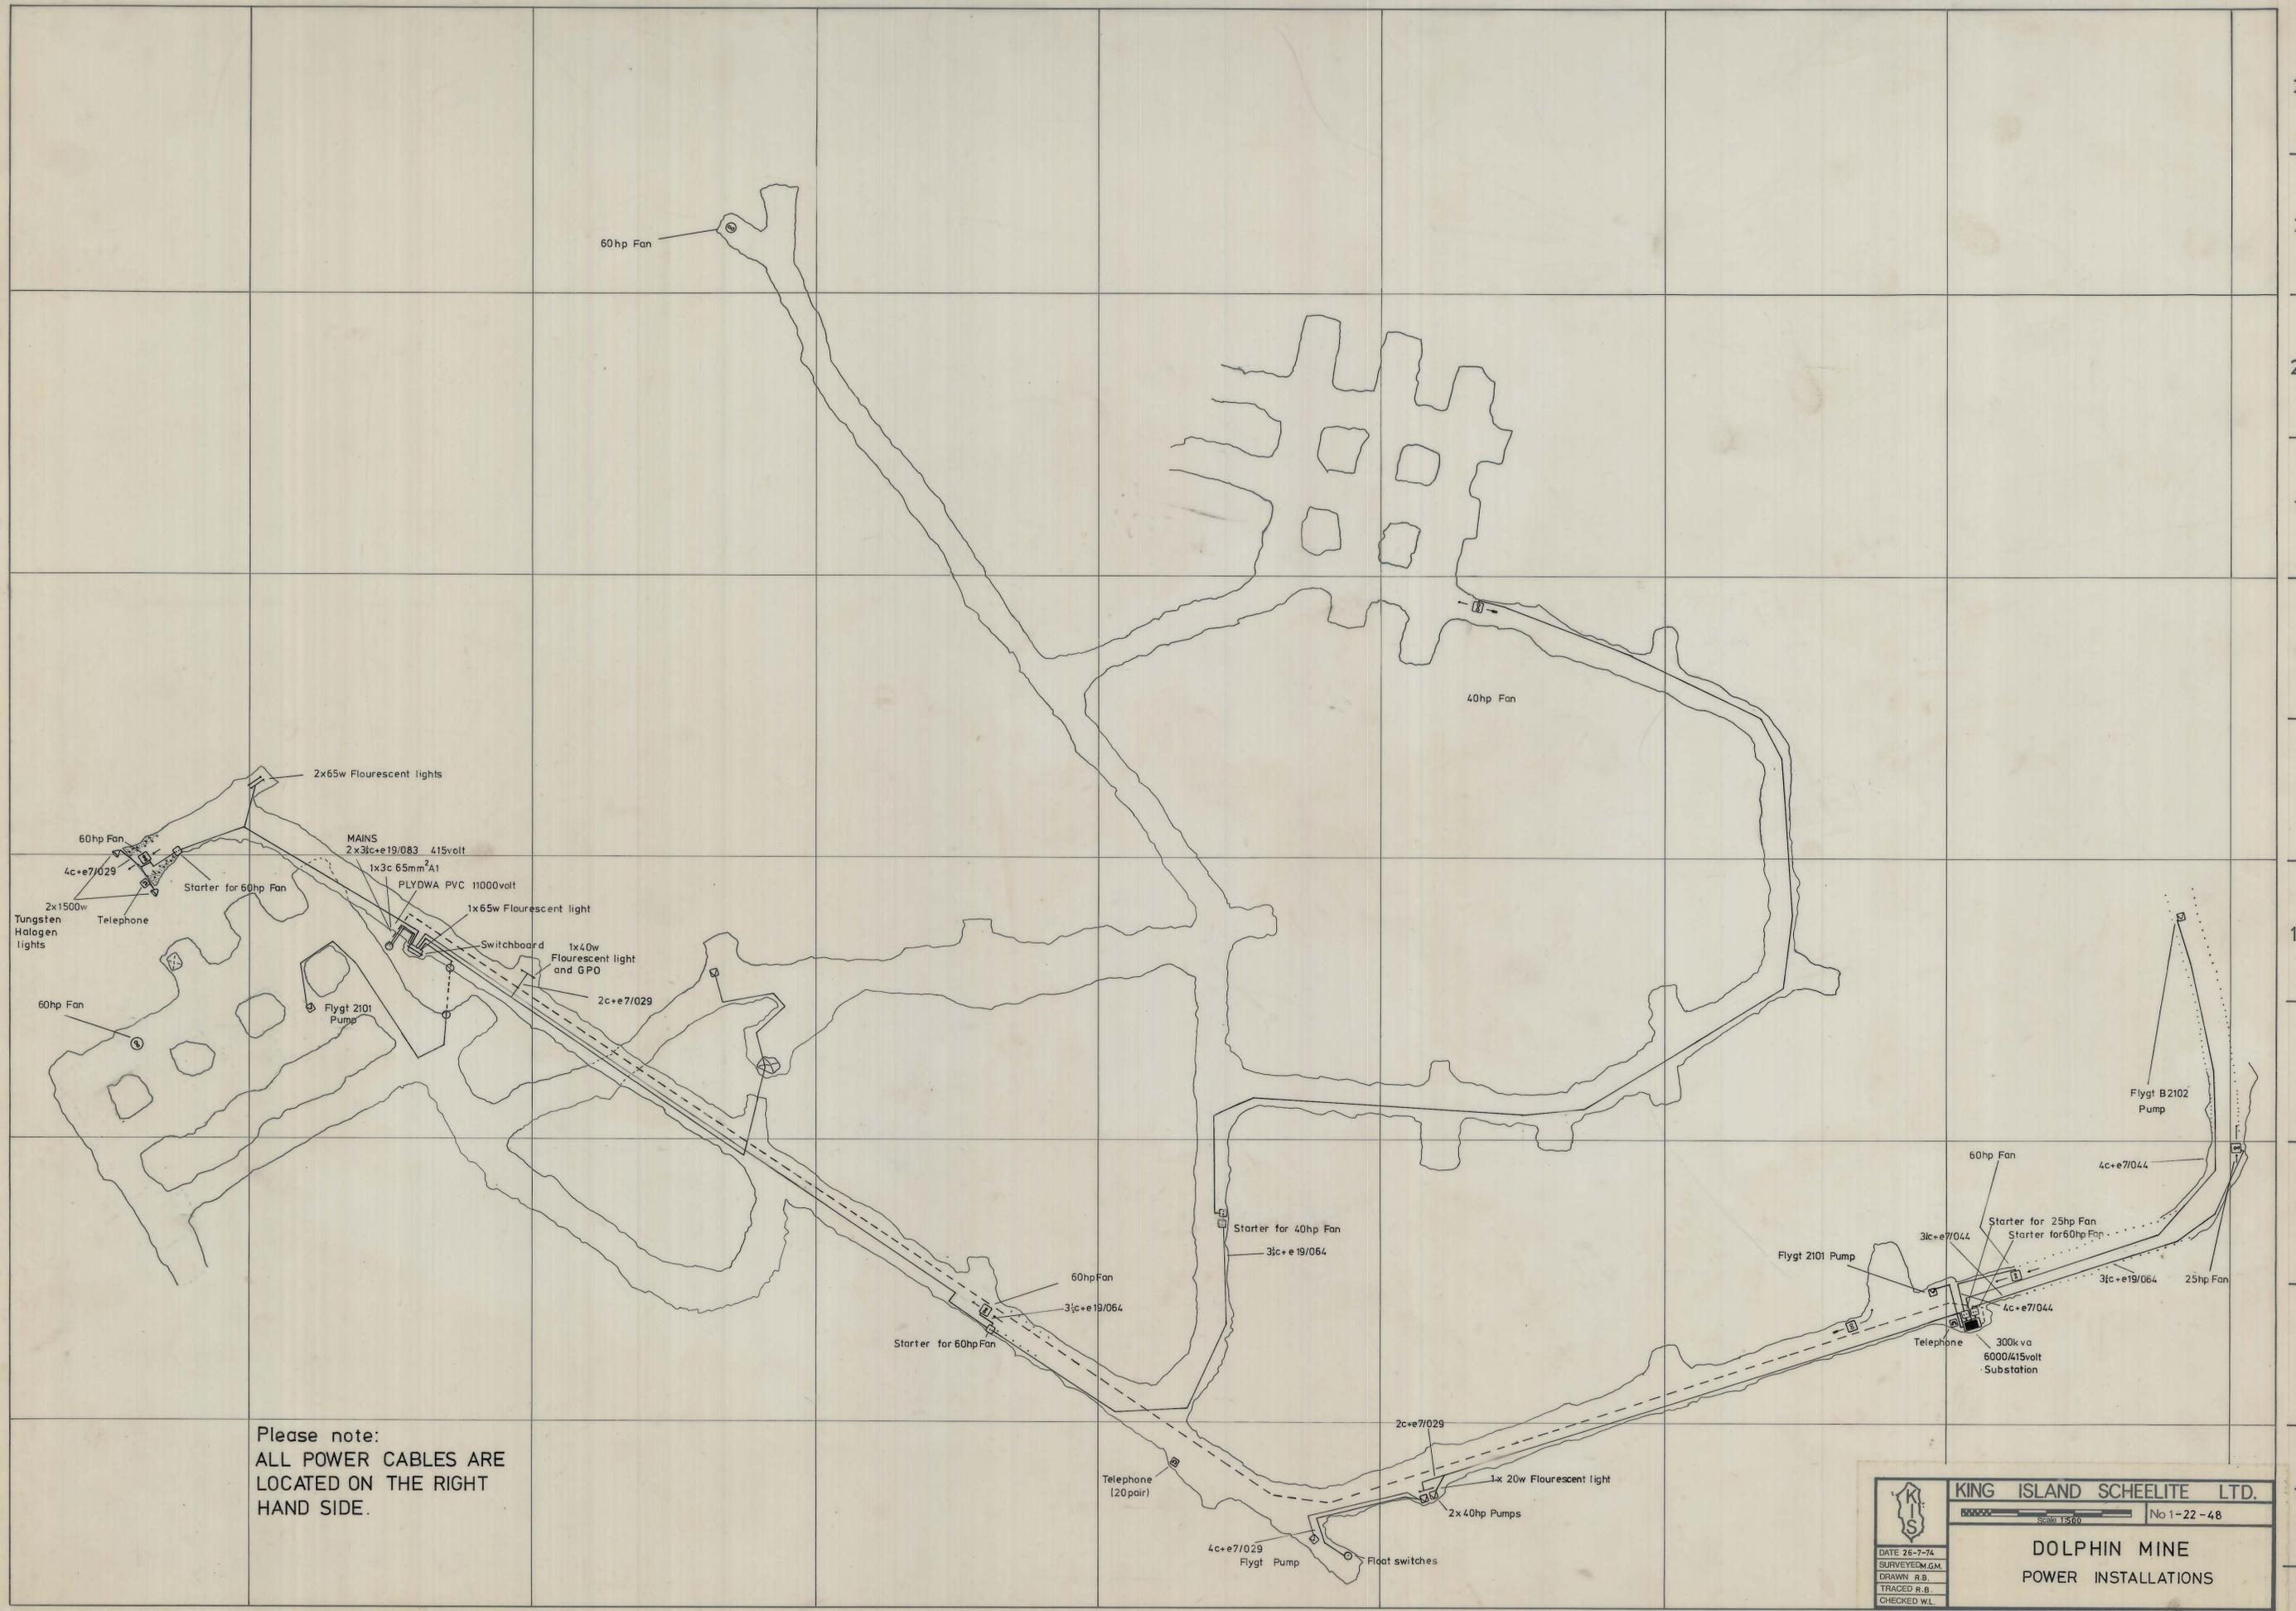

Please note:
ALL POWER CABLES ARE
LOCATED ON THE RIGHT
HAND SIDE.

	KING ISLAND SCHEELITE LTD.	
	No 1-22-48	
	DOLPHIN MINE	
	POWER INSTALLATIONS	
<small> DATE 26-7-74 SURVEYED M.G.M. DRAWN R.B. TRACED R.B. CHECKED W.L. </small>		

D | E | F | G | H | I | J | K | L | M | N | O | P | Q | R | S