
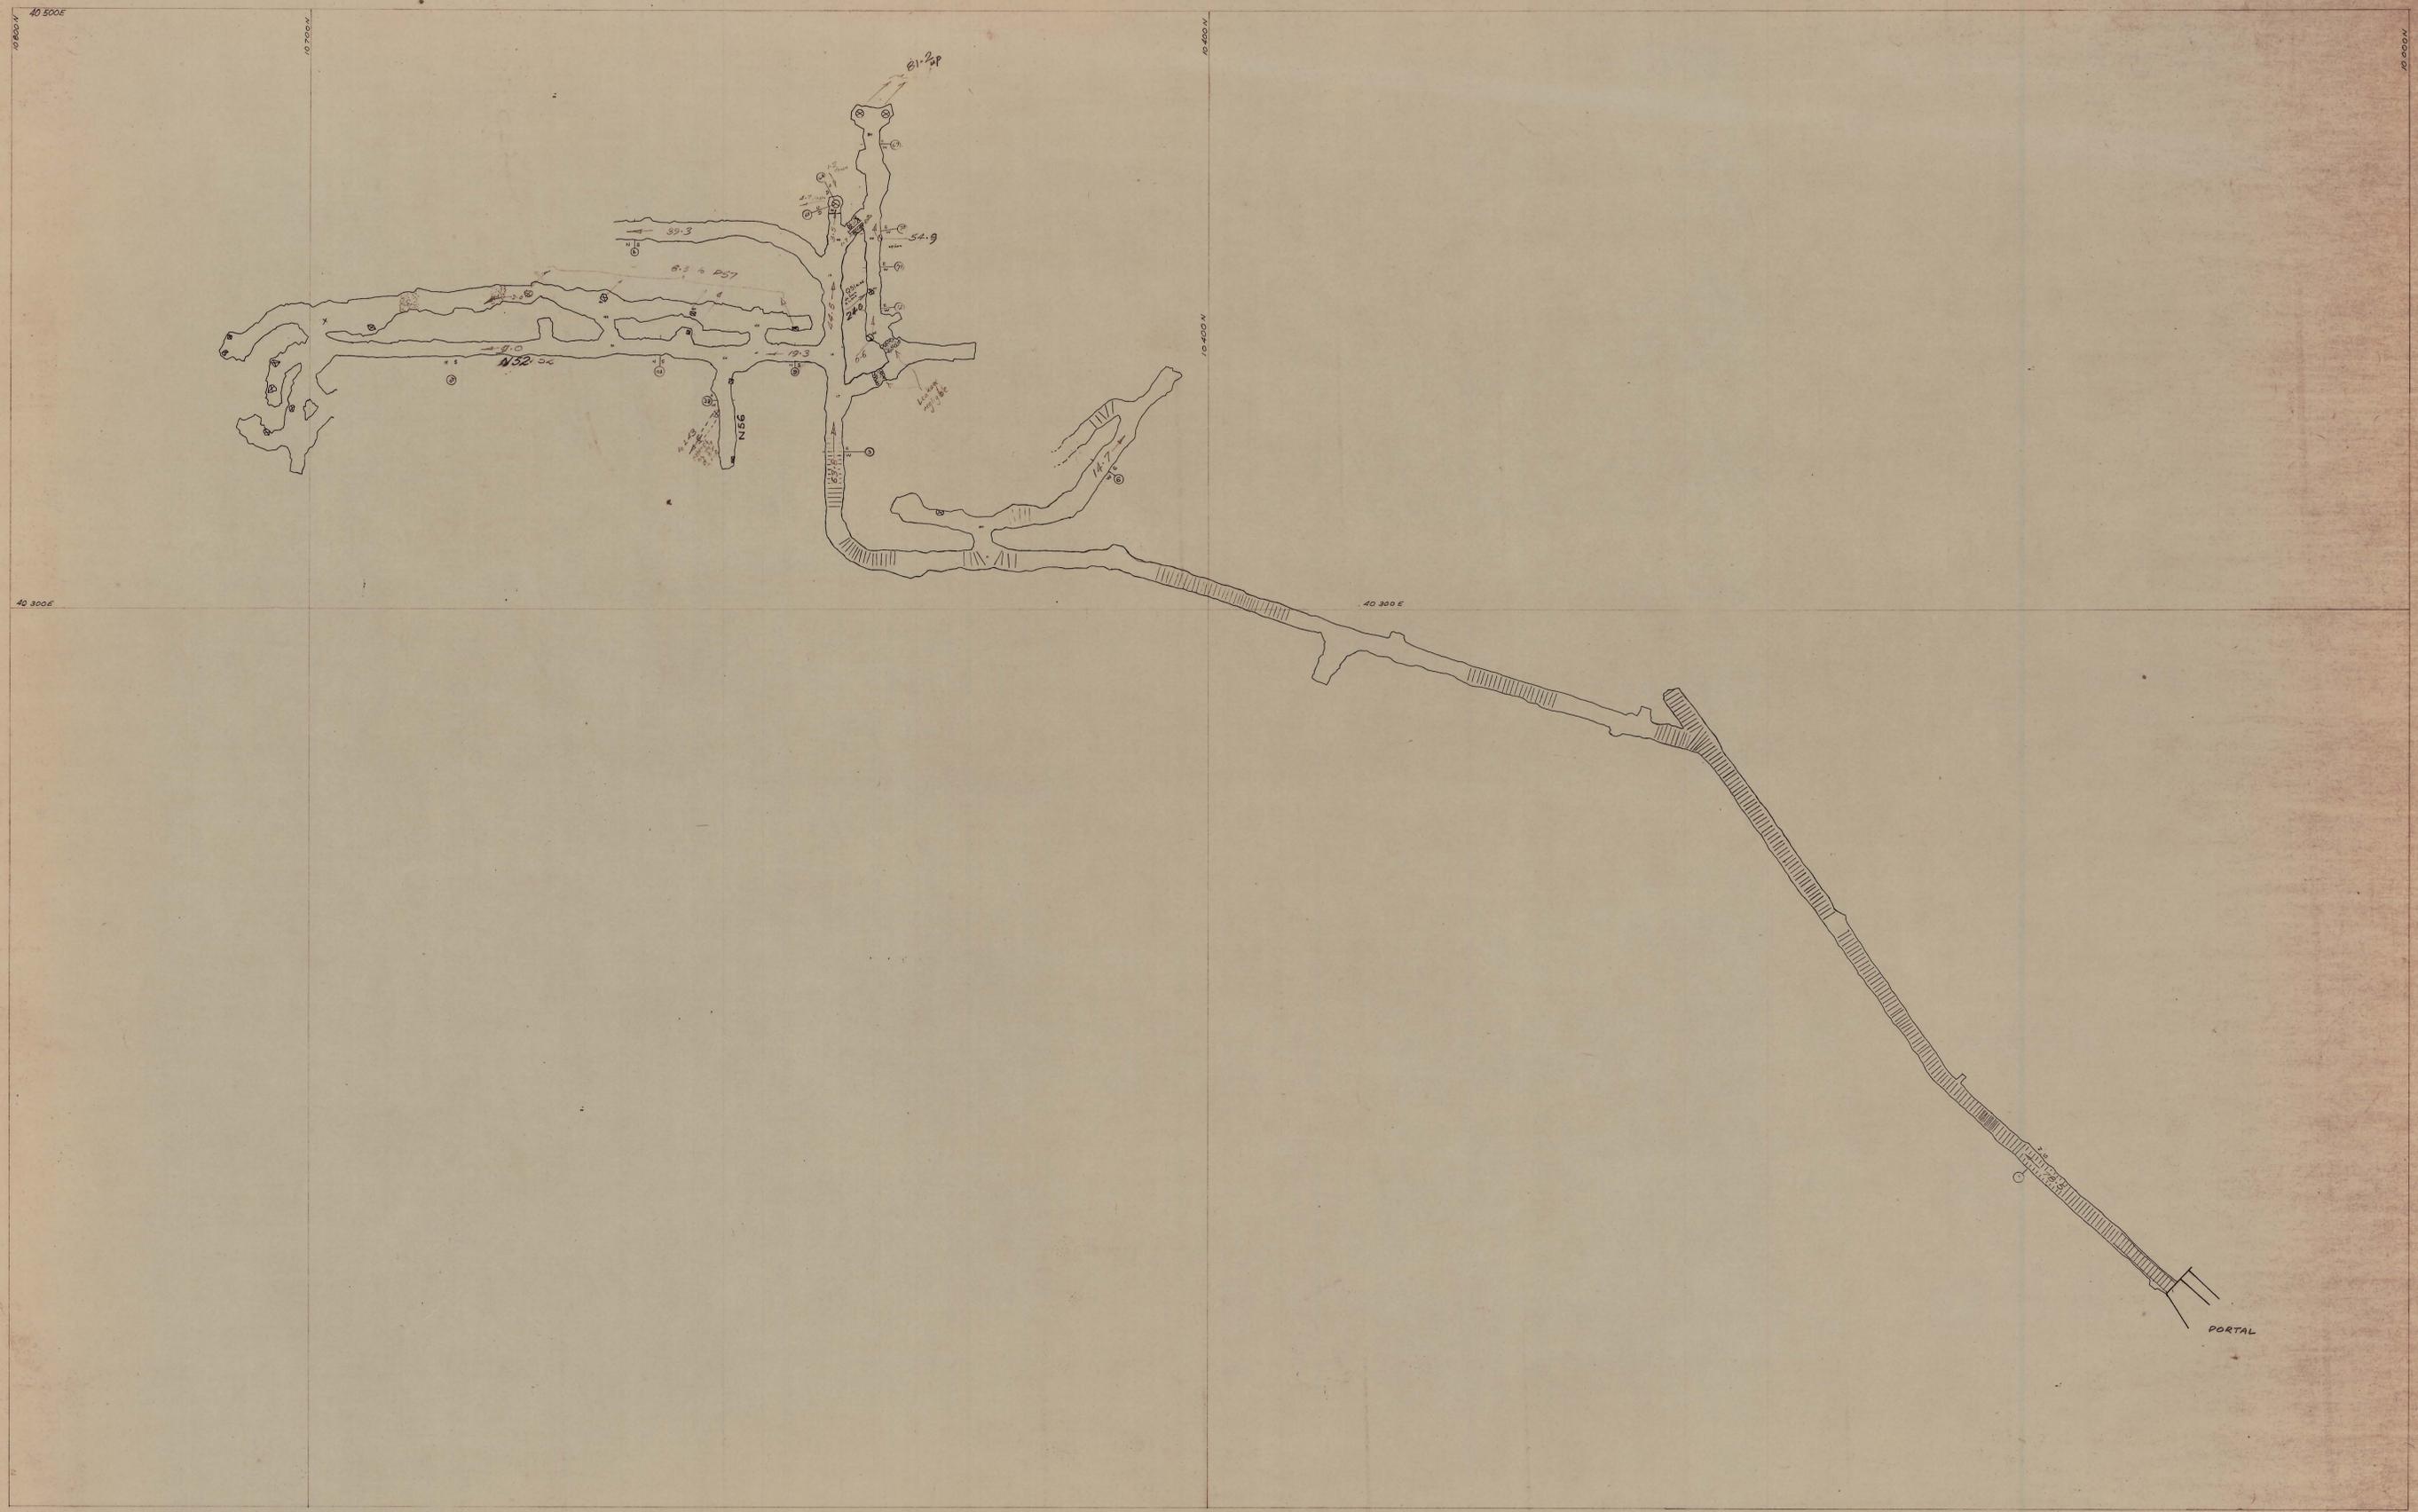


05BH05-100301

0374\_3537

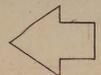

SCALE 1:1000	LOCATION BOLD HEAD MINE	 <b>KING ISLAND SCHEELITE</b> <small>A DIVISION OF WARMAN INTERNATIONAL</small> GRASSY KING ISLAND
 NORTH	SUBJECT <b>AIRFLOW</b> Portal to Cribroom FEB 1979	PLAN NUMBER <b>05BH05 - 100301</b>