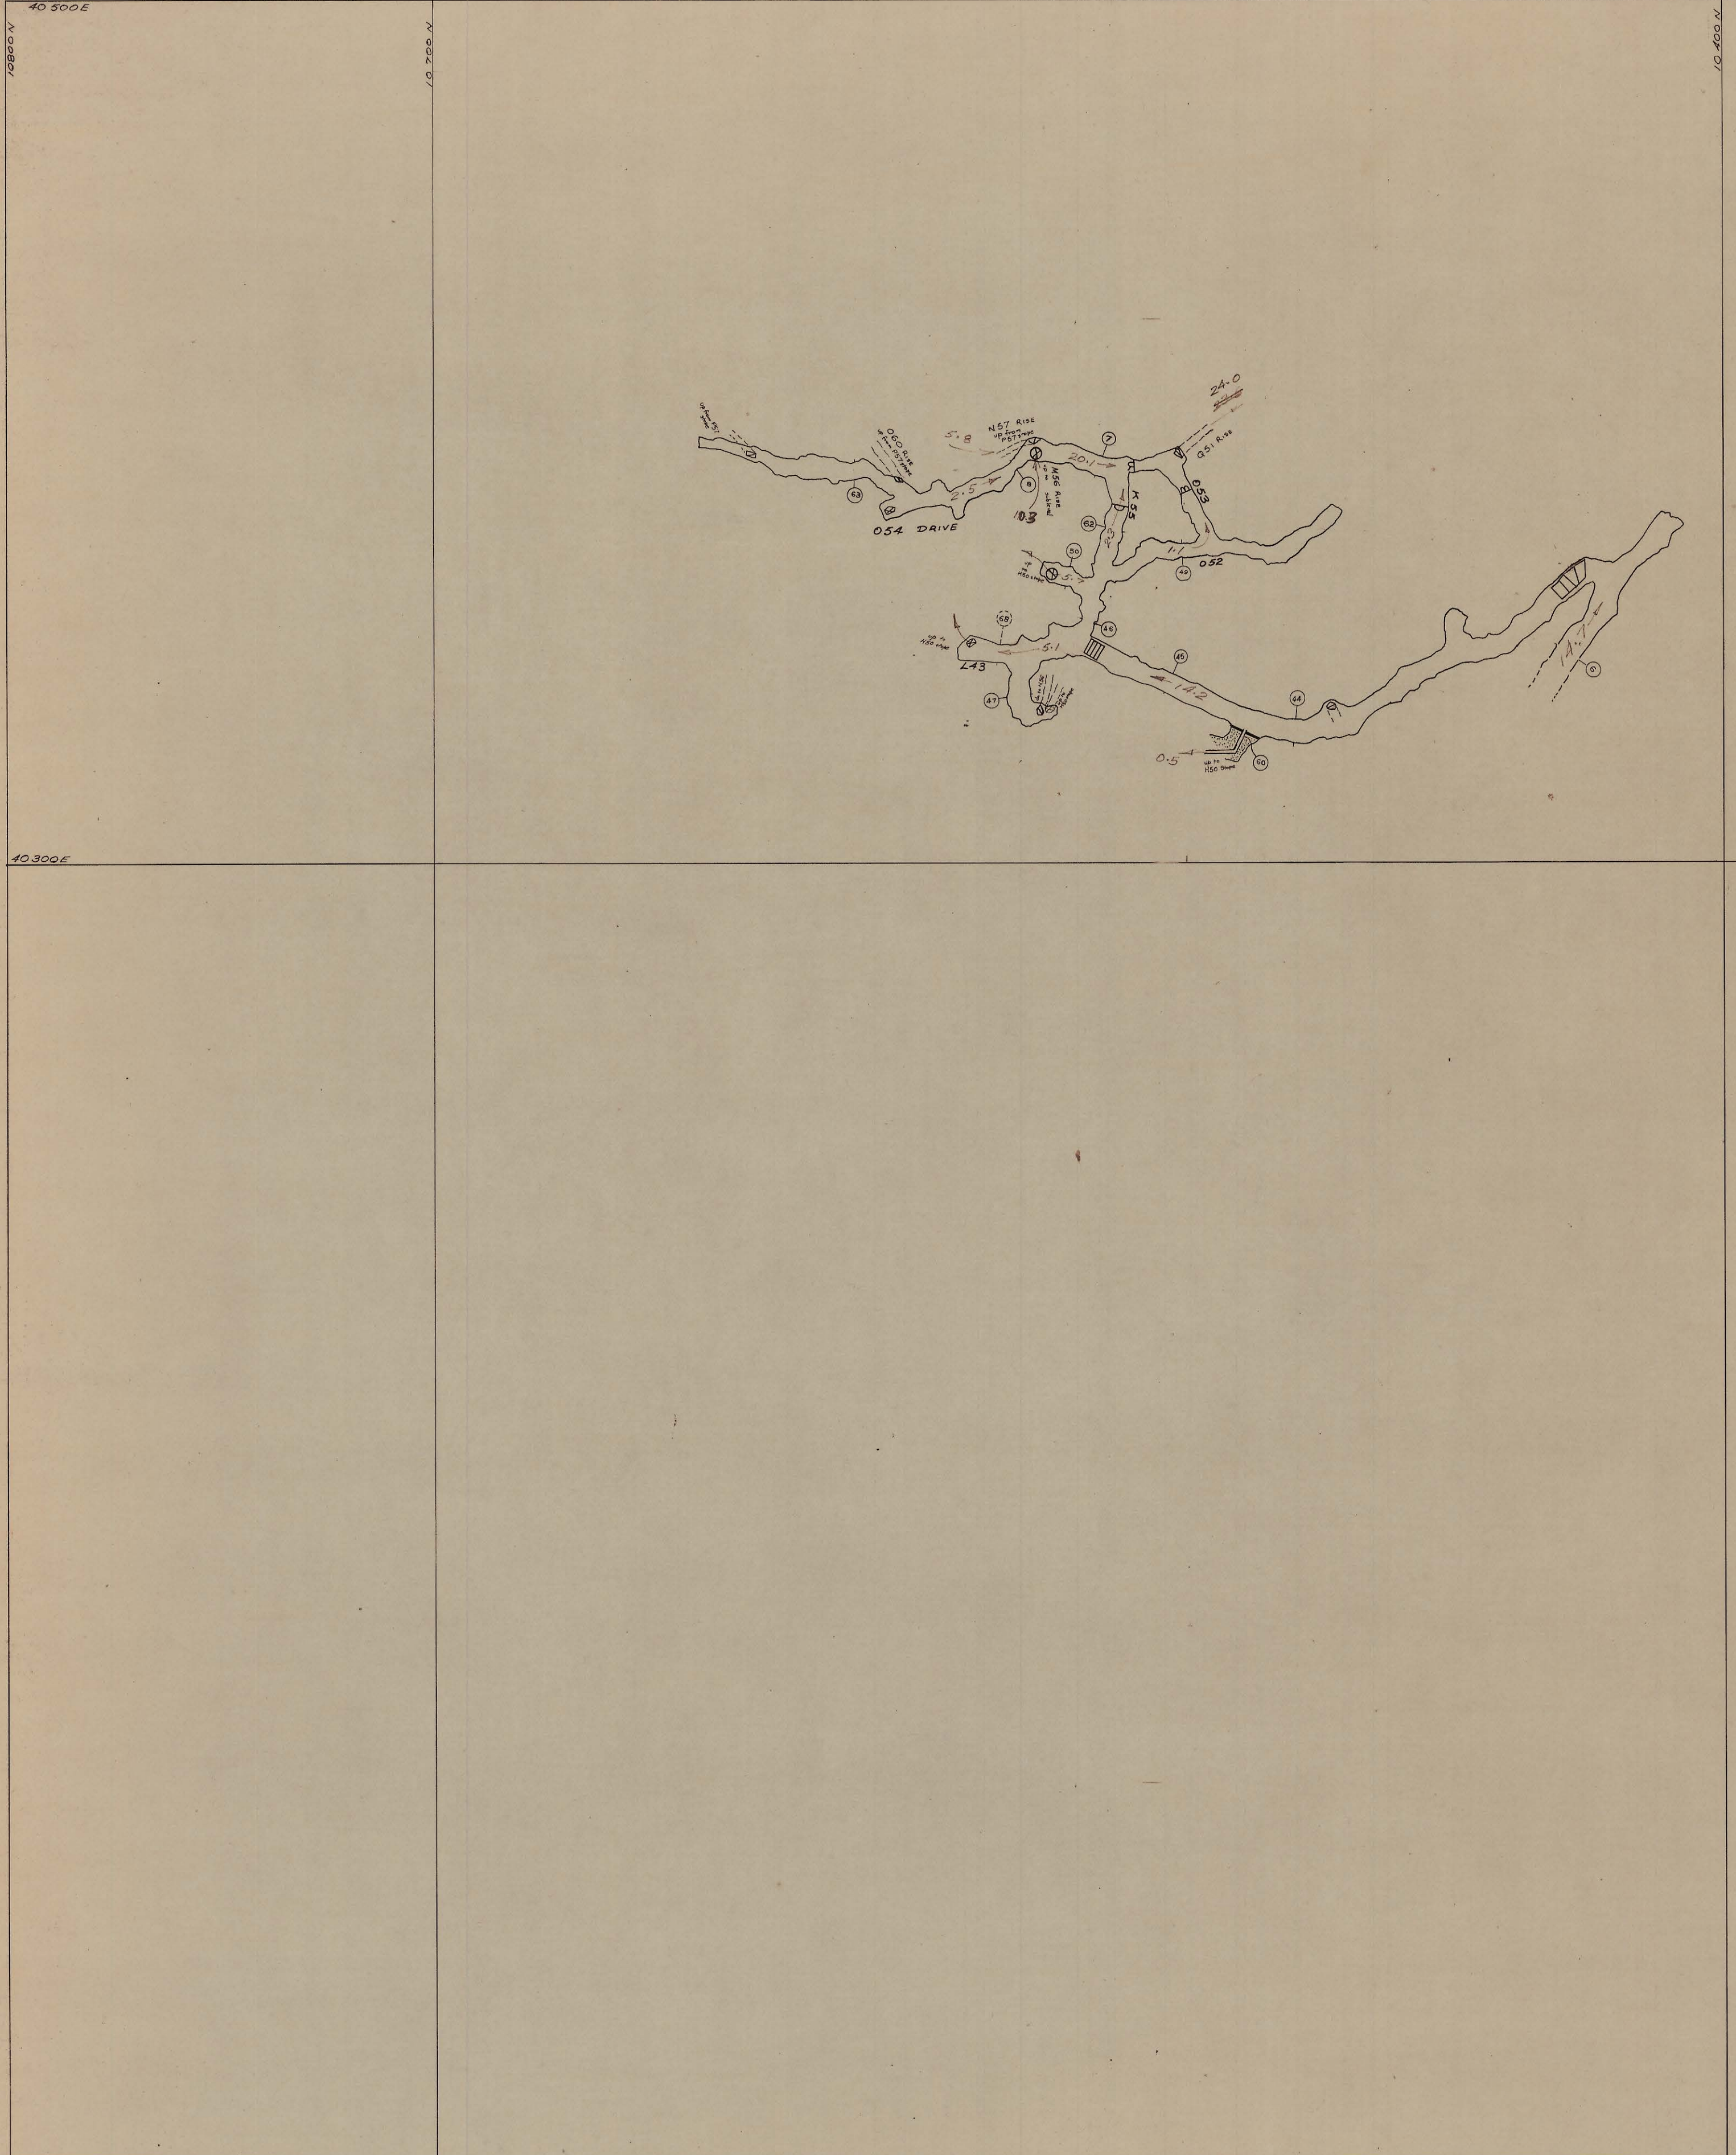
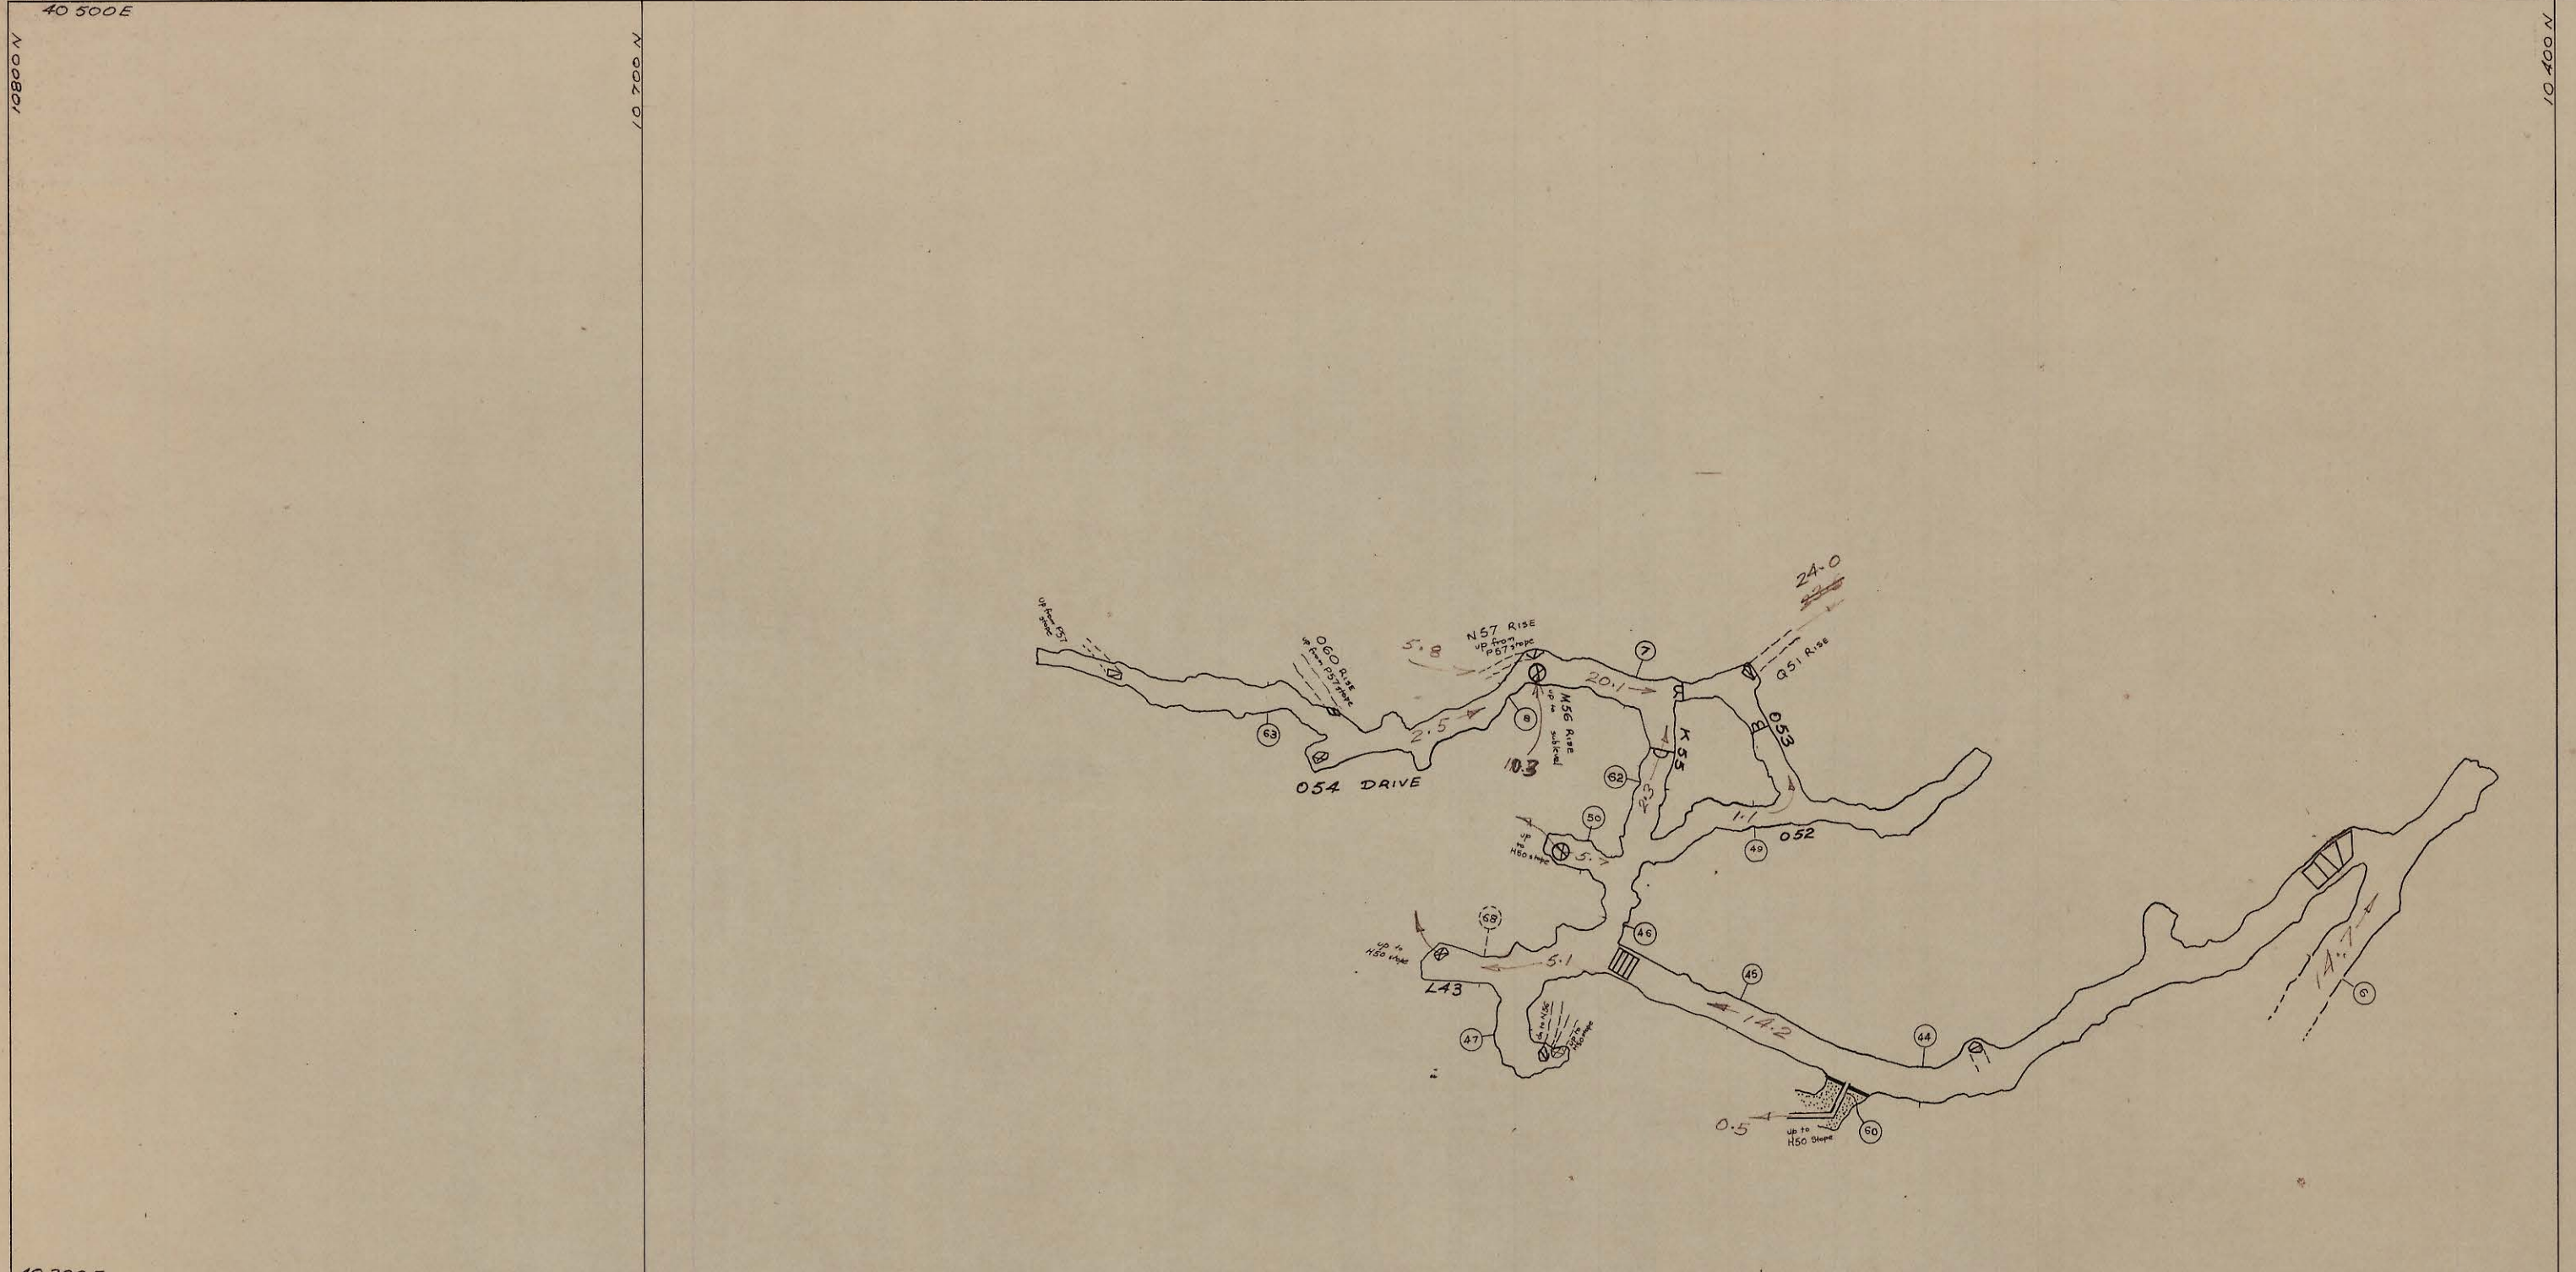

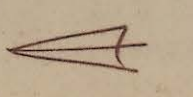


05BH05-100310

0374\_3540



SCALE 1:1000		LOCATION BOLD HEAD	 A DIVISION OF WARMAN INTERNATIONAL GRASSY KING ISLAND
	 north	SUBJECT AIRFLOW PLAN A Lens Development FEB 79	