


OSBM05-100316

0374_3544

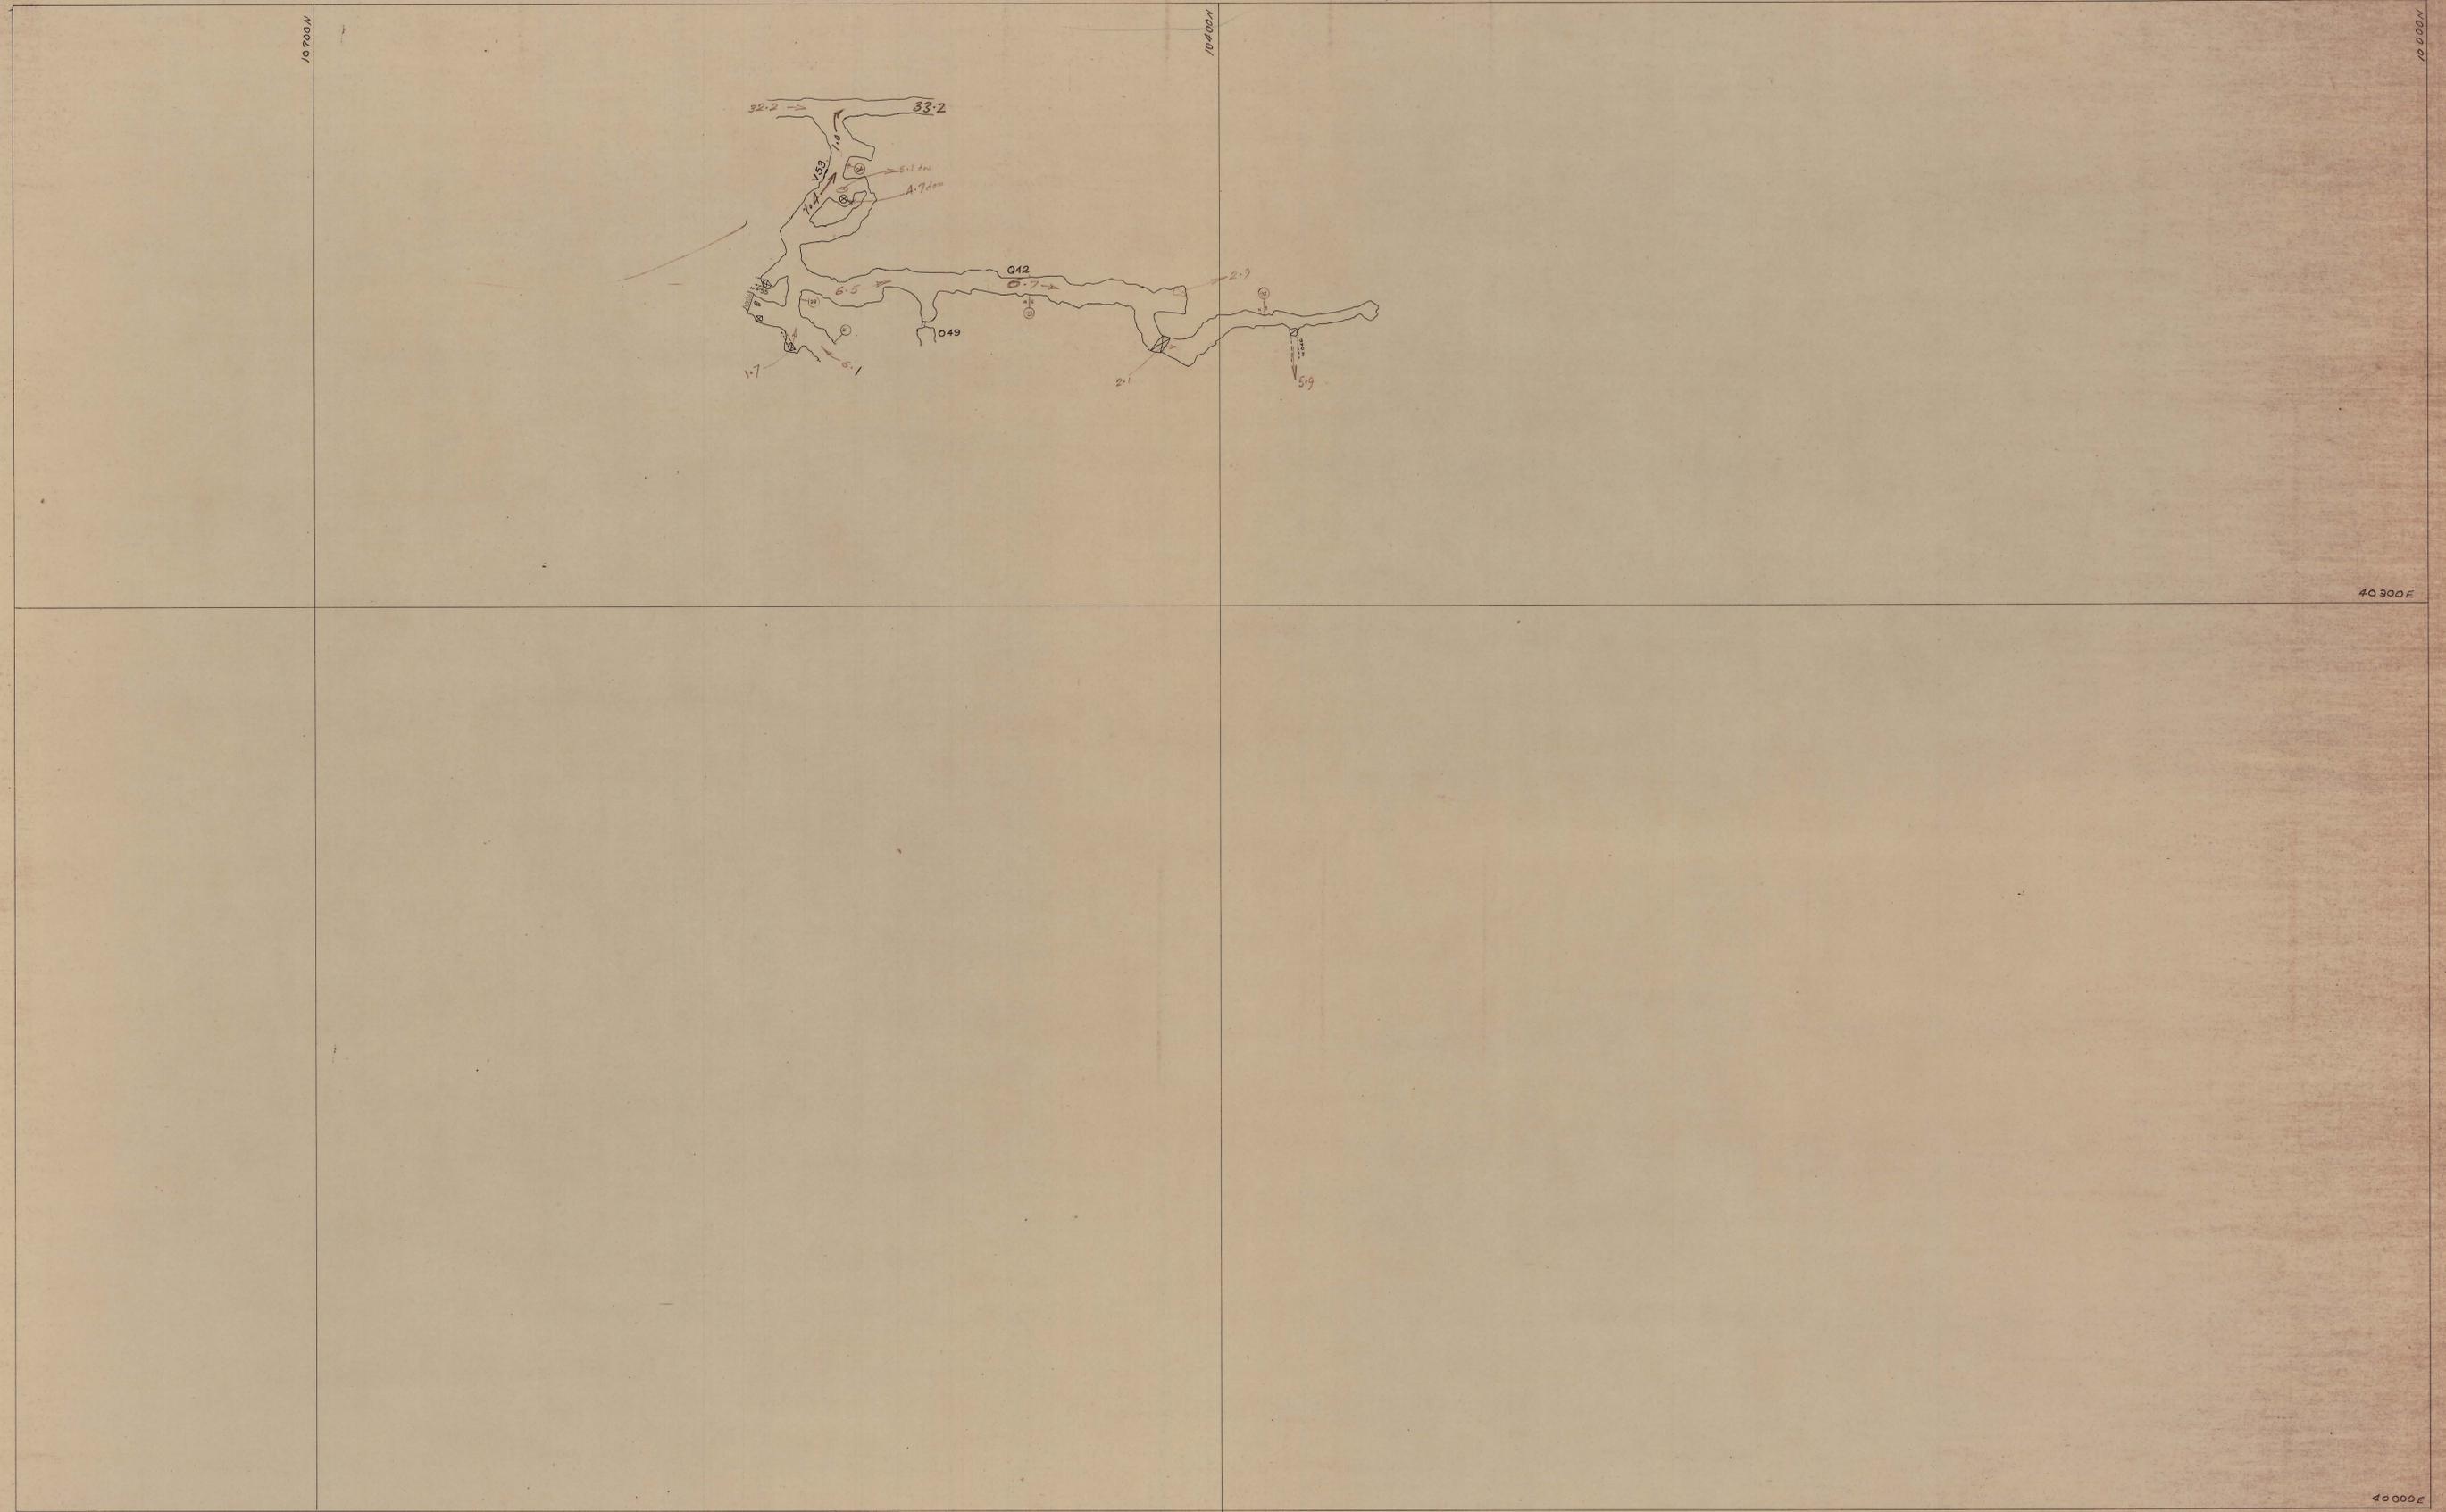

SCALE 1:1000

LOCATION BOLD HEAD

SUBJECT

north

KIS KING ISLAND SCHEELITE
A DIVISION OF WARMAN INTERNATIONAL

GRASSY KING ISLAND

PLAN NUMBER
OSBM05-100316