


05DM05 2022

0374_3554

5 cm

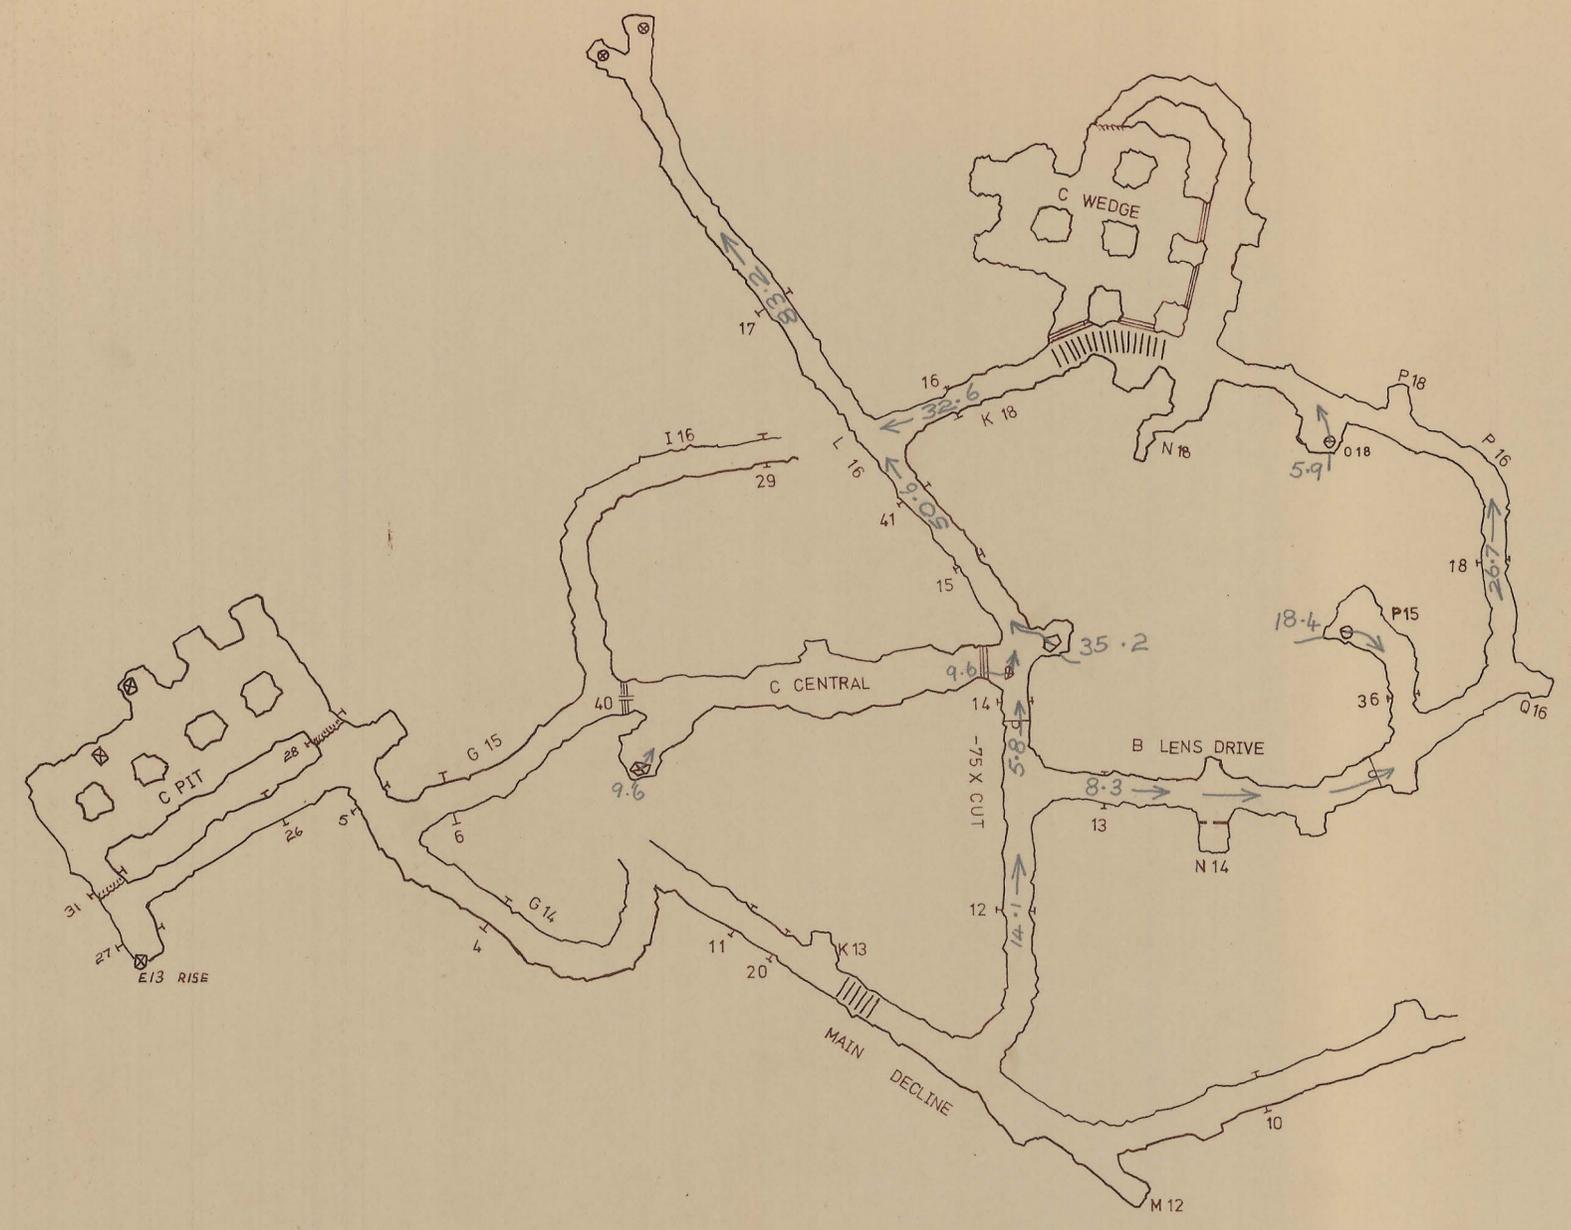


SCALE 1

AIRFLOW SURVEY
 15-12-76
 VOLUMES IN M³/S

north

DOLPHIN MINE

- 75 m ZONE
 VENTILATION PLAN

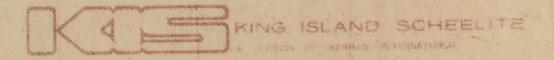

GRASSY KING ISLAND

PLAN NUMBER 05DM05 ~~0022~~ 0022