


05DM05 2023

0374_3555

5 cm

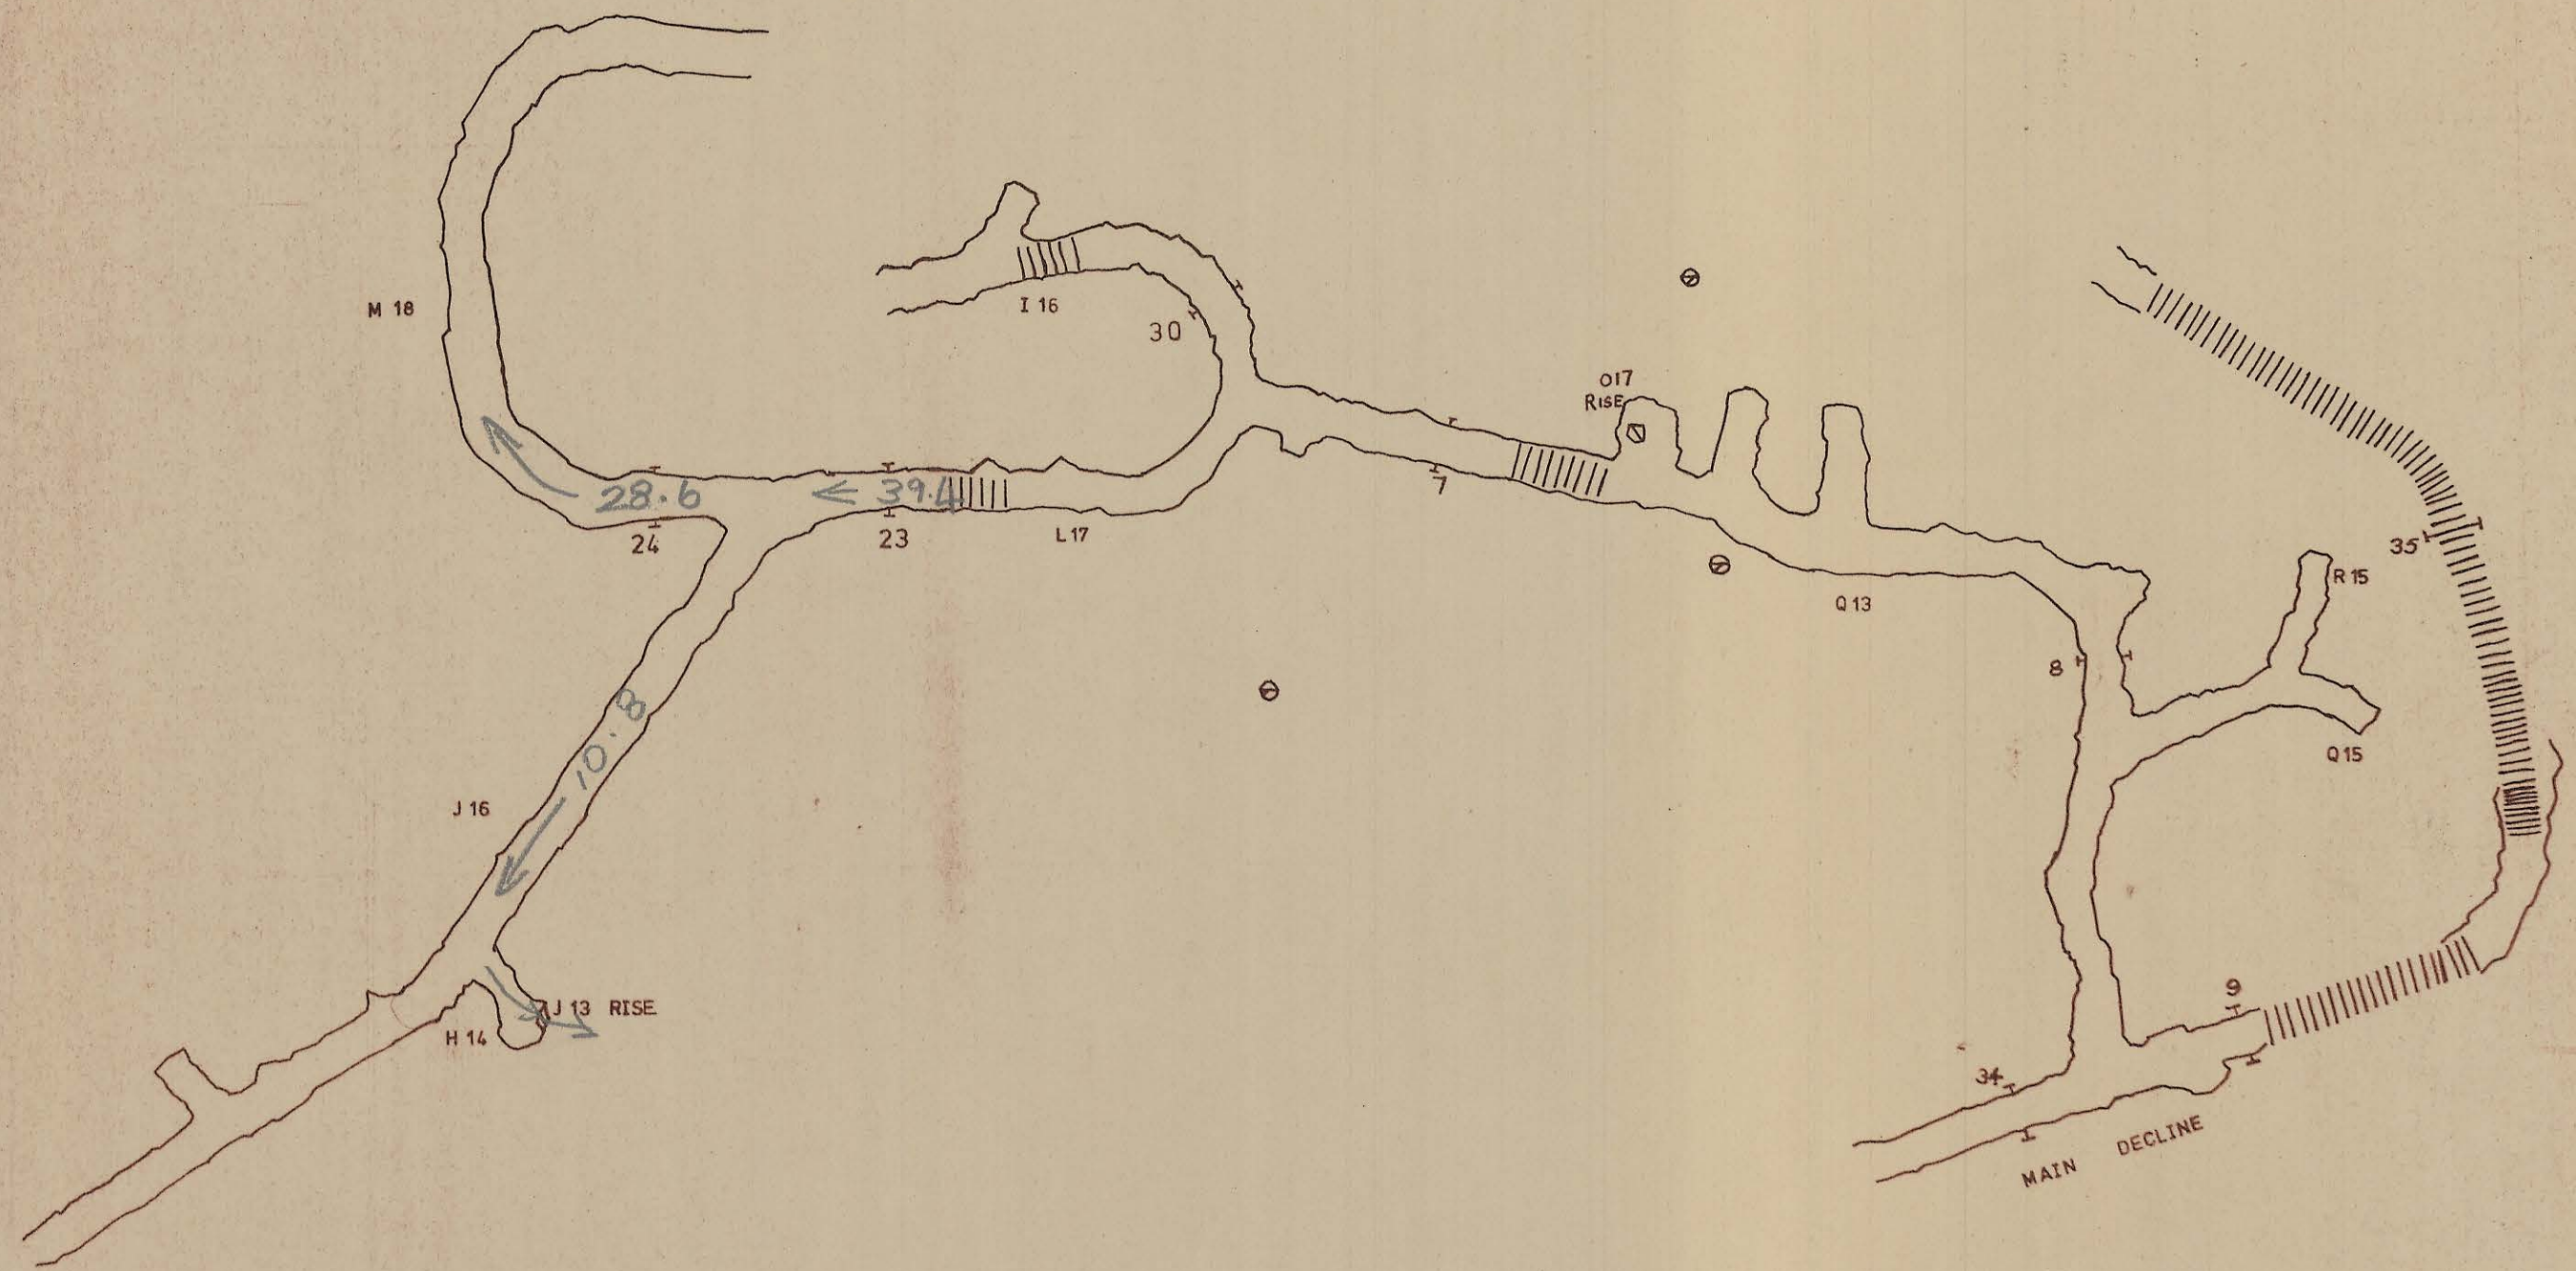

SCALE 1

AIRFLOW SURVEY
15-12-1976

Volumes in m^3/s

north

DOLPHIN MINE

- 100m ZONE
VENTILATION PLAN

KIS KING ISLAND SCHEELITE
A DIVISION OF WARMAN INTERNATIONAL
GRASSY KING ISLAND

05DM05 0023