


05DM05 0024

0374_3556

5 cm

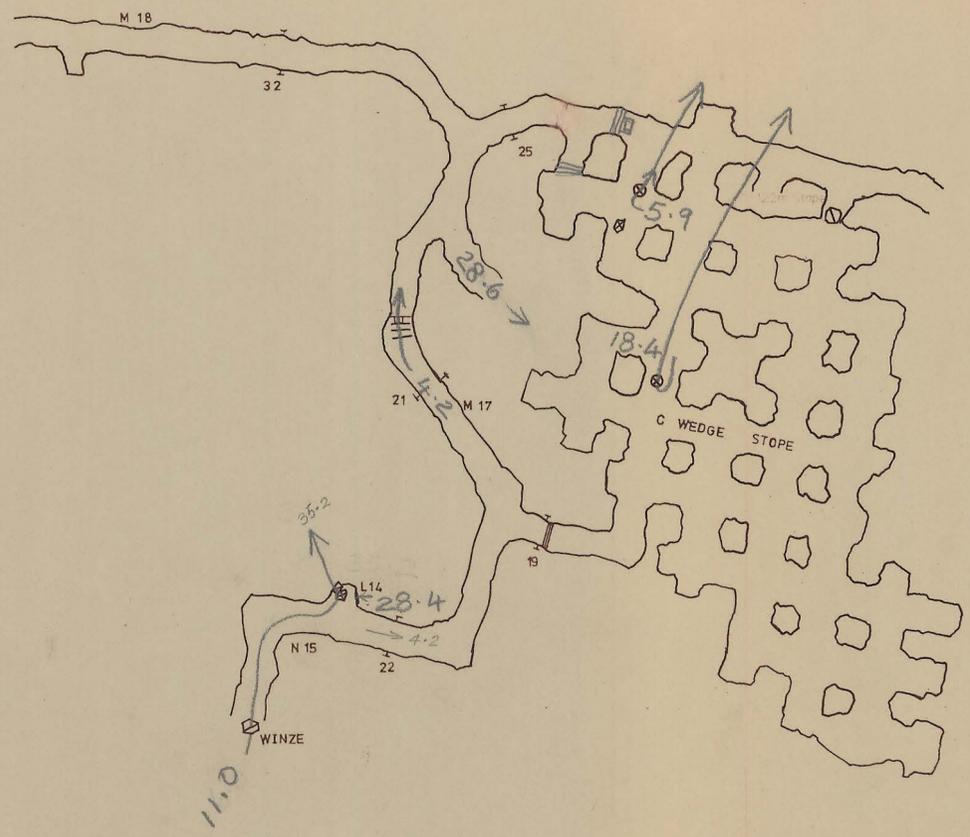

AIRFLOW SURVEY IN 1975

AIRFLOW SURVEY
15-12-76

VOLUMES IN M³/S

DOLPHIN MINE

- 125m ZONE

VENTILATION PLAN

KIS KING ISLAND SCHEELITE
A DIVISION OF VAMMIS INTERNATIONAL

05DM05

0024

564 2003

564 1003

564 0703