


05DM05 2025

0374_3557

5 cm

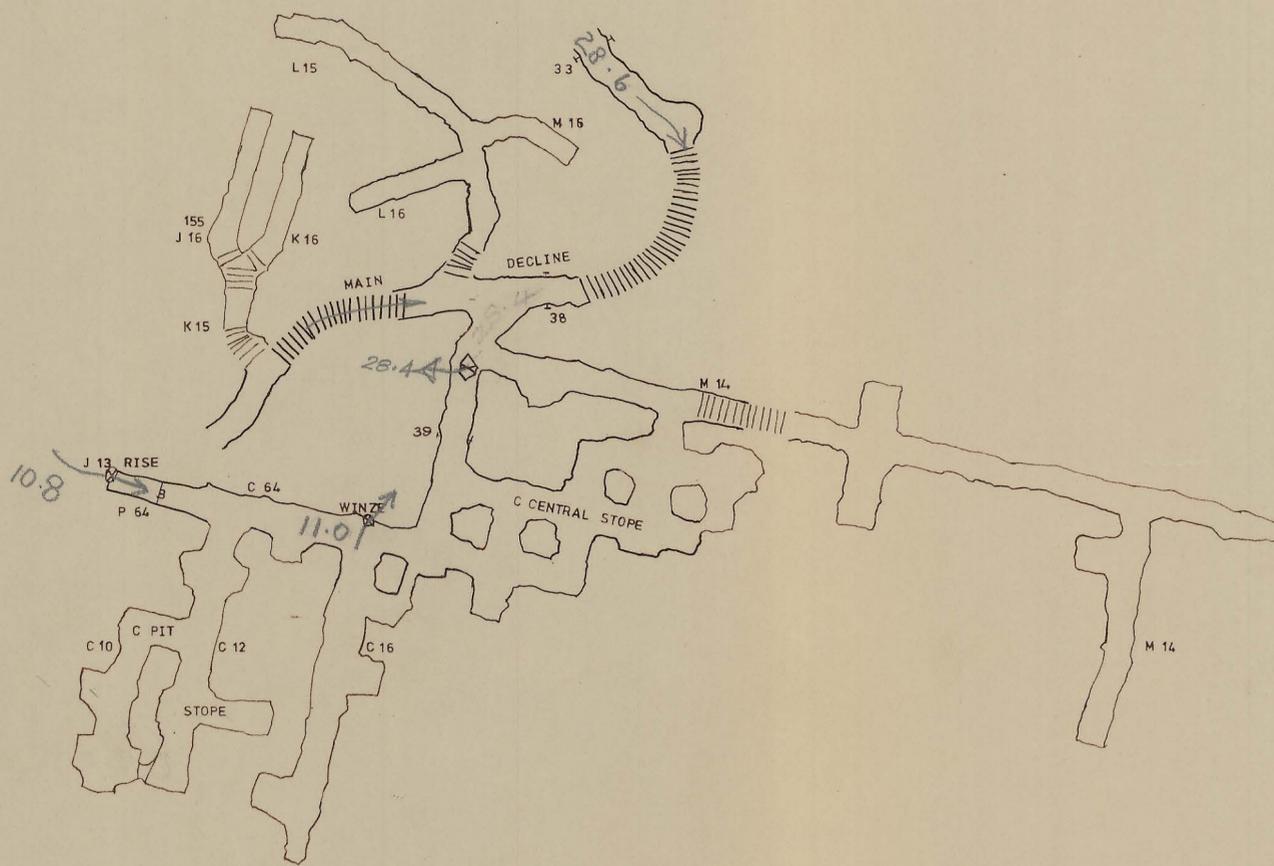

AIRFLOW SURVEY
 15-12-76
 VOLUMES IN M³/S

DOLPHIN MINE
 -150m ZONE
 VENTILATION PLAN

05DM05 0025