


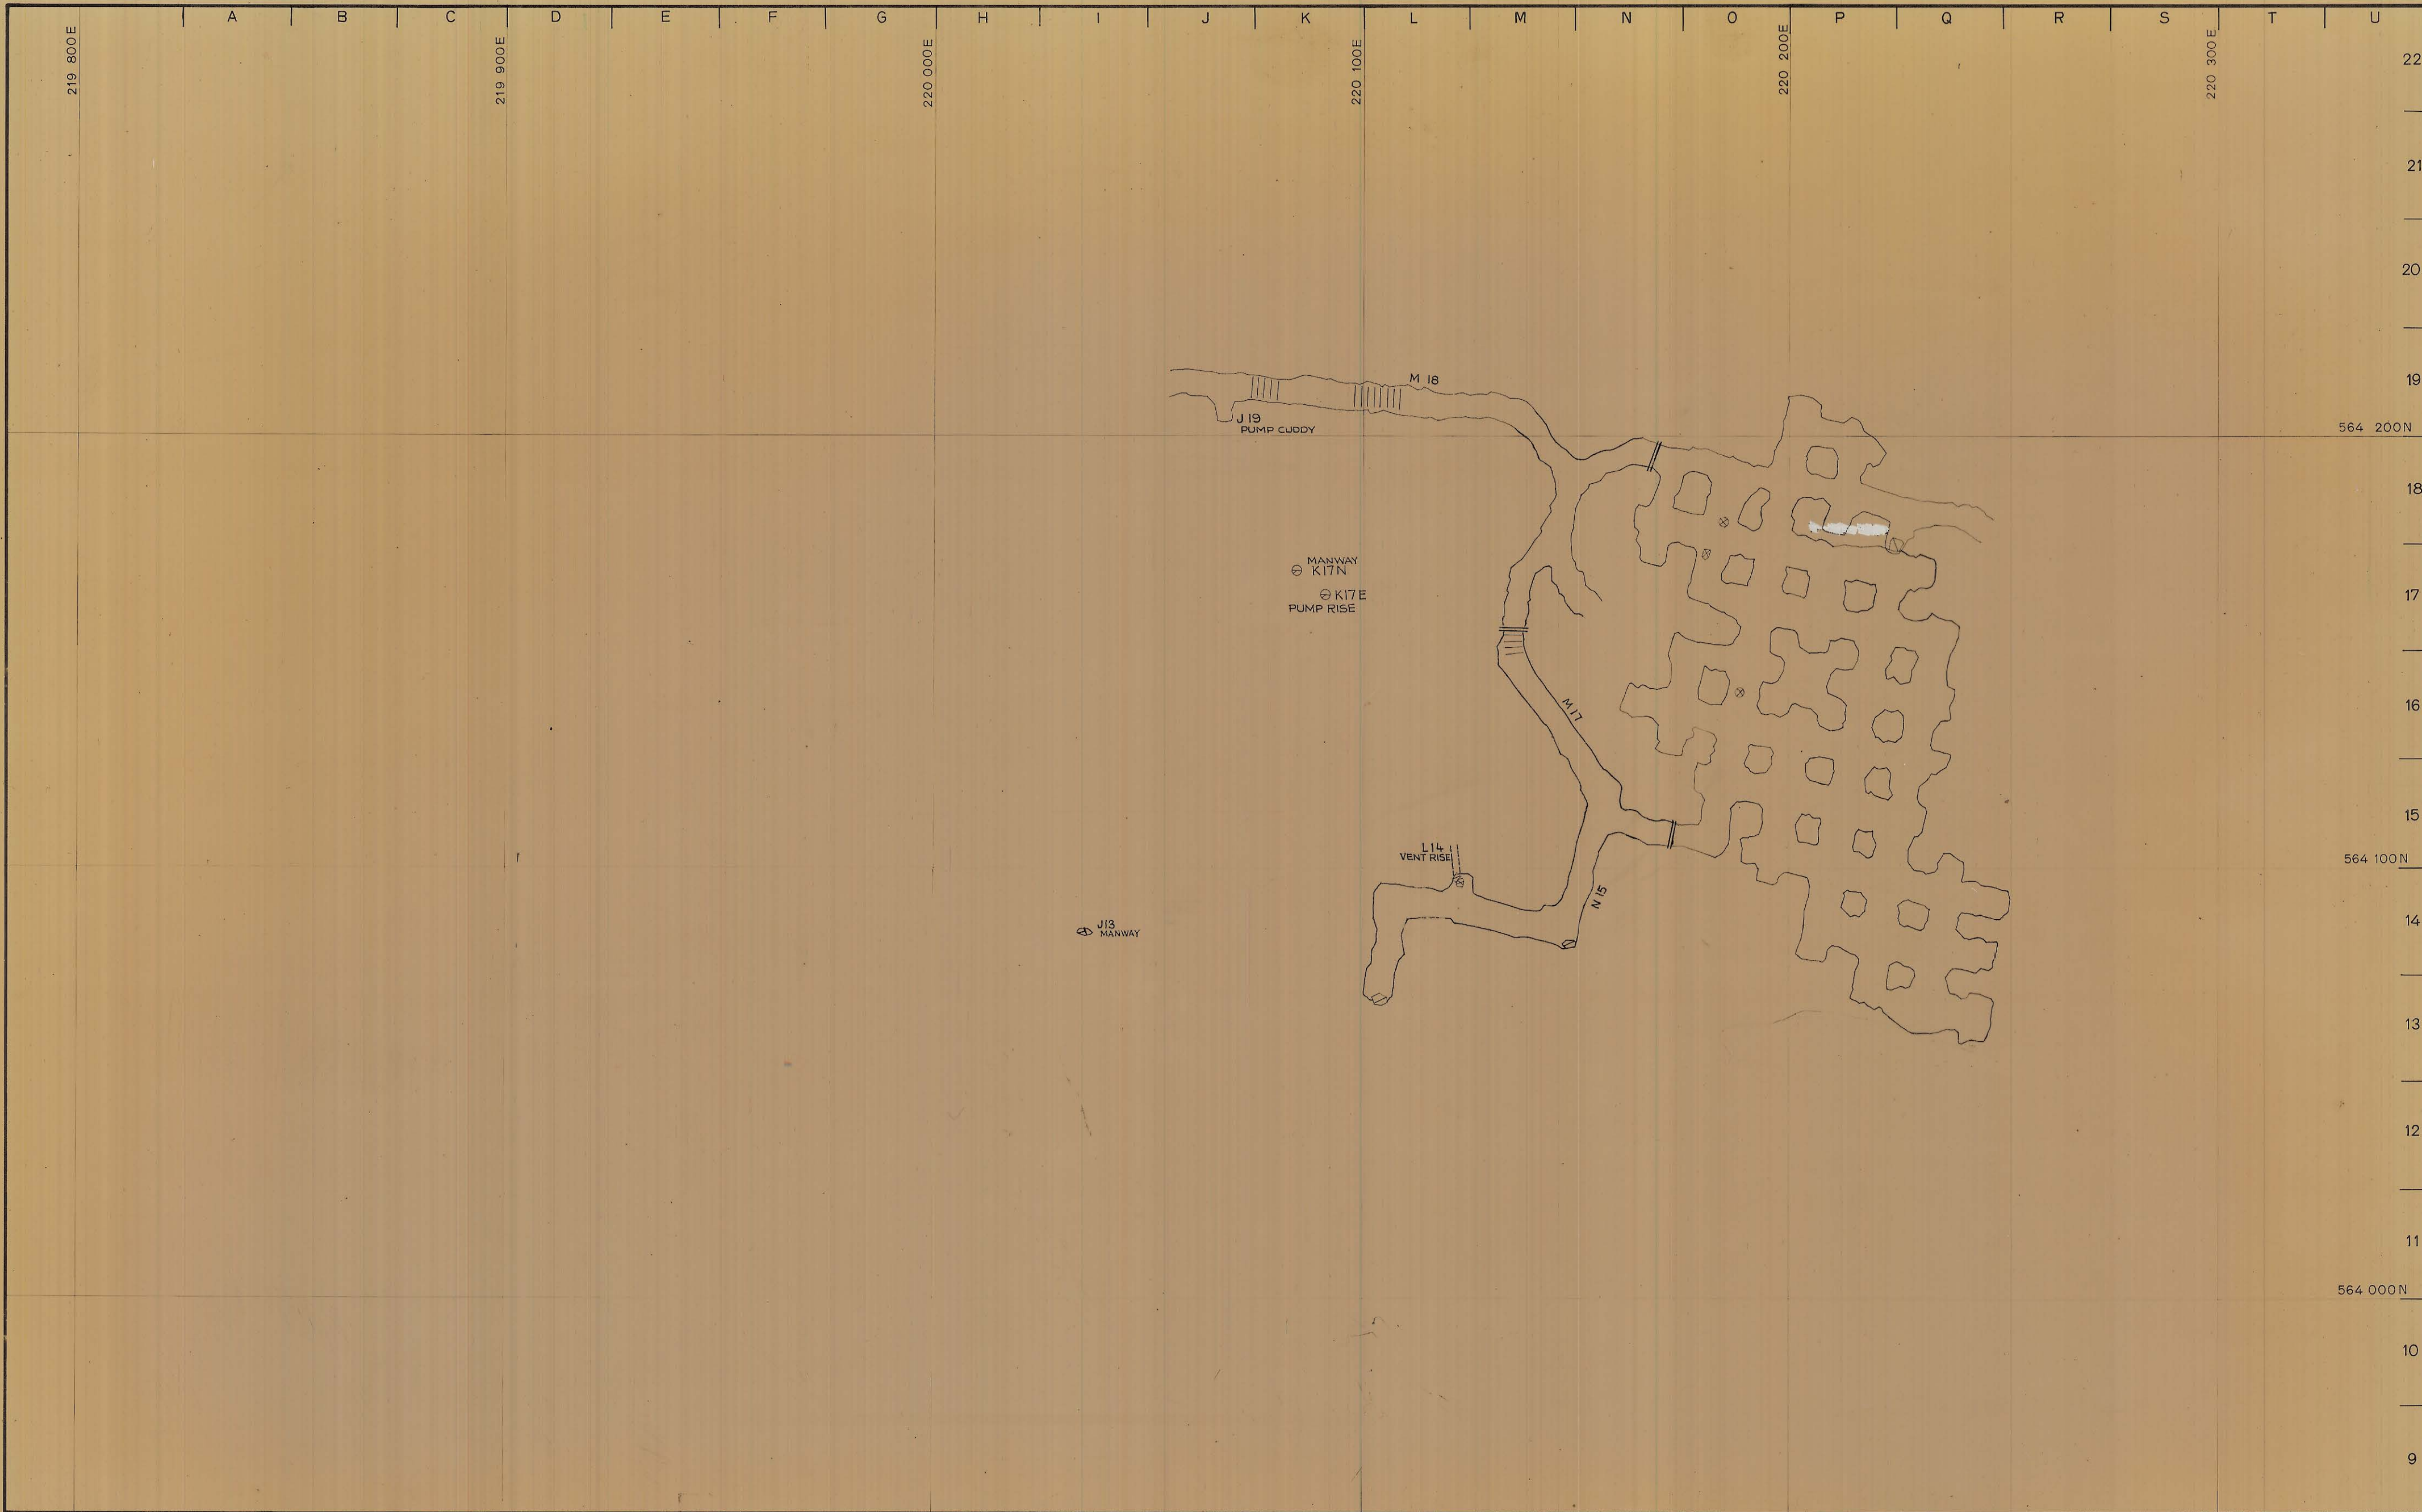

SCALE 1:1000

RESULTS OF AIRFLOW SURVEY
CARRIED OUT ON

Volume expressed in m^3/s

north

LOCATION

DOLPHIN MINE

SUBJECT

- 125 m ZONE



KING ISLAND SCHEELITE
A DIVISION OF WARMAN INTERNATIONAL

GRASSY

KING ISLAND

PLAN NUMBER

05DM05

2004

27 JUN 1981

0374_3562

5 cm

05DM05-2004