


27 JUN 1981

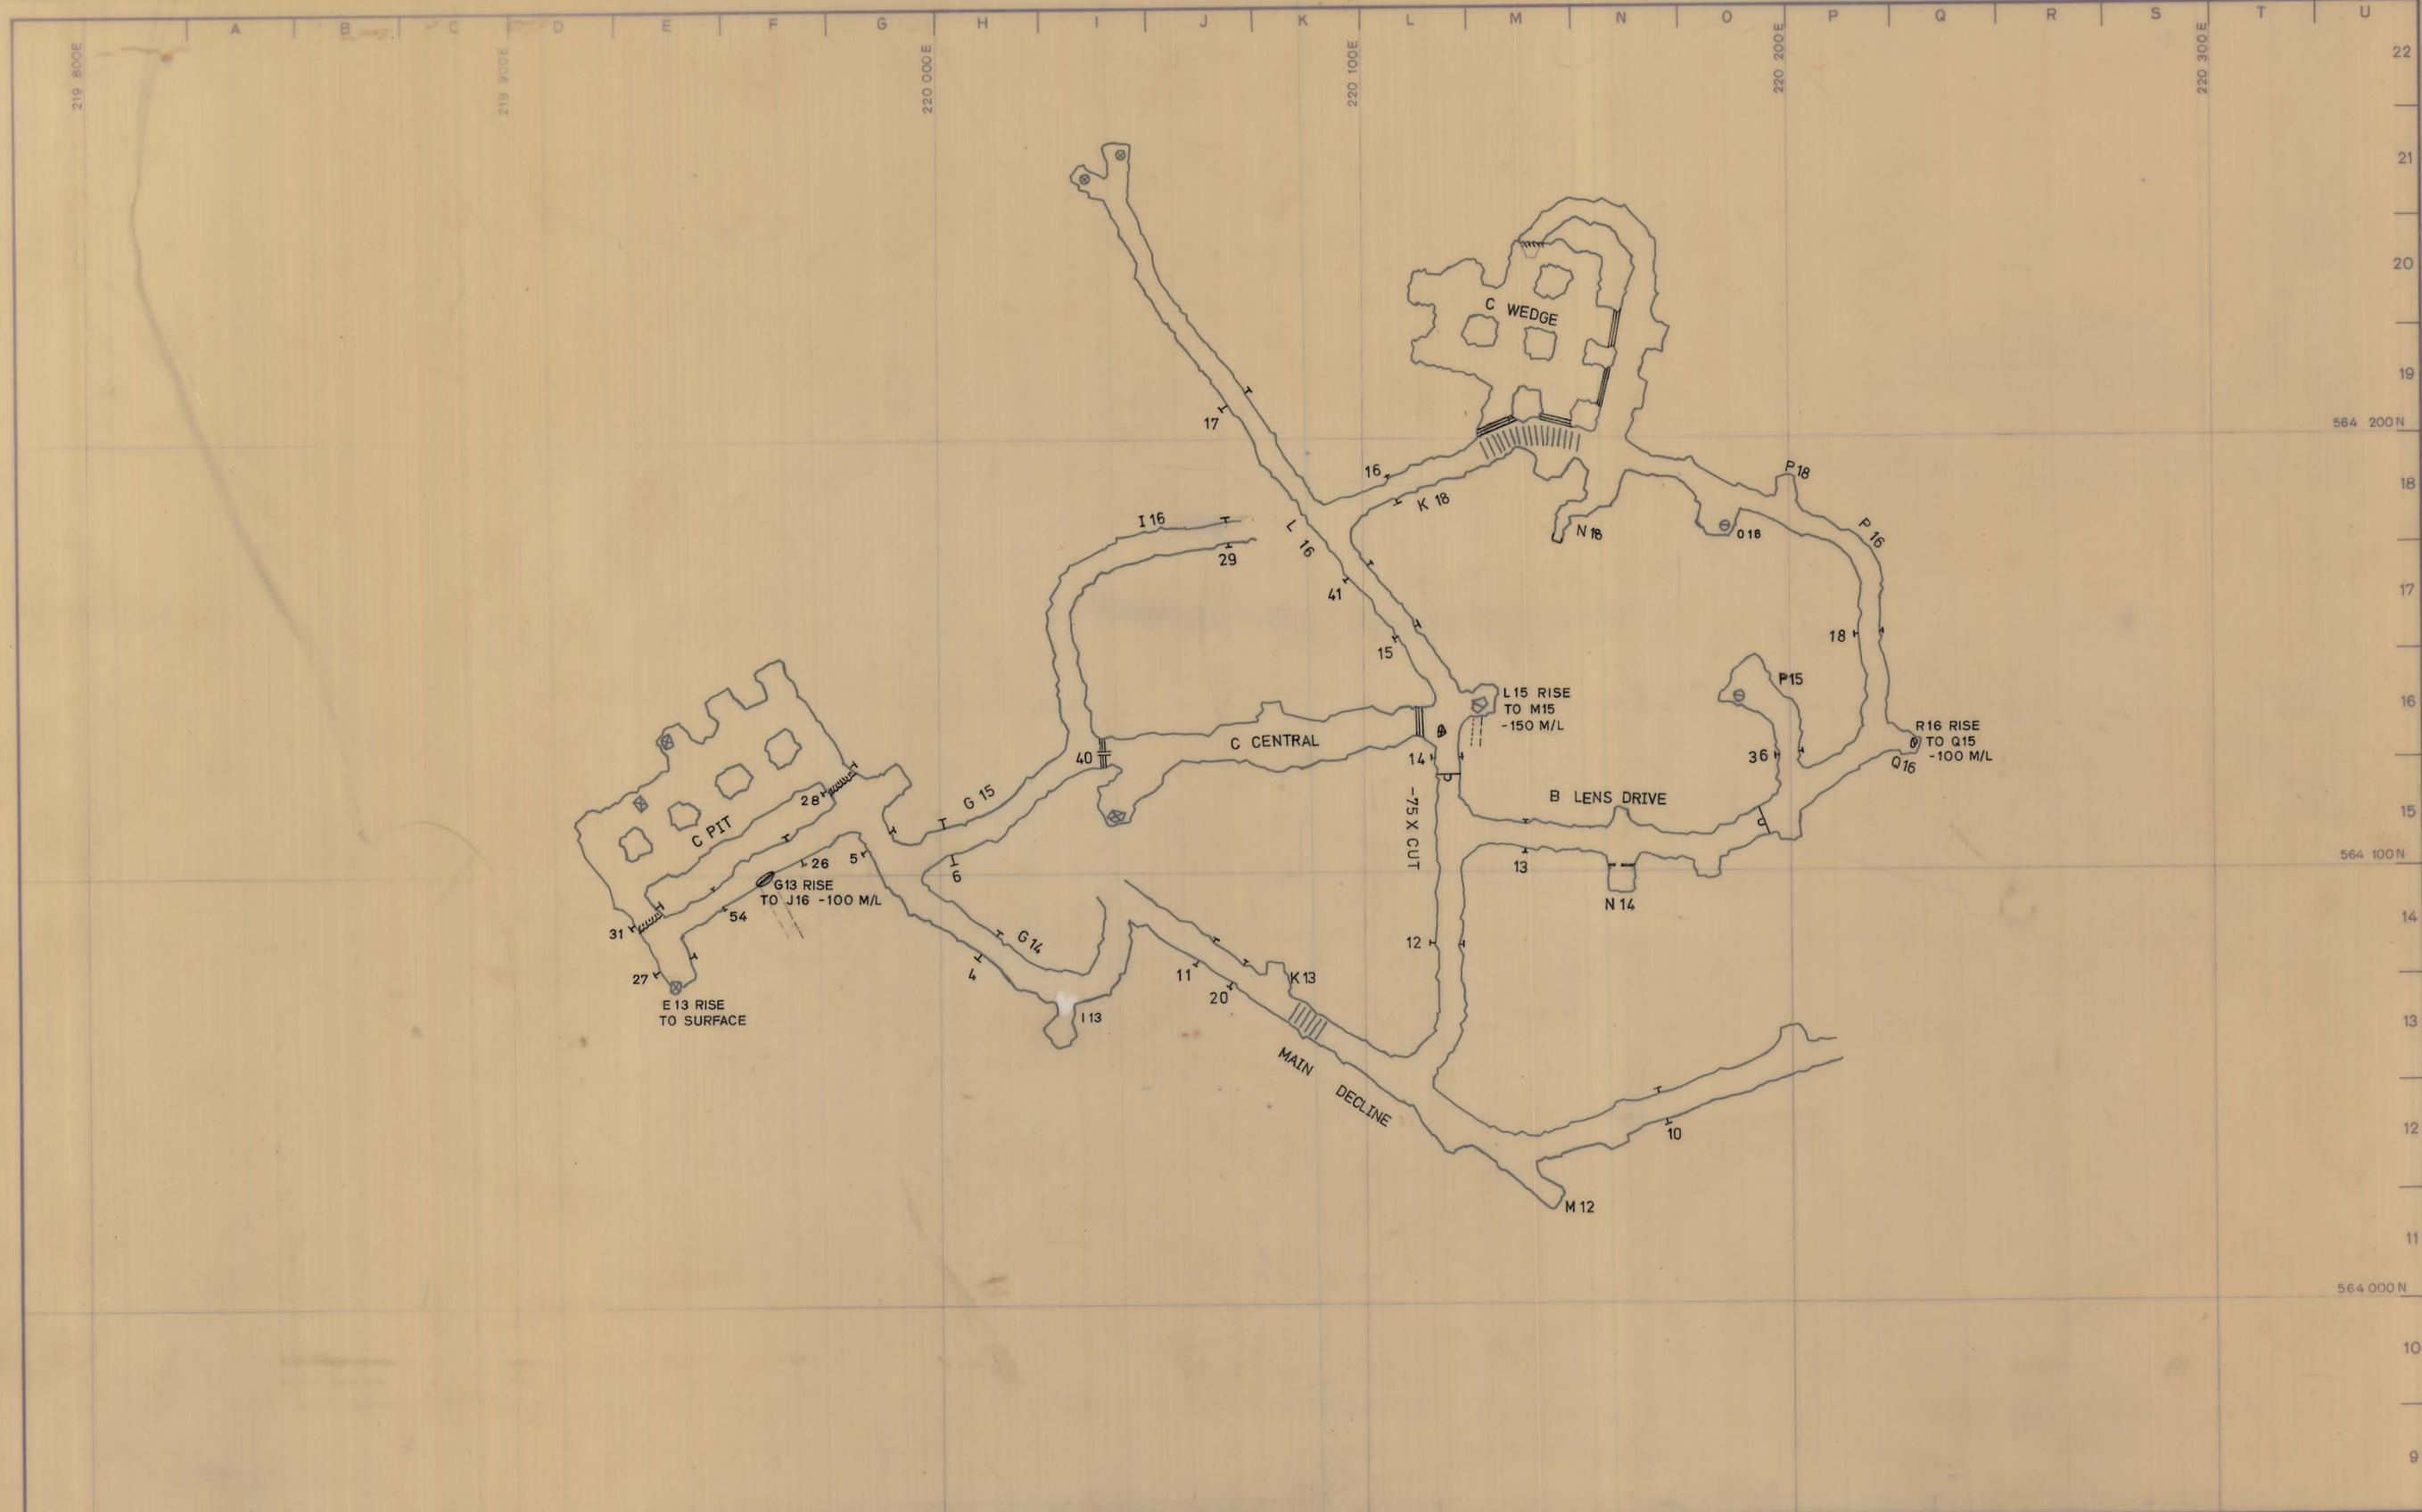

0374_3564

5 cm

05DM05-2035

SCALE 1:

north

LOCATION

SUBJECT

- 75 m ZONE

VENTILATION PLAN

KIS KING ISLAND SCHEELITE
A DIVISION OF WARMAN INTERNATIONAL

GRASSY KING ISLAND

PLAN NUMBER 05DM05 - 2035