


05DM05 2031

0374_3570

5 cm

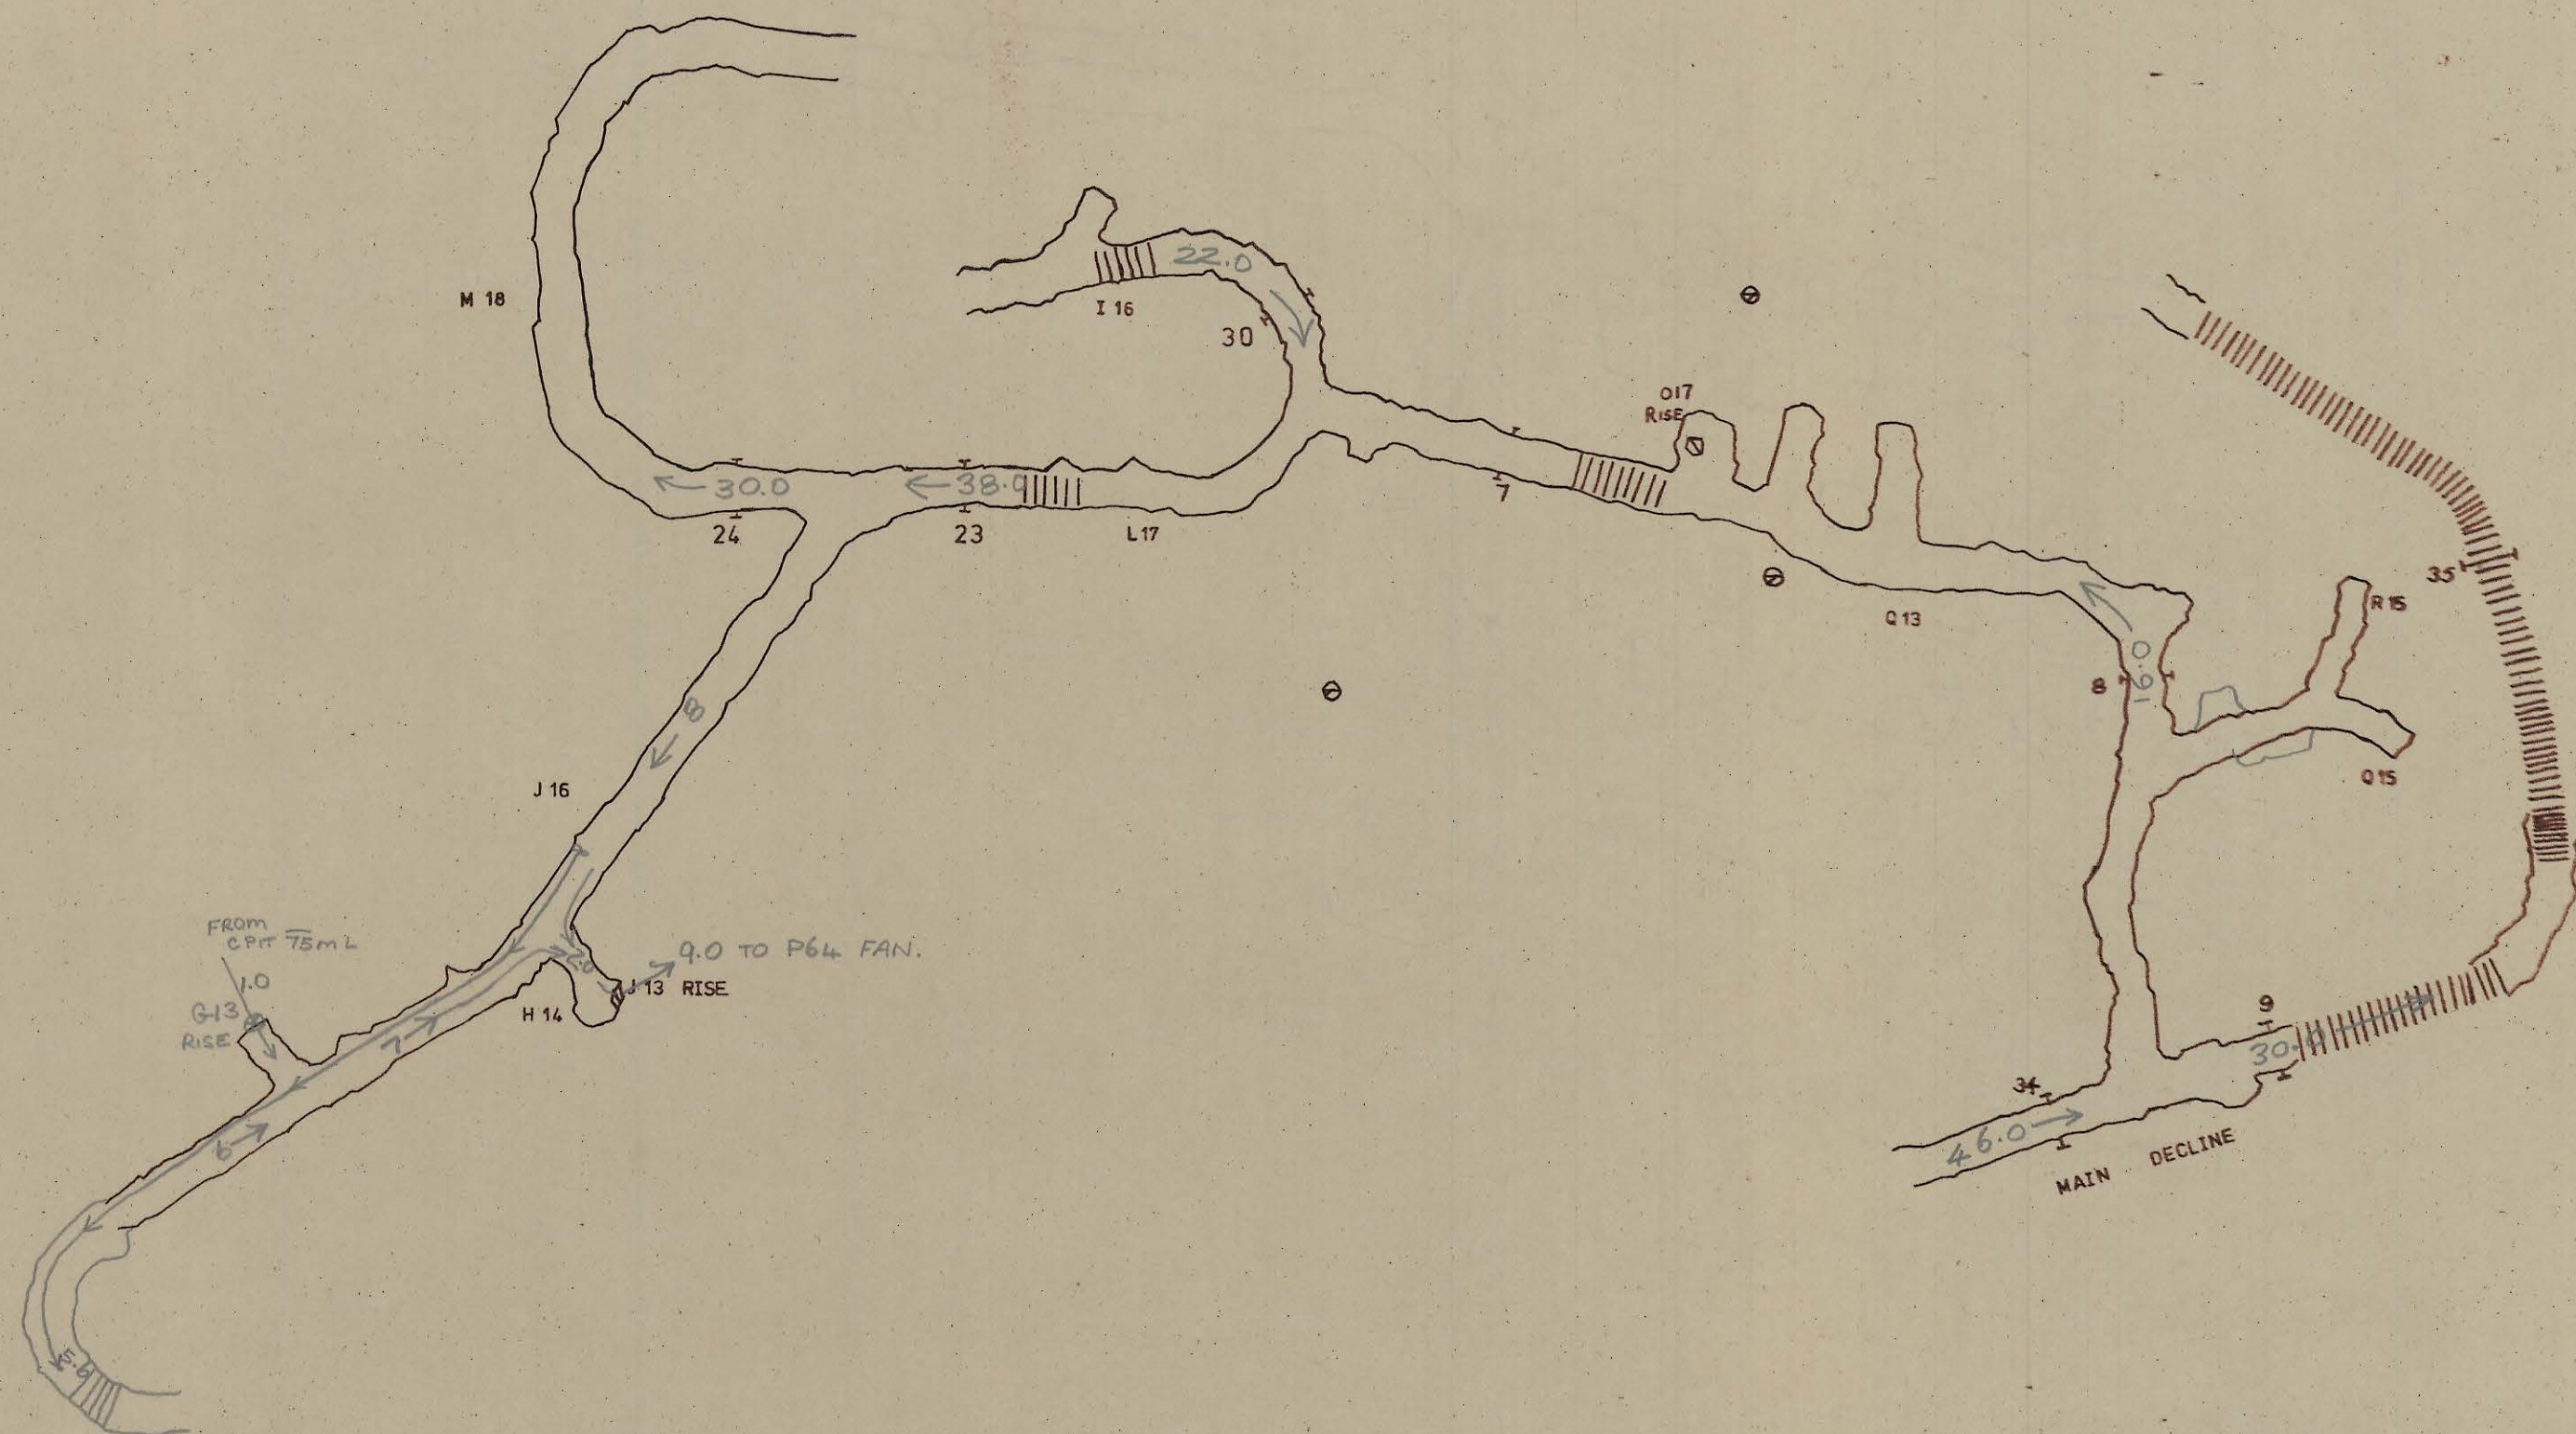

SCALE 1:1

DOLPHIN MINE
VENTILATION SUMMARY
APRIL 1977
VOLUMES IN M³/S

north

- 100m ZONE
VENTILATION PLAN

KIS KING ISLAND SCHEELITE
A DIVISION OF WARRIOR MINERALS LTD.

GRASSY KING ISLAND

PLAN NUMBER 05DM05 2031