


06162-06-270 E

0374-359

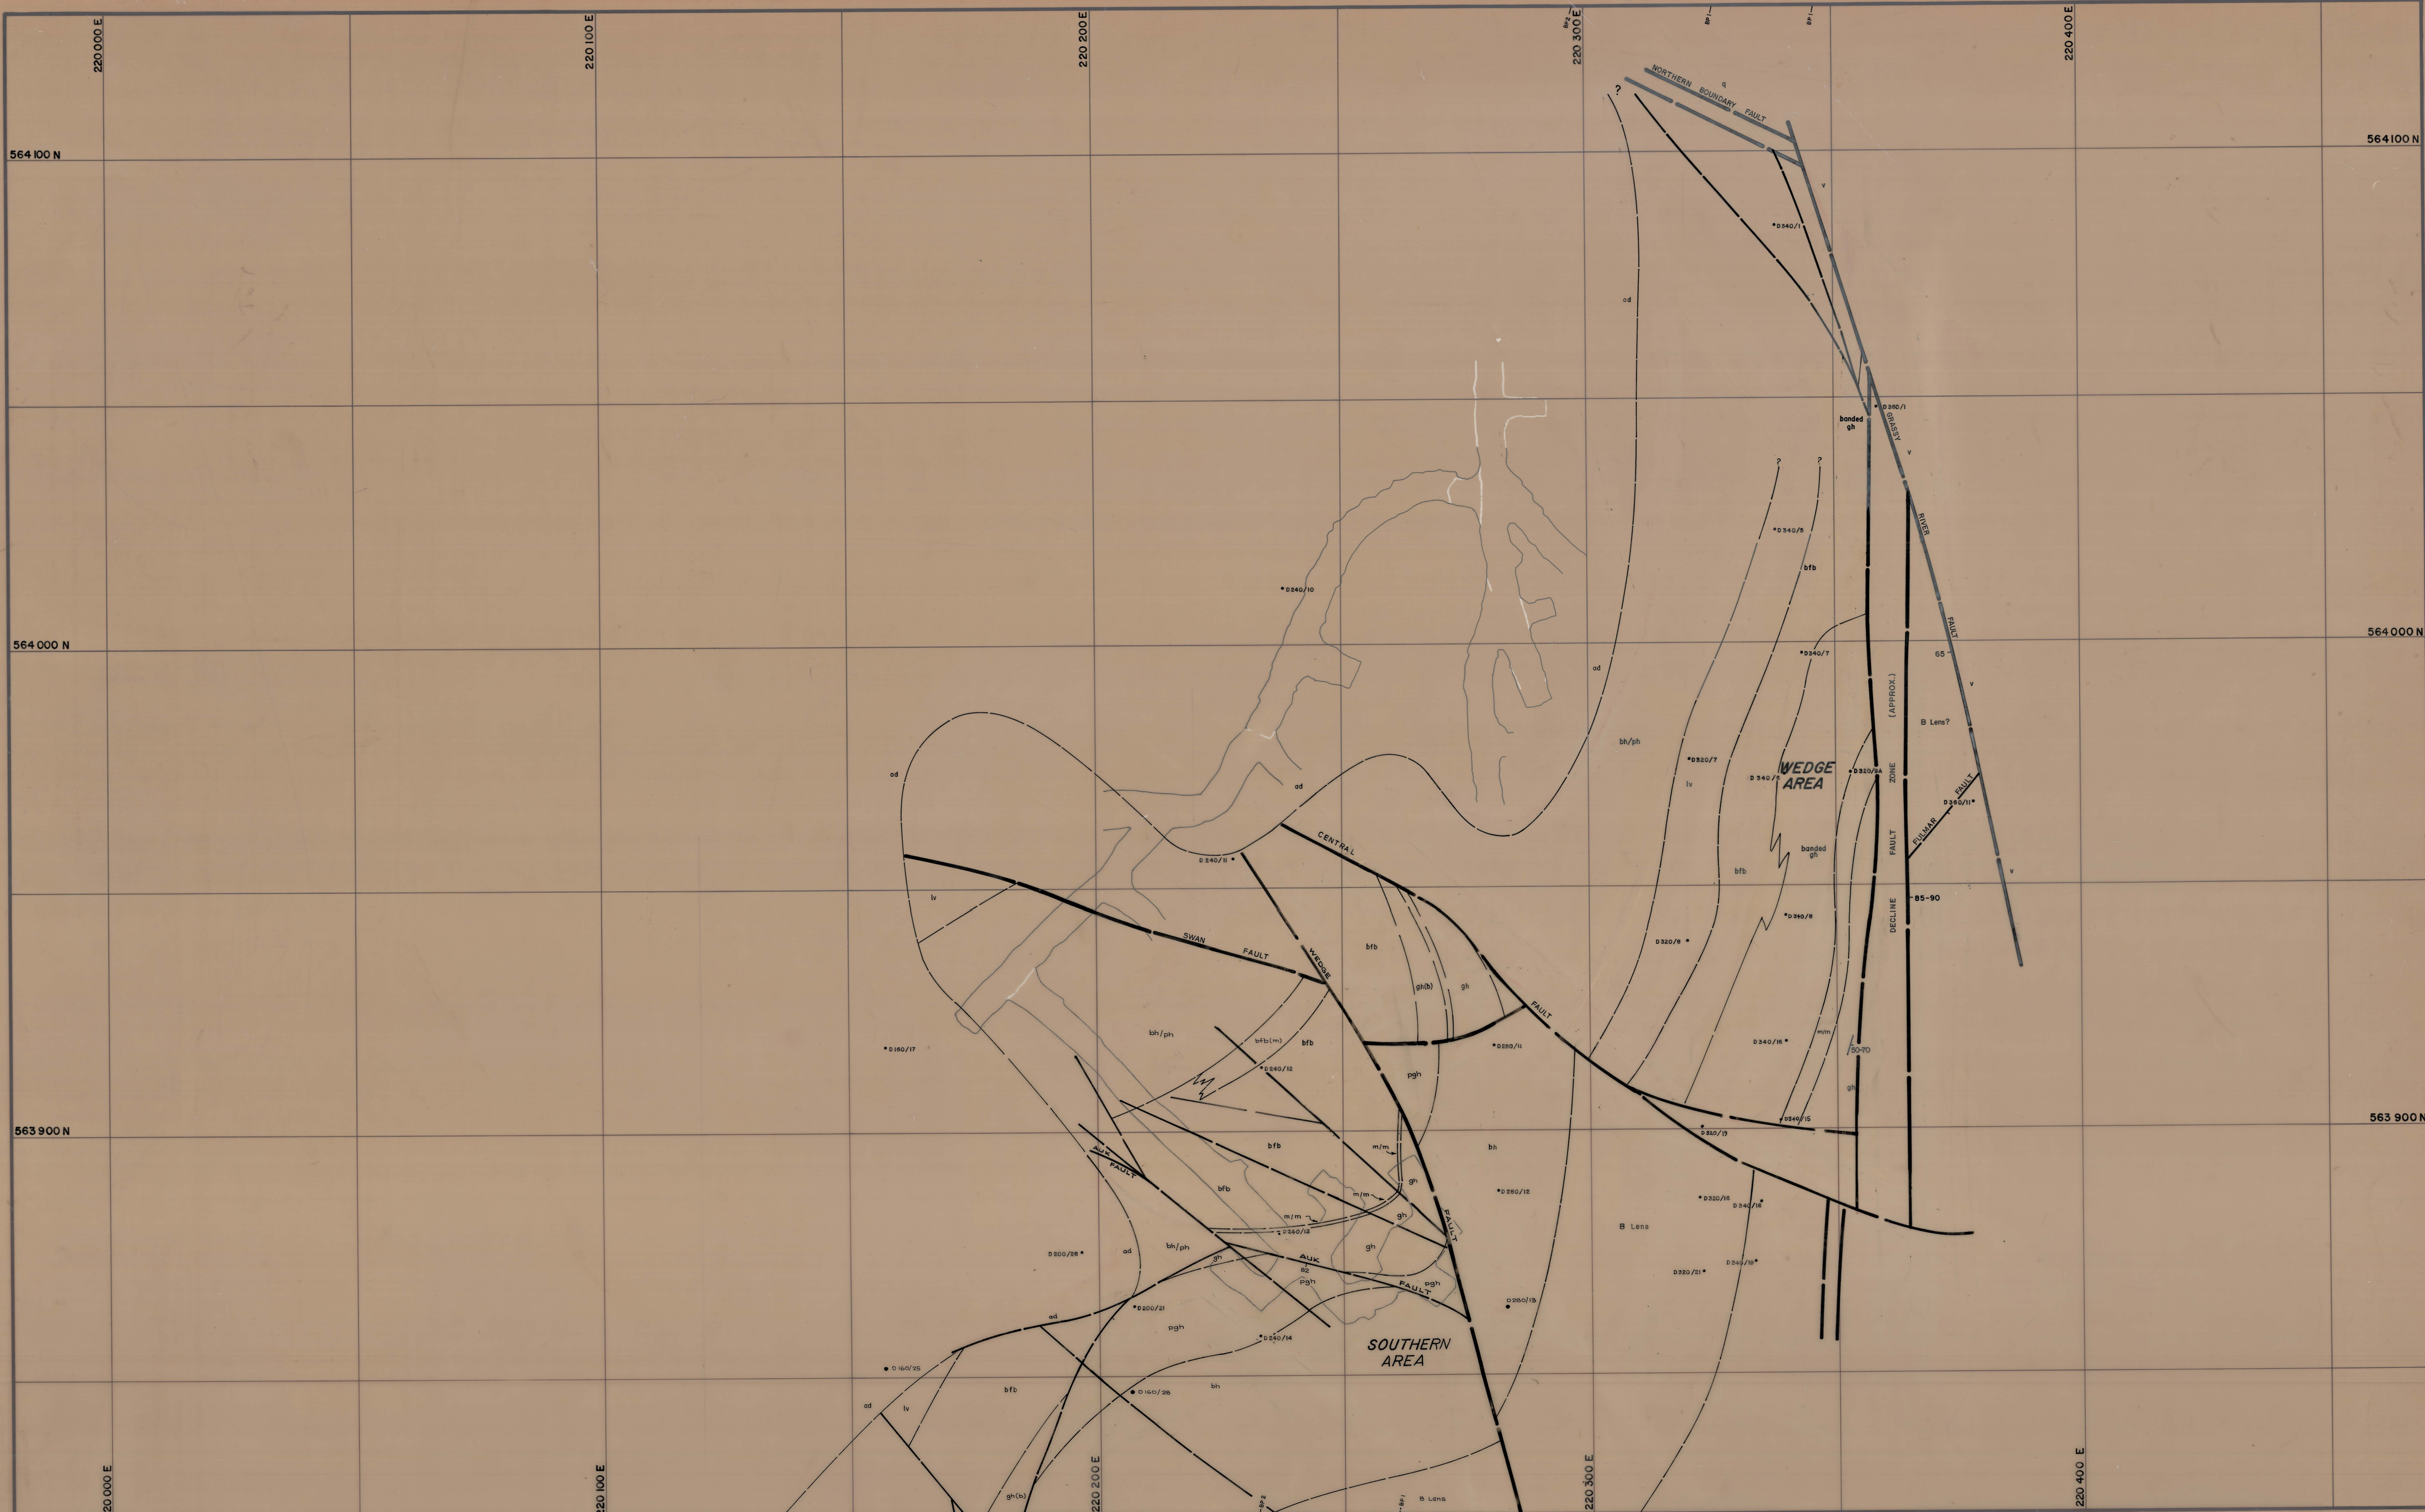

LEGEND			
	Upper metavolcanics		Banded footwall beds
	Banded hornfels		Biotite pyroxene hornfels
	Marble		Lower metavolcanics
	Biotite hornfels		Quartzite
	Pyroxene garnet hornfels		Aplite
	Garnet hornfels		Adamellite
			Strike and dip
			Joint, inclined
			Joint, vertical
			Fault
			Roadway R.L. -127.3m

Updated 24-7-96 ASD

DATE: 2/96

GEOLOGIST: [Signature]

DRAWN: [Signature]

CHECKED: [Signature]

KING ISLAND SCHEELITE

SCALE: 1:500

No. K62-06-270 E

DOLPHIN MINE

GEOLOGICAL LEVEL PLAN

- 270m R.L.