


5 cm

0374-3599

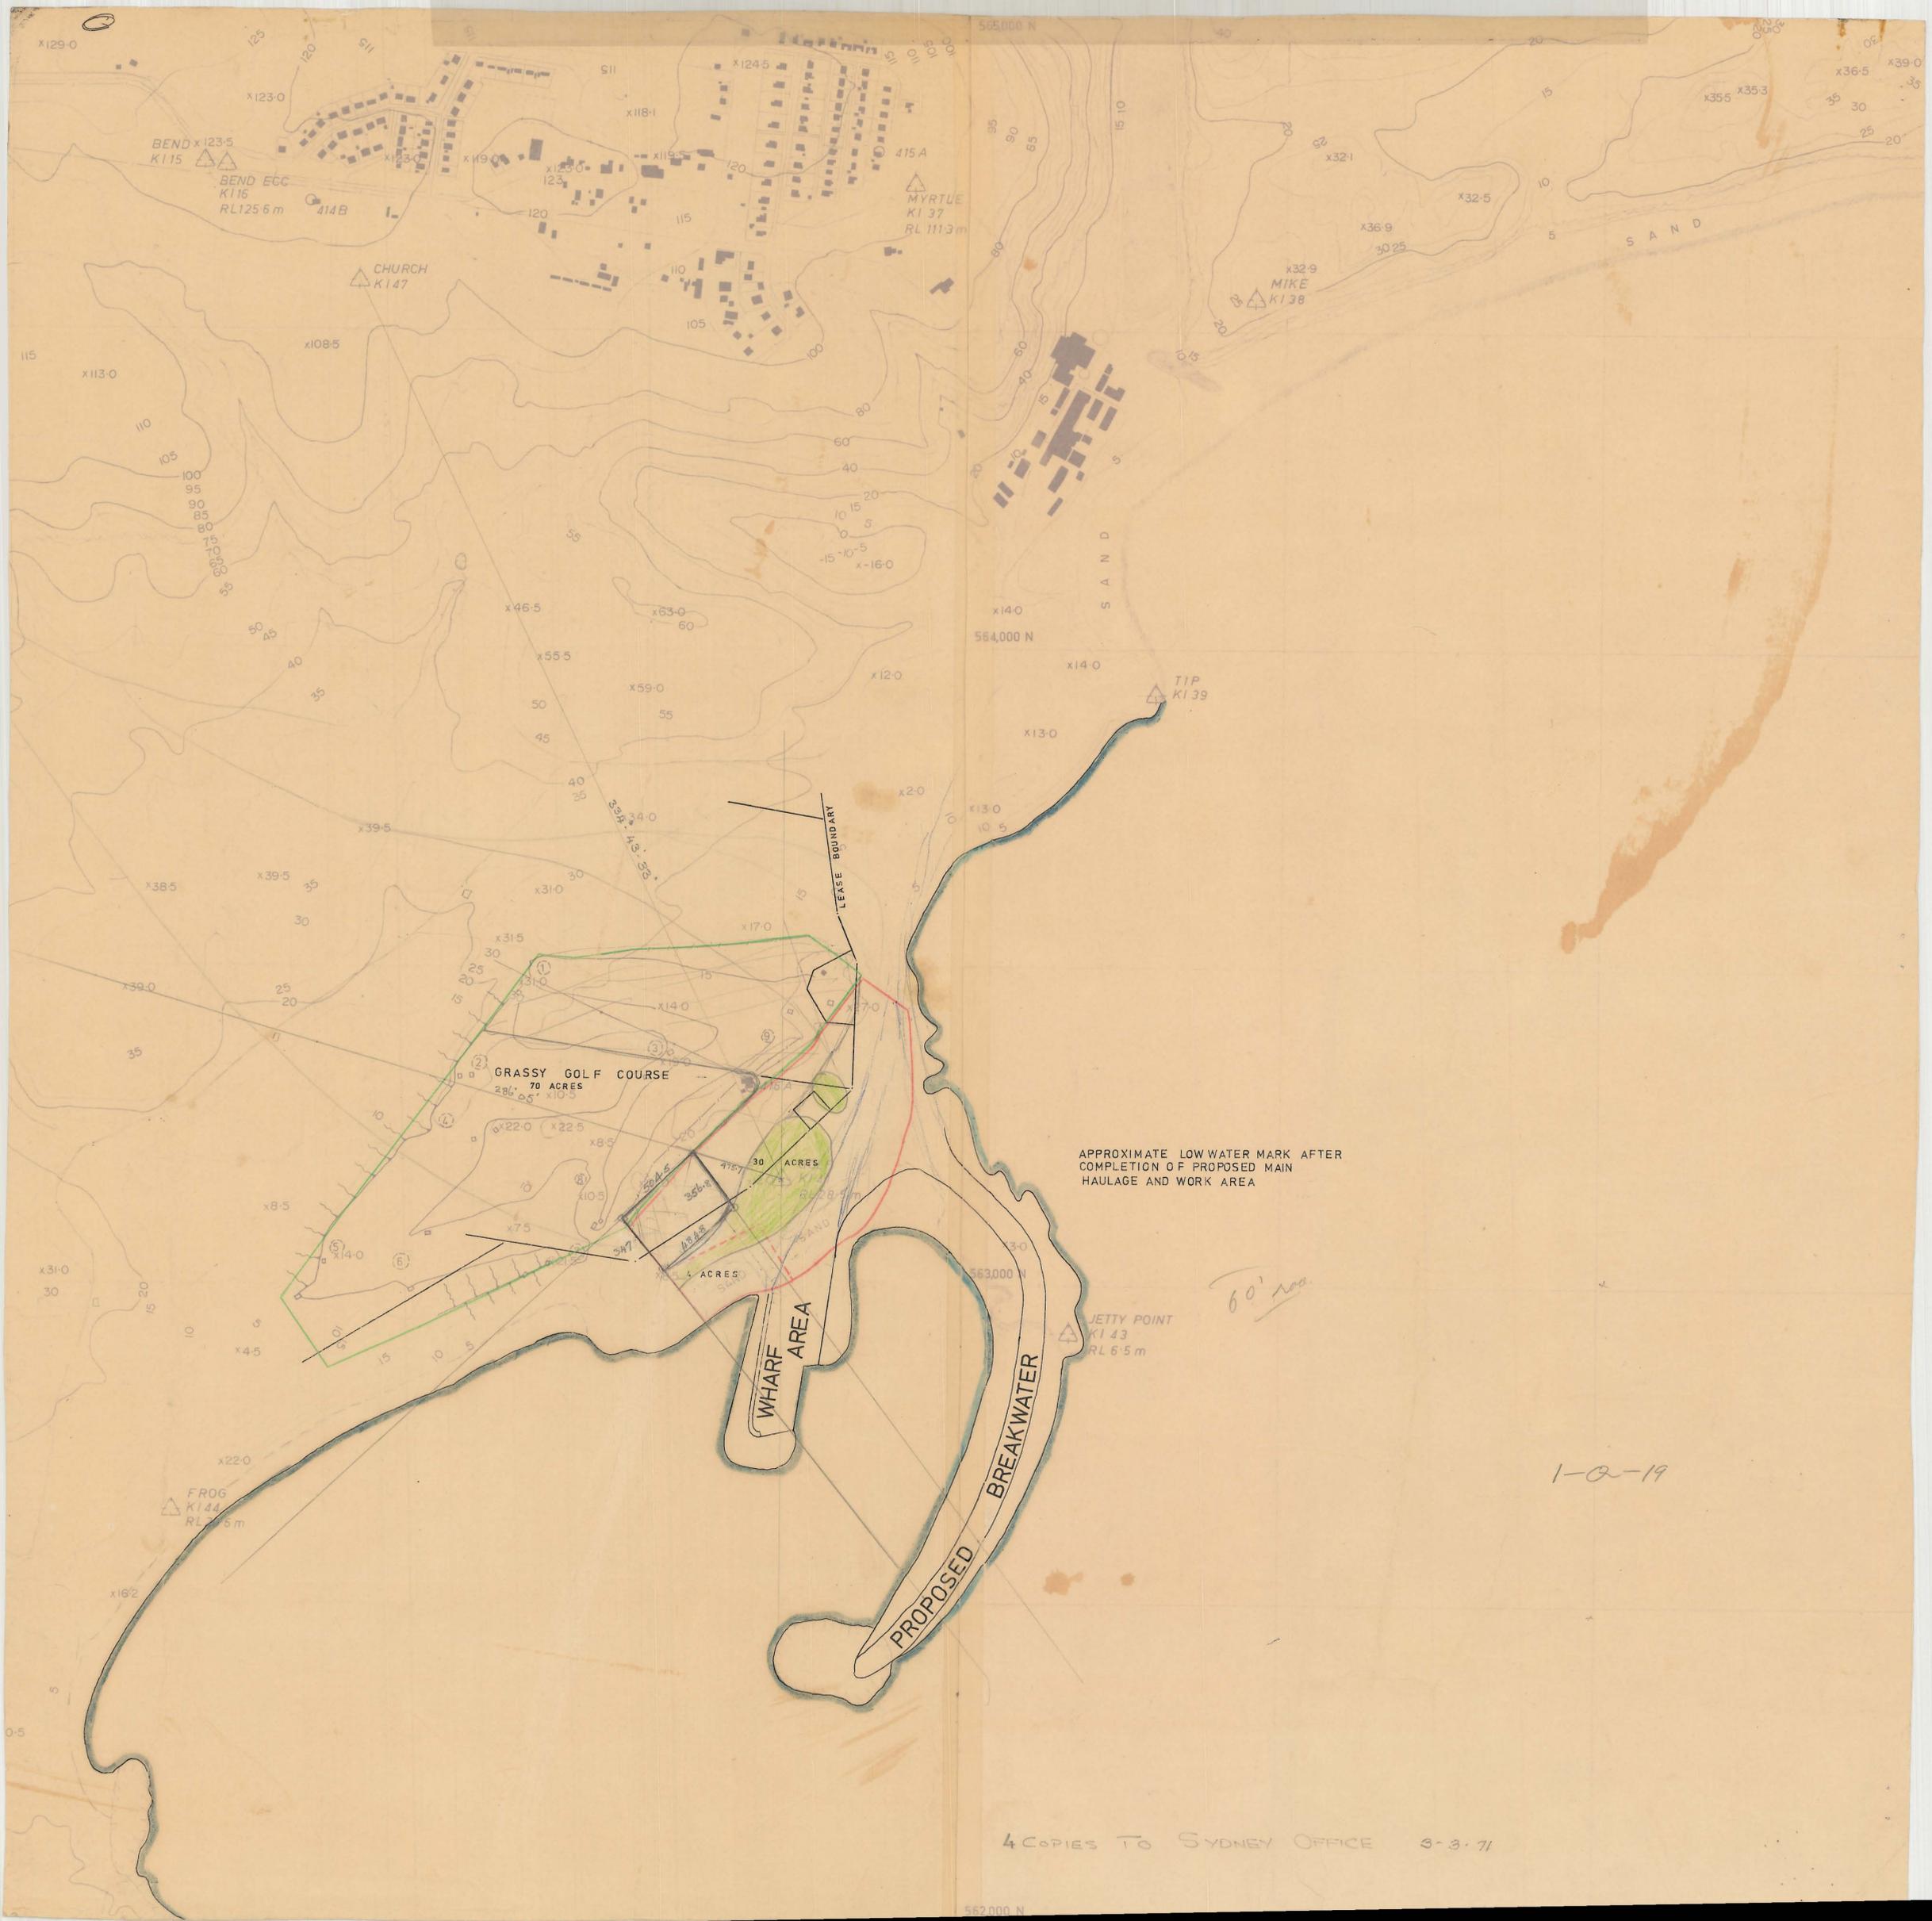

APPROXIMATE LOW WATER MARK AFTER COMPLETION OF PROPOSED MAIN HAULAGE AND WORK AREA

60' sea

1-2-19

4 COPIES TO SYDNEY OFFICE 3-3-71