


0374-3602b

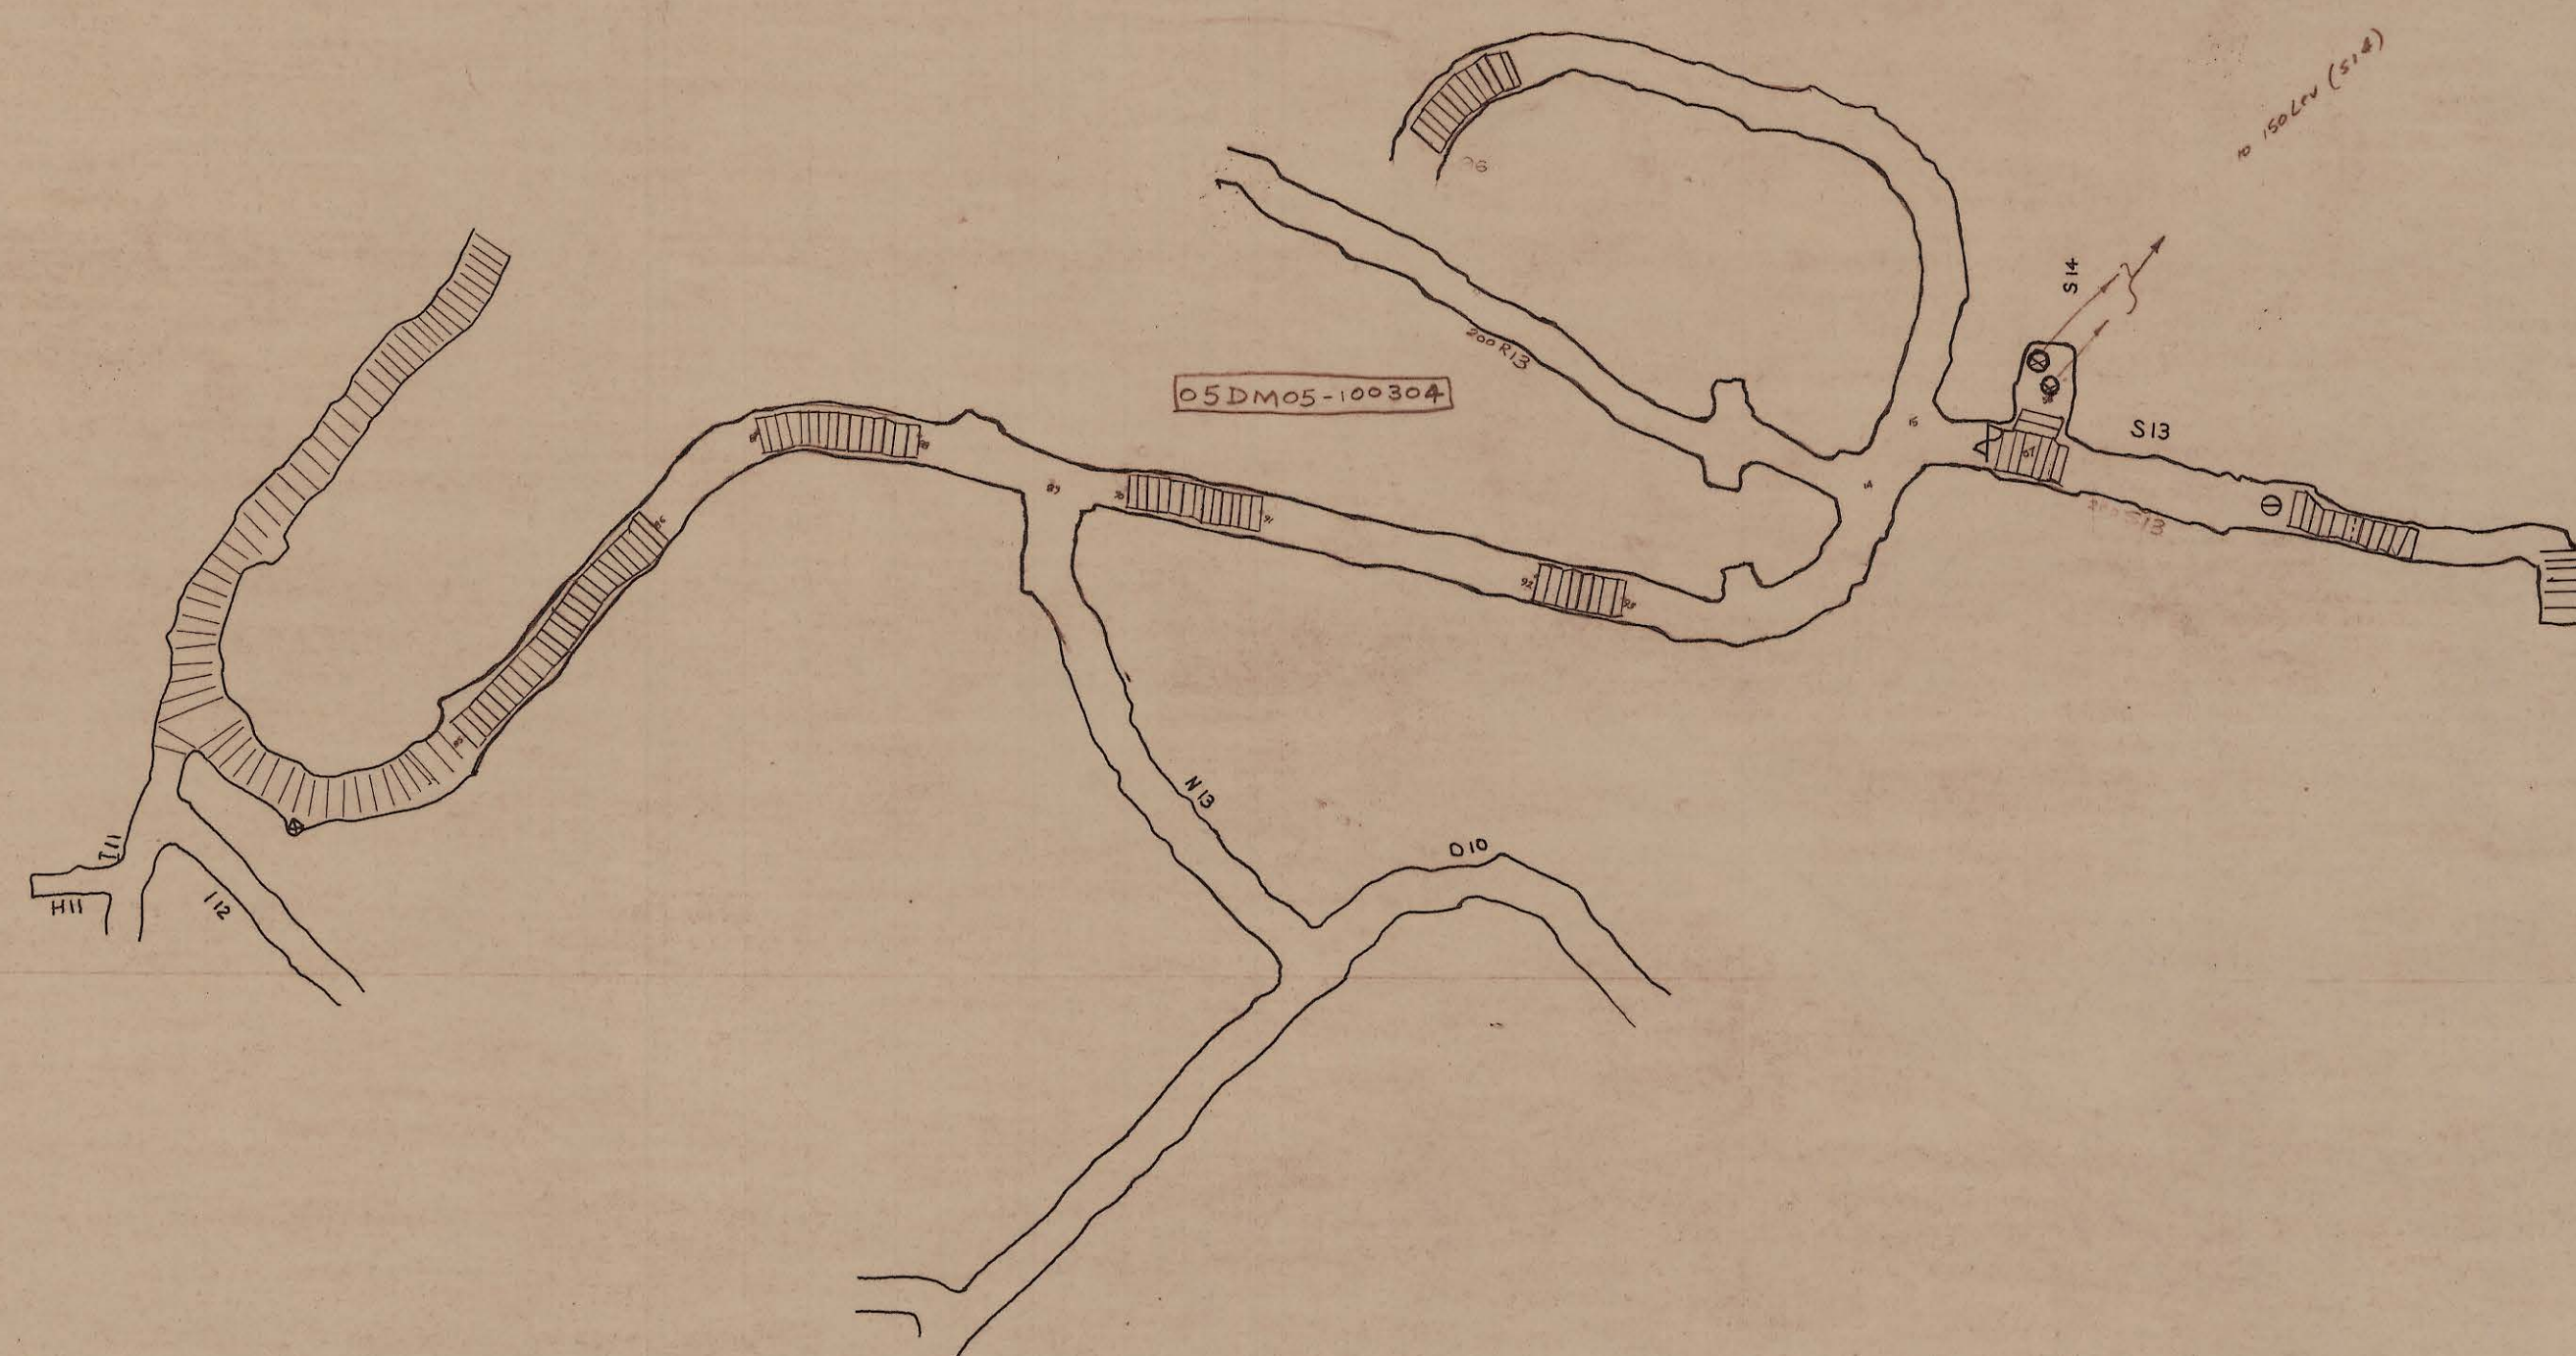

PLAN NUMBER
05DM05-100404

north