


5 cm

0374\_3632



Original position of Buoys

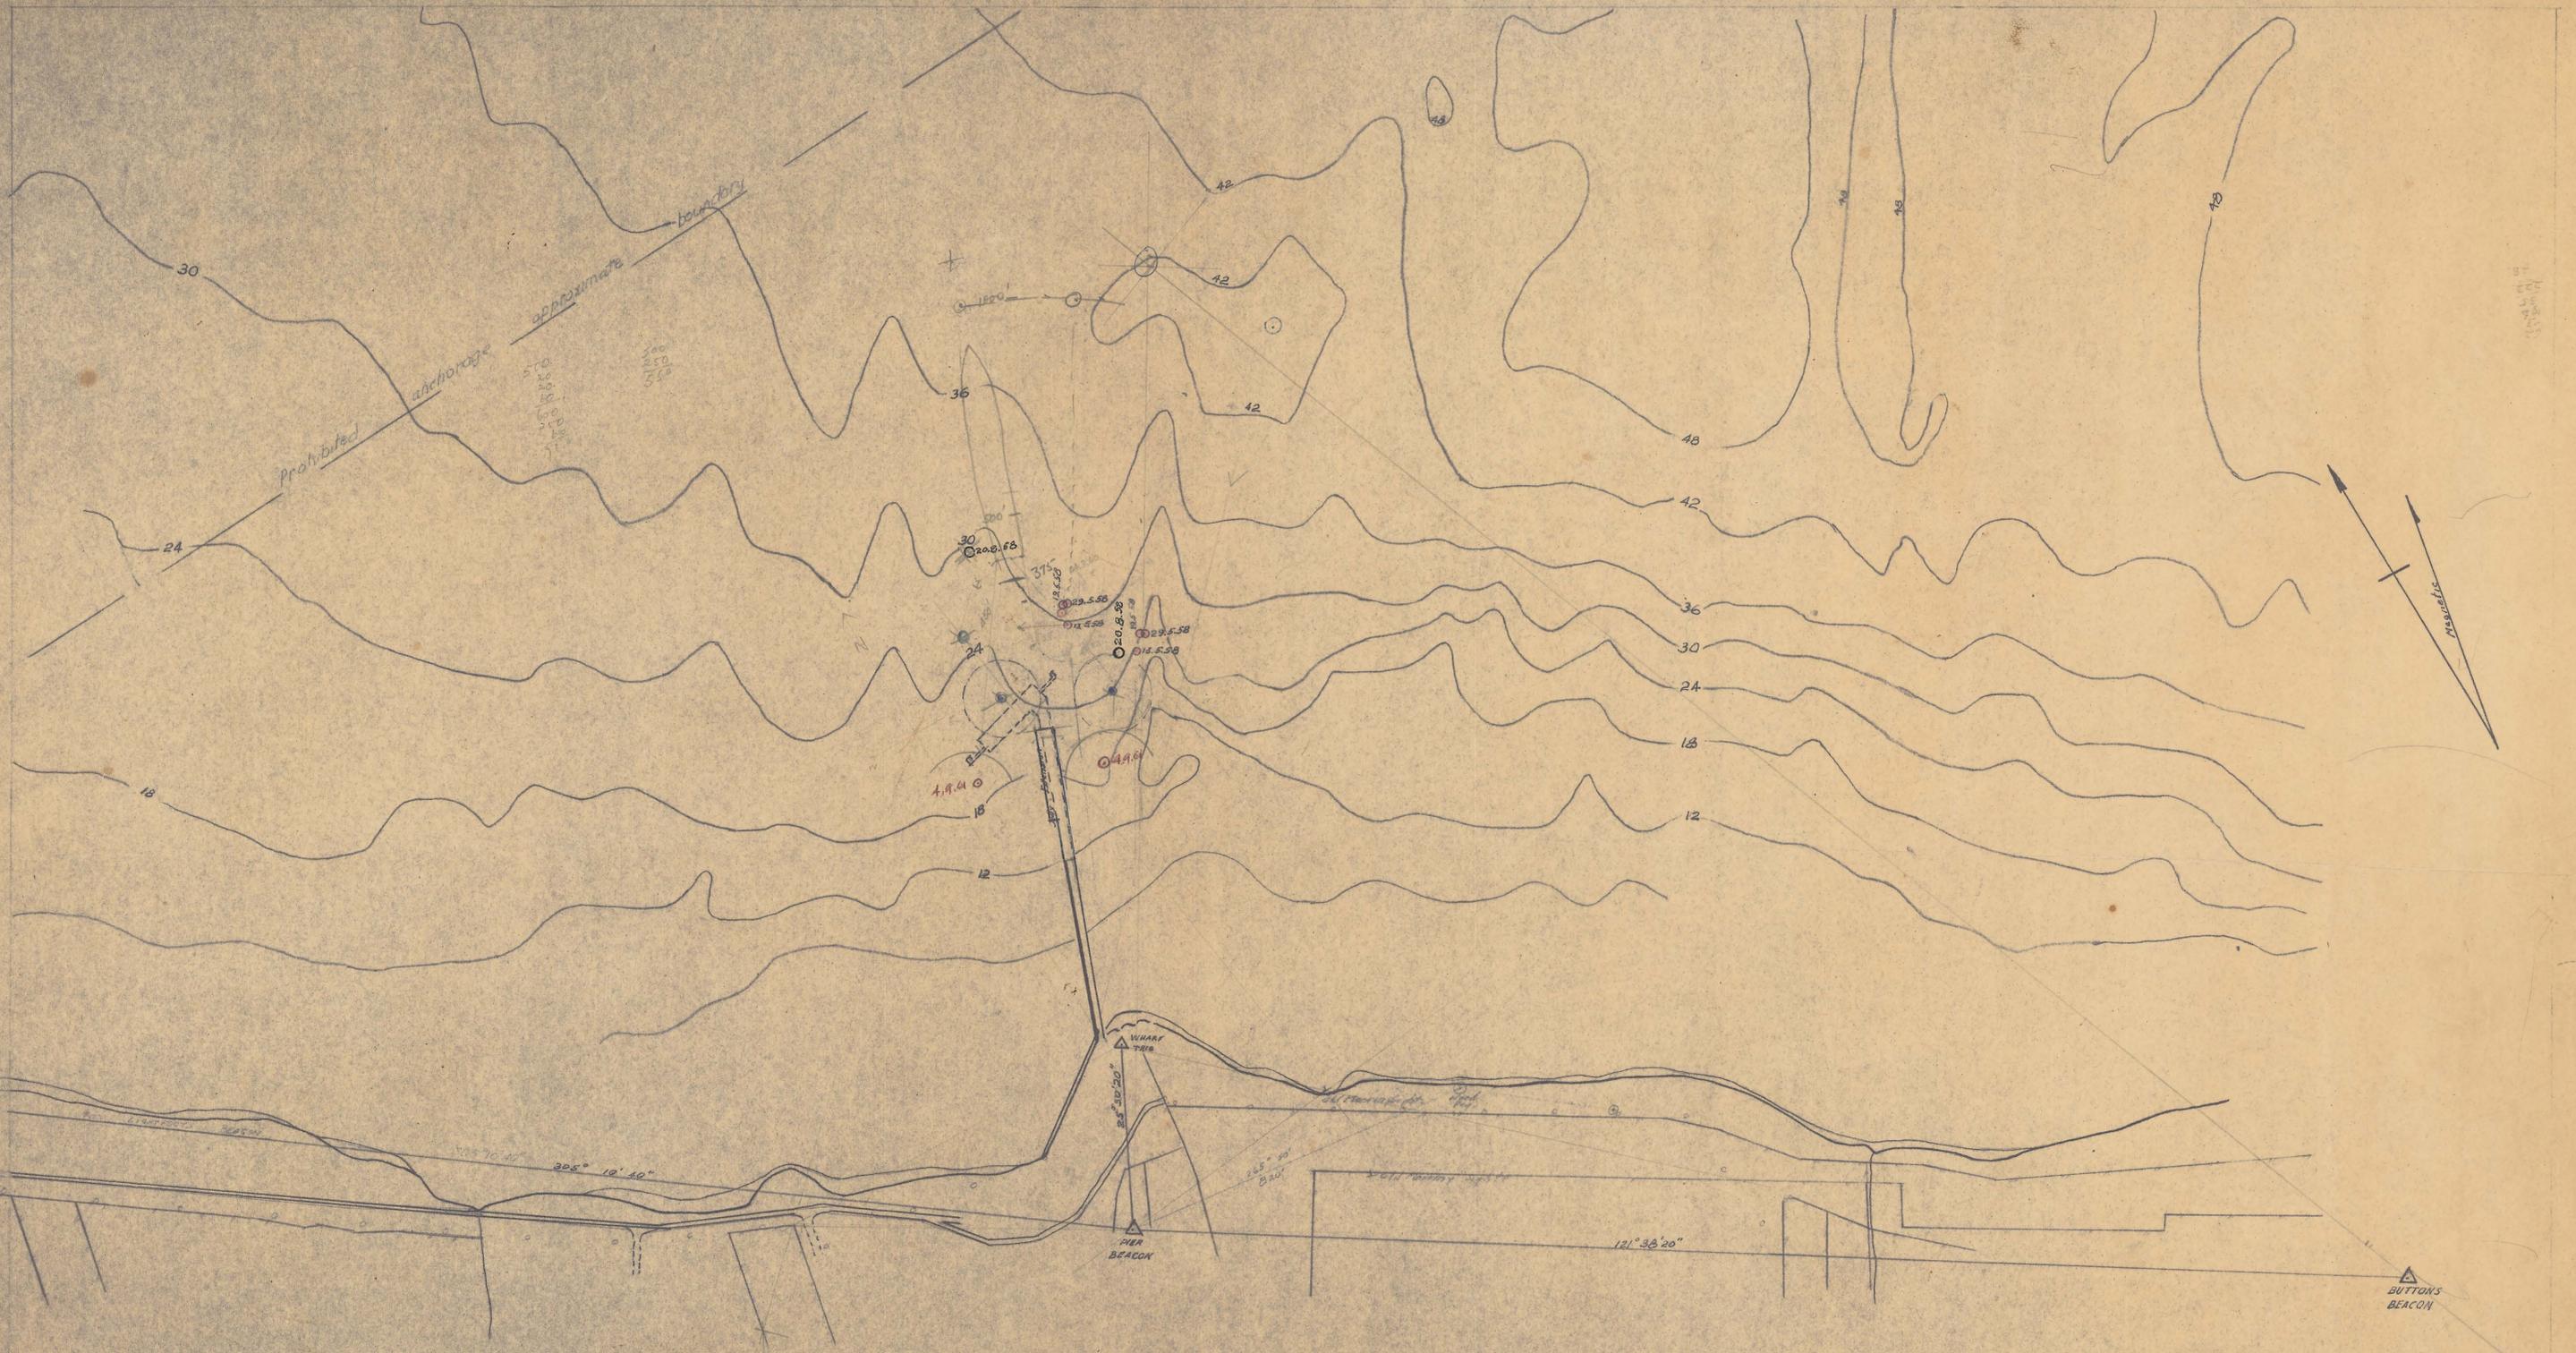

Present position of Buoys



Contours from echo sounding survey W. Jones '53. depths feet

|                                  |  |
|----------------------------------|--|
| KING ISLAND SCHEELITE 1947 LTD   |  |
| NARACOOPA JETTY                  |  |
| POSITION OF TANKER MOORING BUOYS |  |
| JUNE 1958                        |  |
| SCALE 1 INCH = 200 FEET          |  |
| DRAWN                            |  |
|                                  |  |