


0374_3634

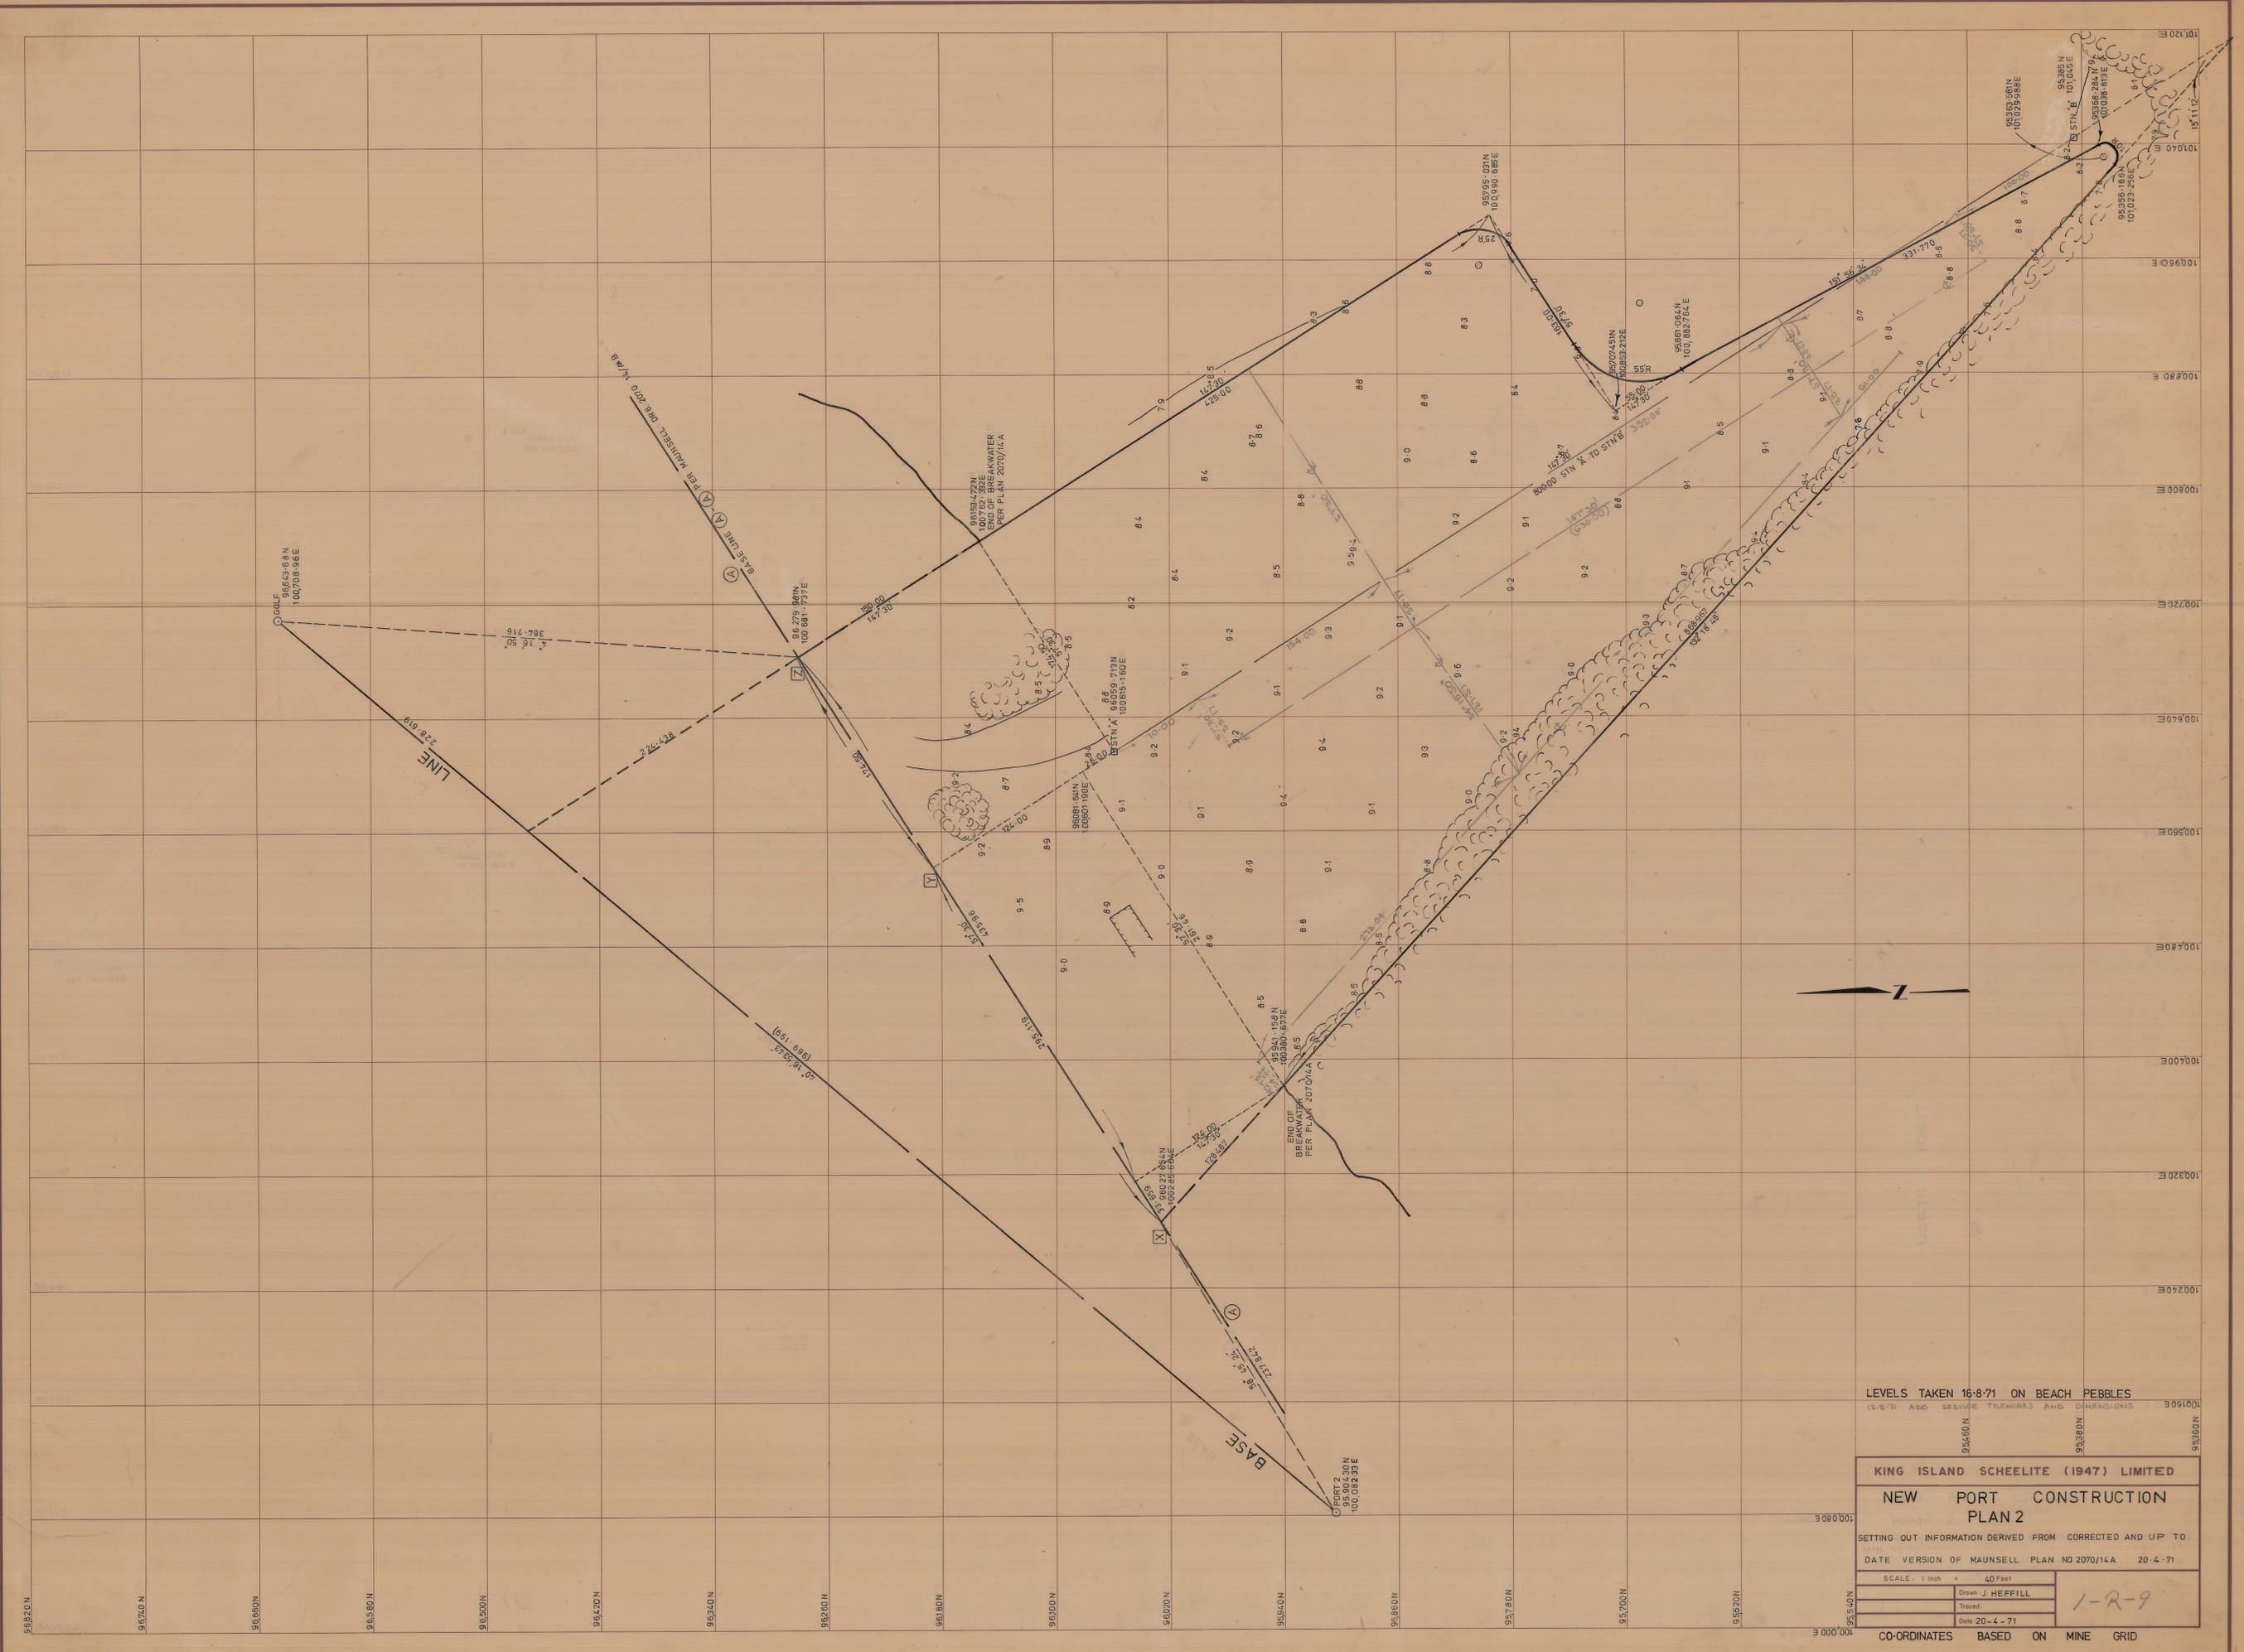

LEVELS TAKEN 16-8-71 ON BEACH PEBBLES

14.5" ADD 8.5" TO ALL DIMENSIONS

95460 N 95380 N

KING ISLAND SCHEELITE (1947) LIMITED

NEW PORT CONSTRUCTION
PLAN 2

SETTING OUT INFORMATION DERIVED FROM CORRECTED AND UP TO DATE

DATE VERSION OF MAUNSELL PLAN NO 2070/14A 20-7-71

SCALE: 1 inch = 40 Feet	1-R-9
Drawn: J. HEFFILL	
Date: 20-4-71	

CO-ORDINATES BASED ON MINE GRID

Handwritten notes: "MUS" and "1-1-10 (w) 1/25"