


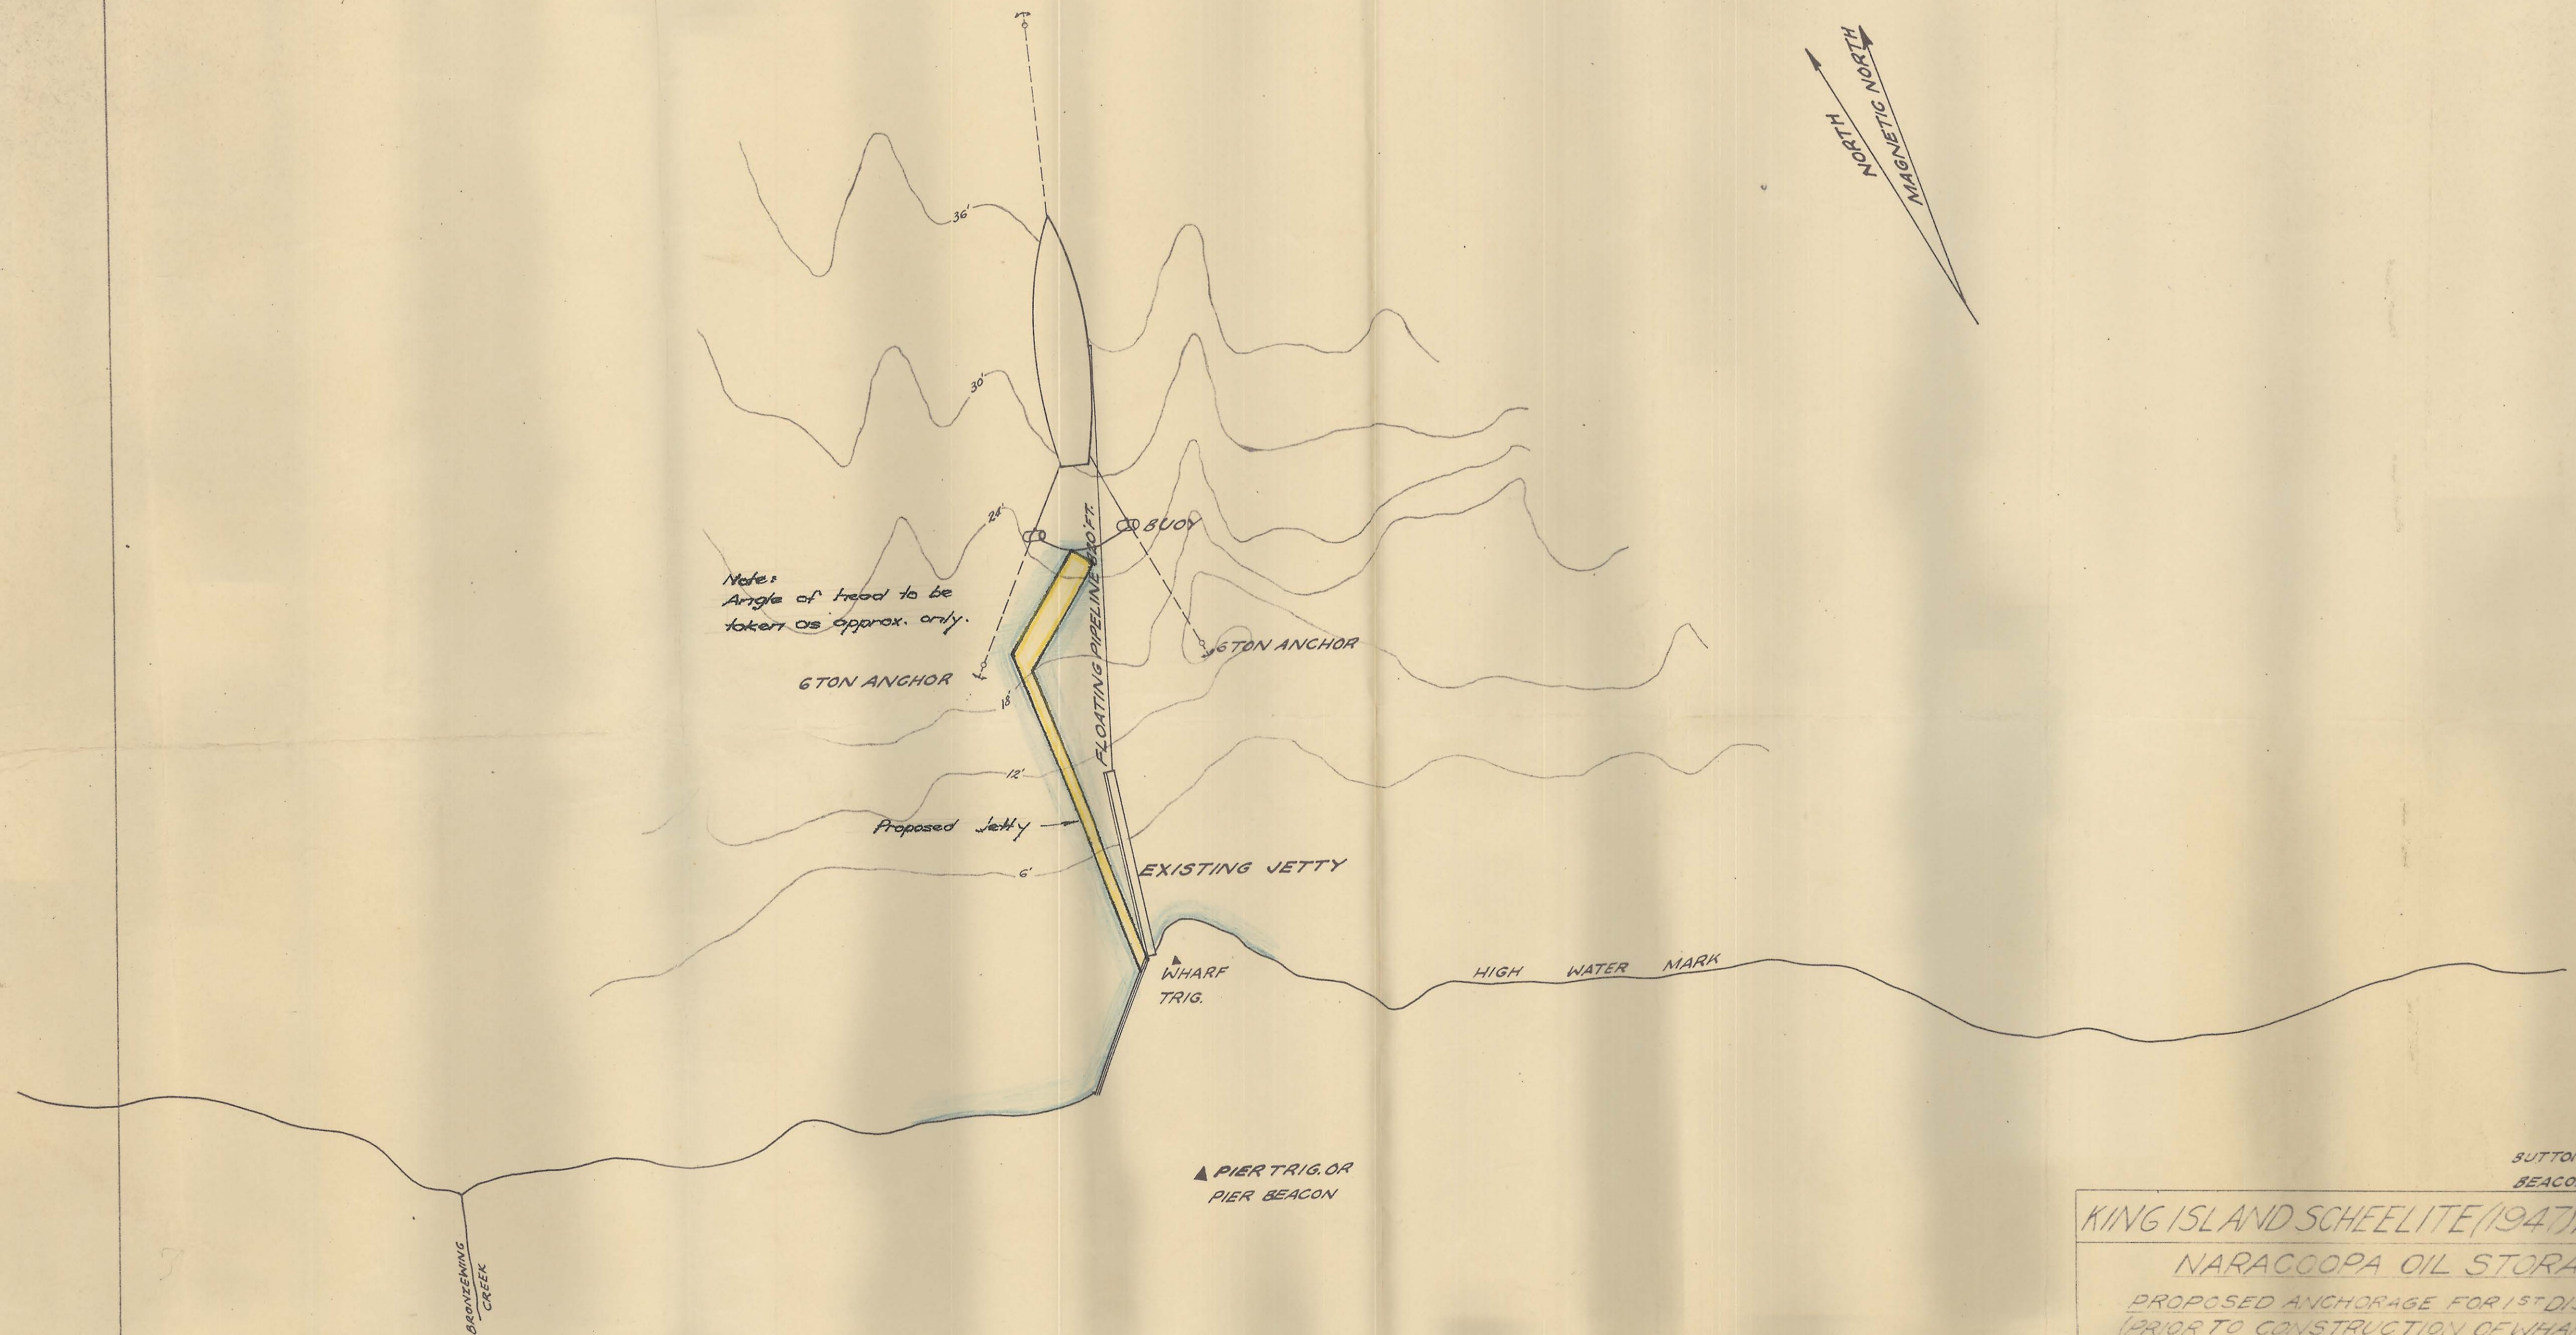

BUTTON'S
BEACON.

NARACOOPA OIL STORAGE

PROPOSED ANCHORAGE FOR 1ST DISCHARGE
(PRIOR TO CONSTRUCTION OF WHARF)

SCALE - 200 FT = 1 IN

JOB NO	DRAWN	RHB
APPROVED	DATE	12-1-54

C 388