


0374_3656

5 cm




SECTION 1

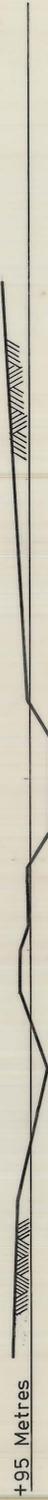

SECTION 2



SECTION 3

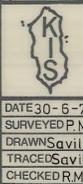

KING ISLAND SCHEELITE LTD.

Scale 1:500 No 1-

DATE 30-6-72
 SURVEYED P.M.
 DRAWN S. Aville
 TRACED S. Aville
 CHECKED R.M.H.

BOX CUT
 SECTIONS 1, 2 & 3.
 PERIOD 13.

1-13-56