

5 cm


0374_3669

RL. 13.00



KING ISLAND SCHEELITE LTD.

DATE 12 Feb 74
SURVEYED JC
DRAWN JC
TRACED
CHECKED

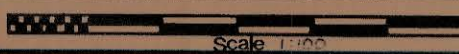

Scale 1:100

No 1-

SECTION 3