



SAND DUMP SECTIONS

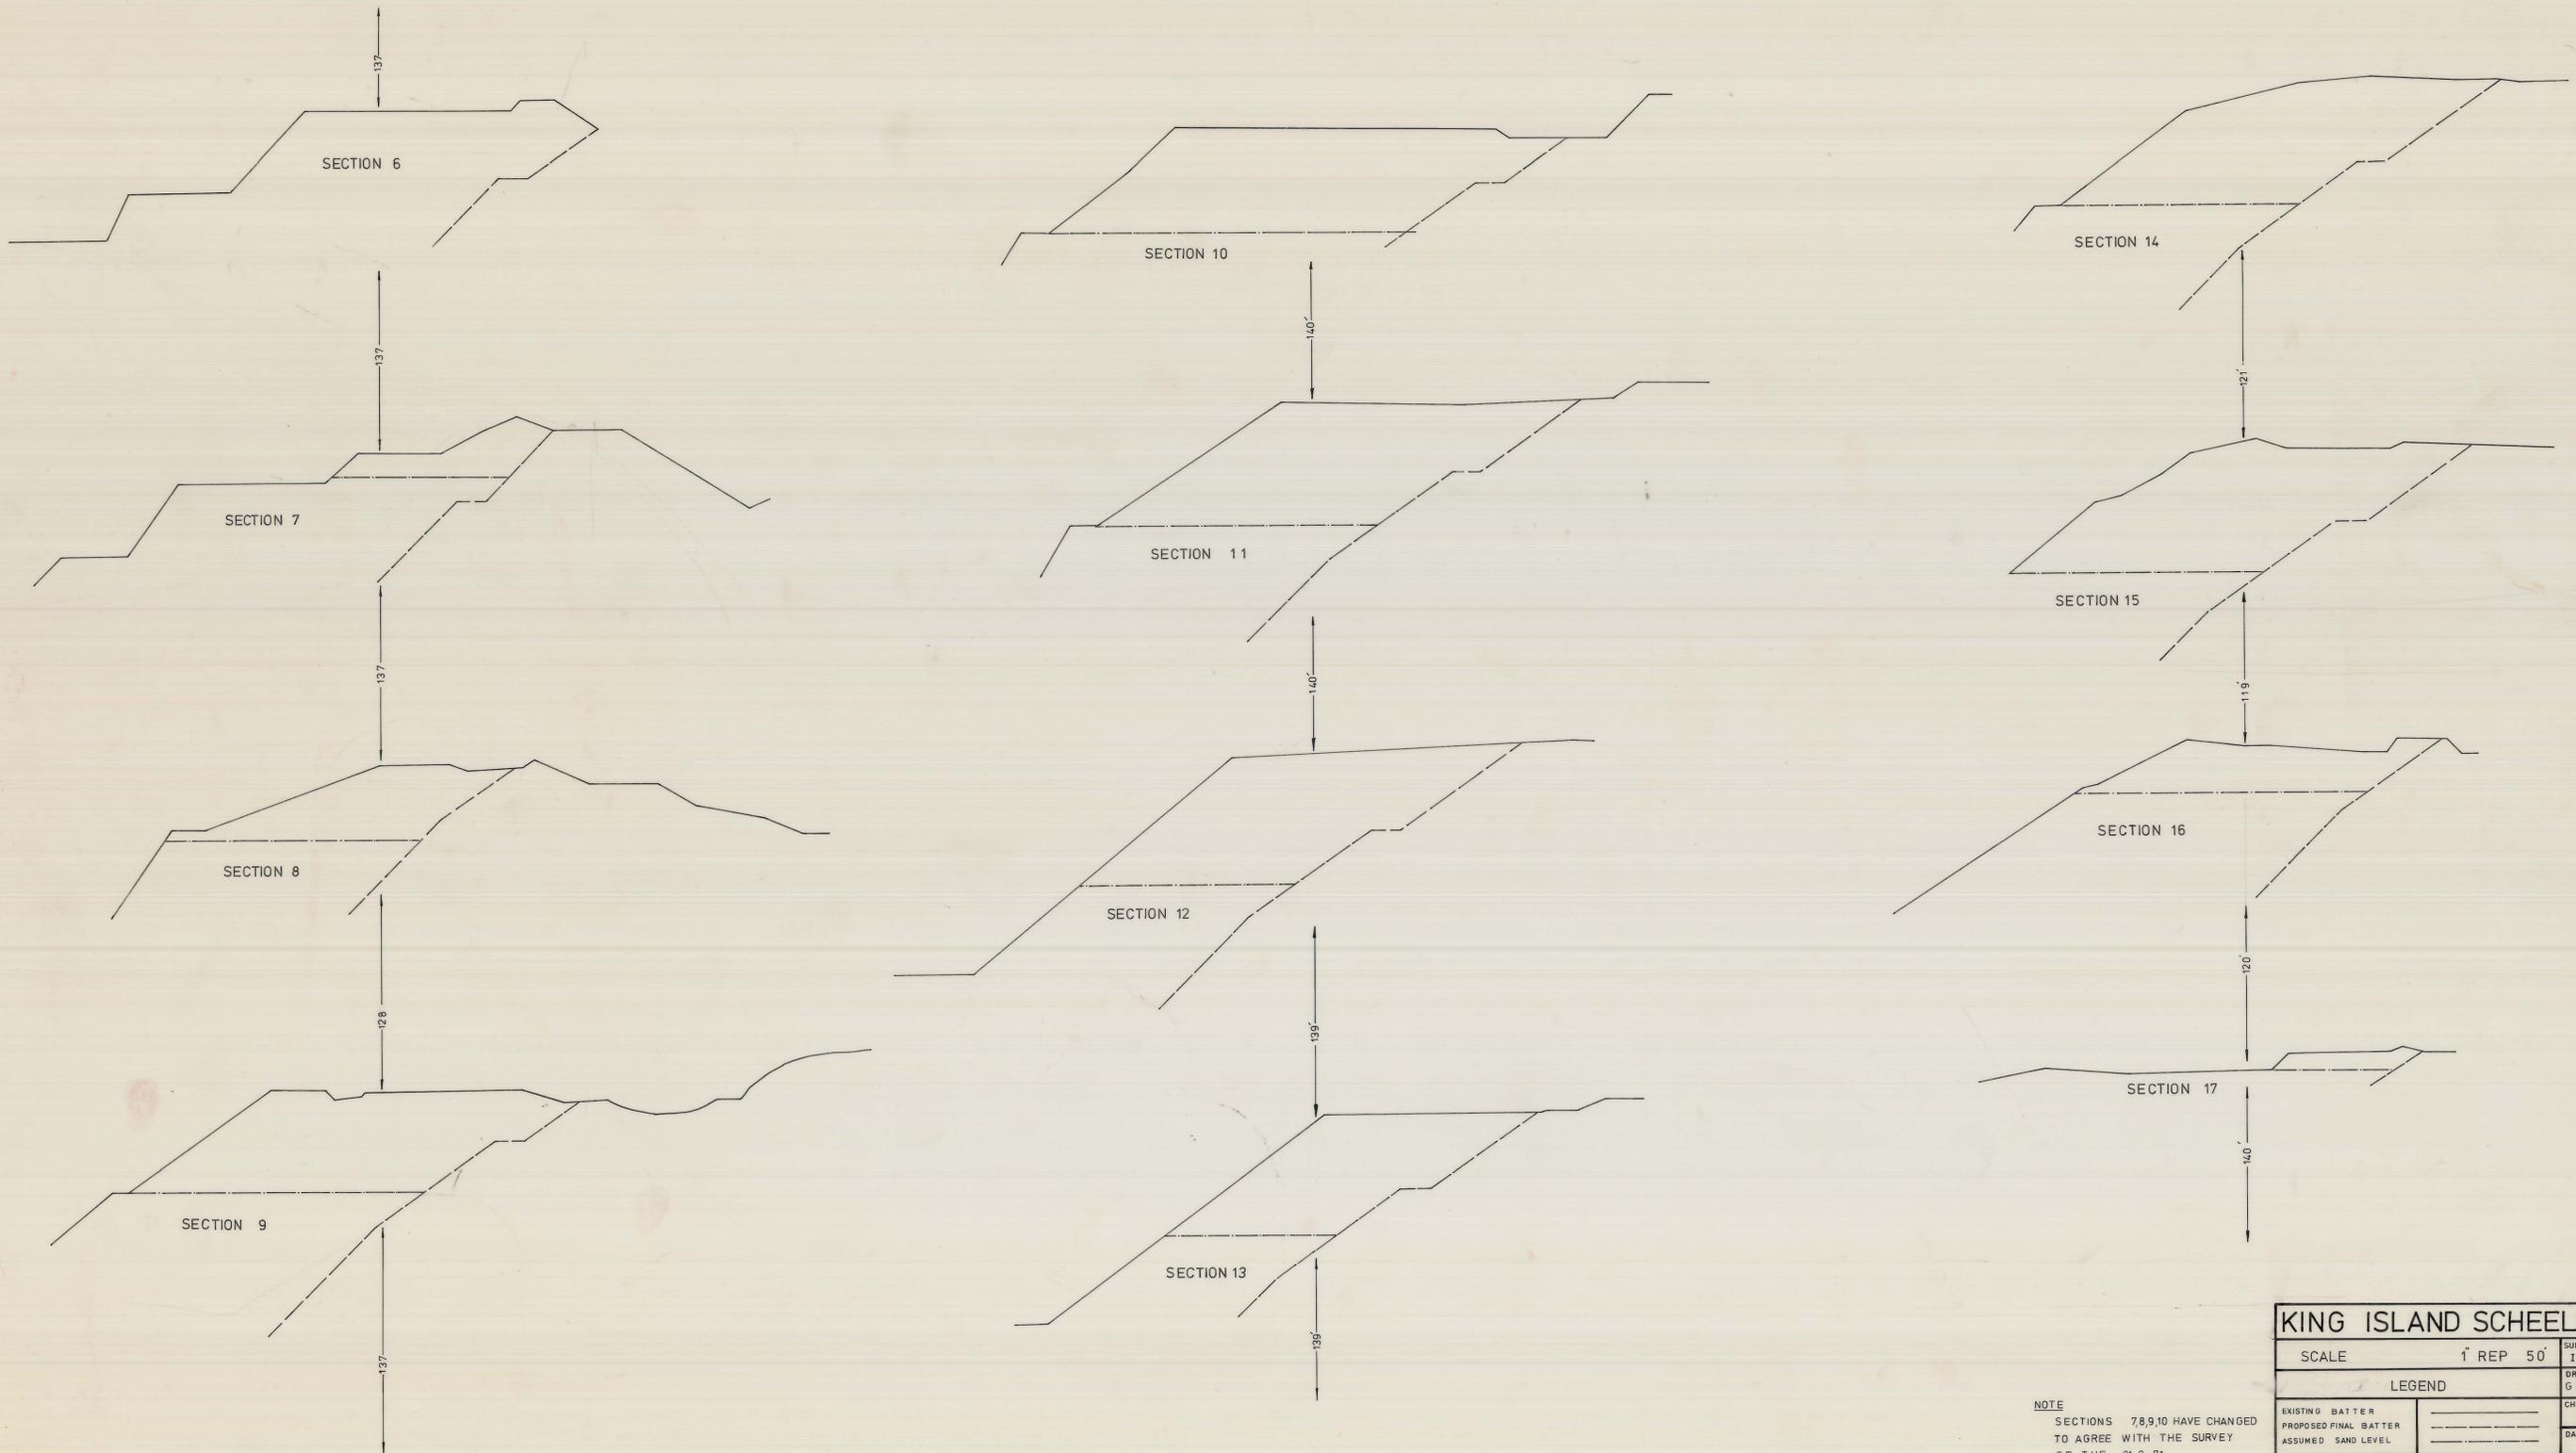

NOTE
SECTIONS 7,8,9,10 HAVE CHANGED
TO AGREE WITH THE SURVEY
OF THE 31-3-71

KING ISLAND SCHEELITE LTD		SURVEYED I. COUGLE
SCALE	1" REP 50'	DRAWN G HAMMERSTEIN
LEGEND		CHECKED R HARTH
EXISTING BATTER	_____	DATE 20-4-71
PROPOSED FINAL BATTER	_____	
ASSUMED SAND LEVEL	_____	
NOTE EAST END ROCHES SAND BEFORE STRIPPING BY ROCHES AND AFTER STRIPPING BY KING ISLAND SCHEELITE LTD.		

1-13-14

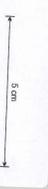

0374_3681