


0374 - 3684 b

5 cm

FOLD

HEWLETT-PACKARD  
9280-0180  
FOR USE ON HEWLETT-PACKARD RECORDERS

FOLD

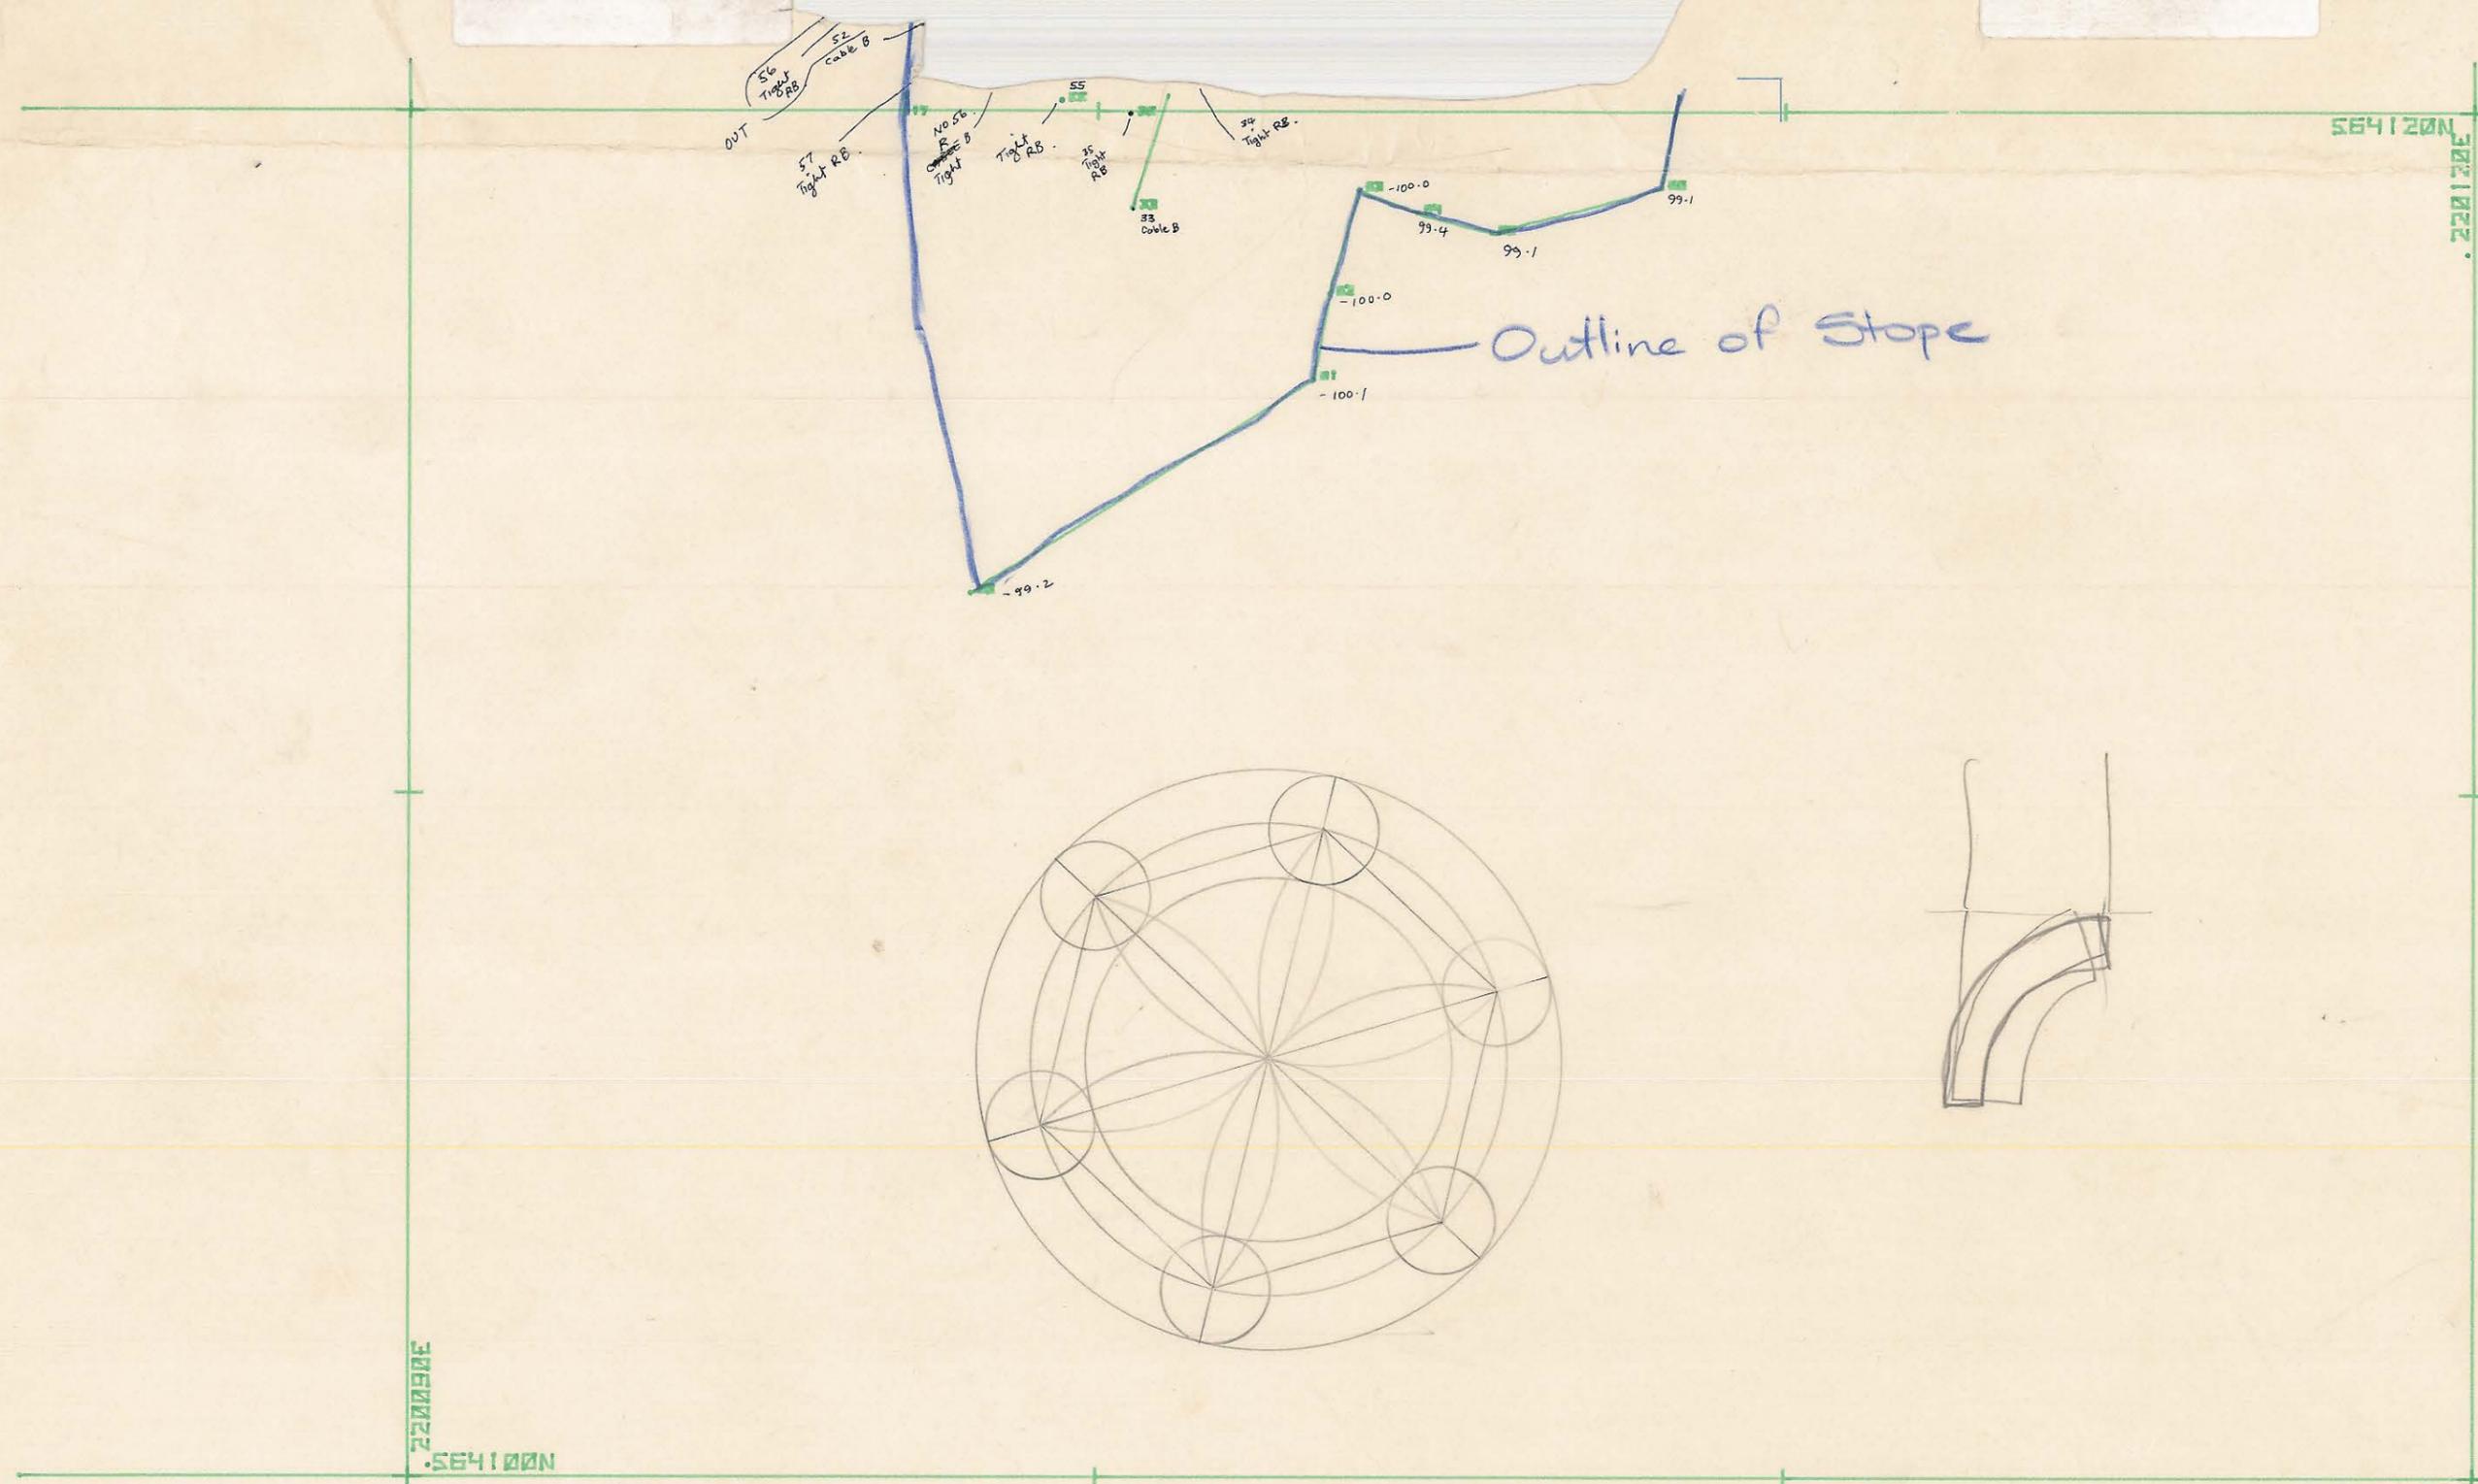

SCALE 1: 100 SHEET # 0

DOLPHIN **CENTRAL STOPE** FATALITY PLAN  
 FIELD WORK DONE TUE 23FEB82 BY JC/MD/GST/  
 PLOTTING DONE 1106 TUE 23FEB82 BY HSM  
 COORDS OF SNOTTY • LAT 564130.759, DEP 220103.586, TARG -58.790