


0374-3684 d

5 cm

FOLD
HEWLETT-PACKARD
9280-0180
FOR USE ON HEWLETT-PACKARD RECORDERS

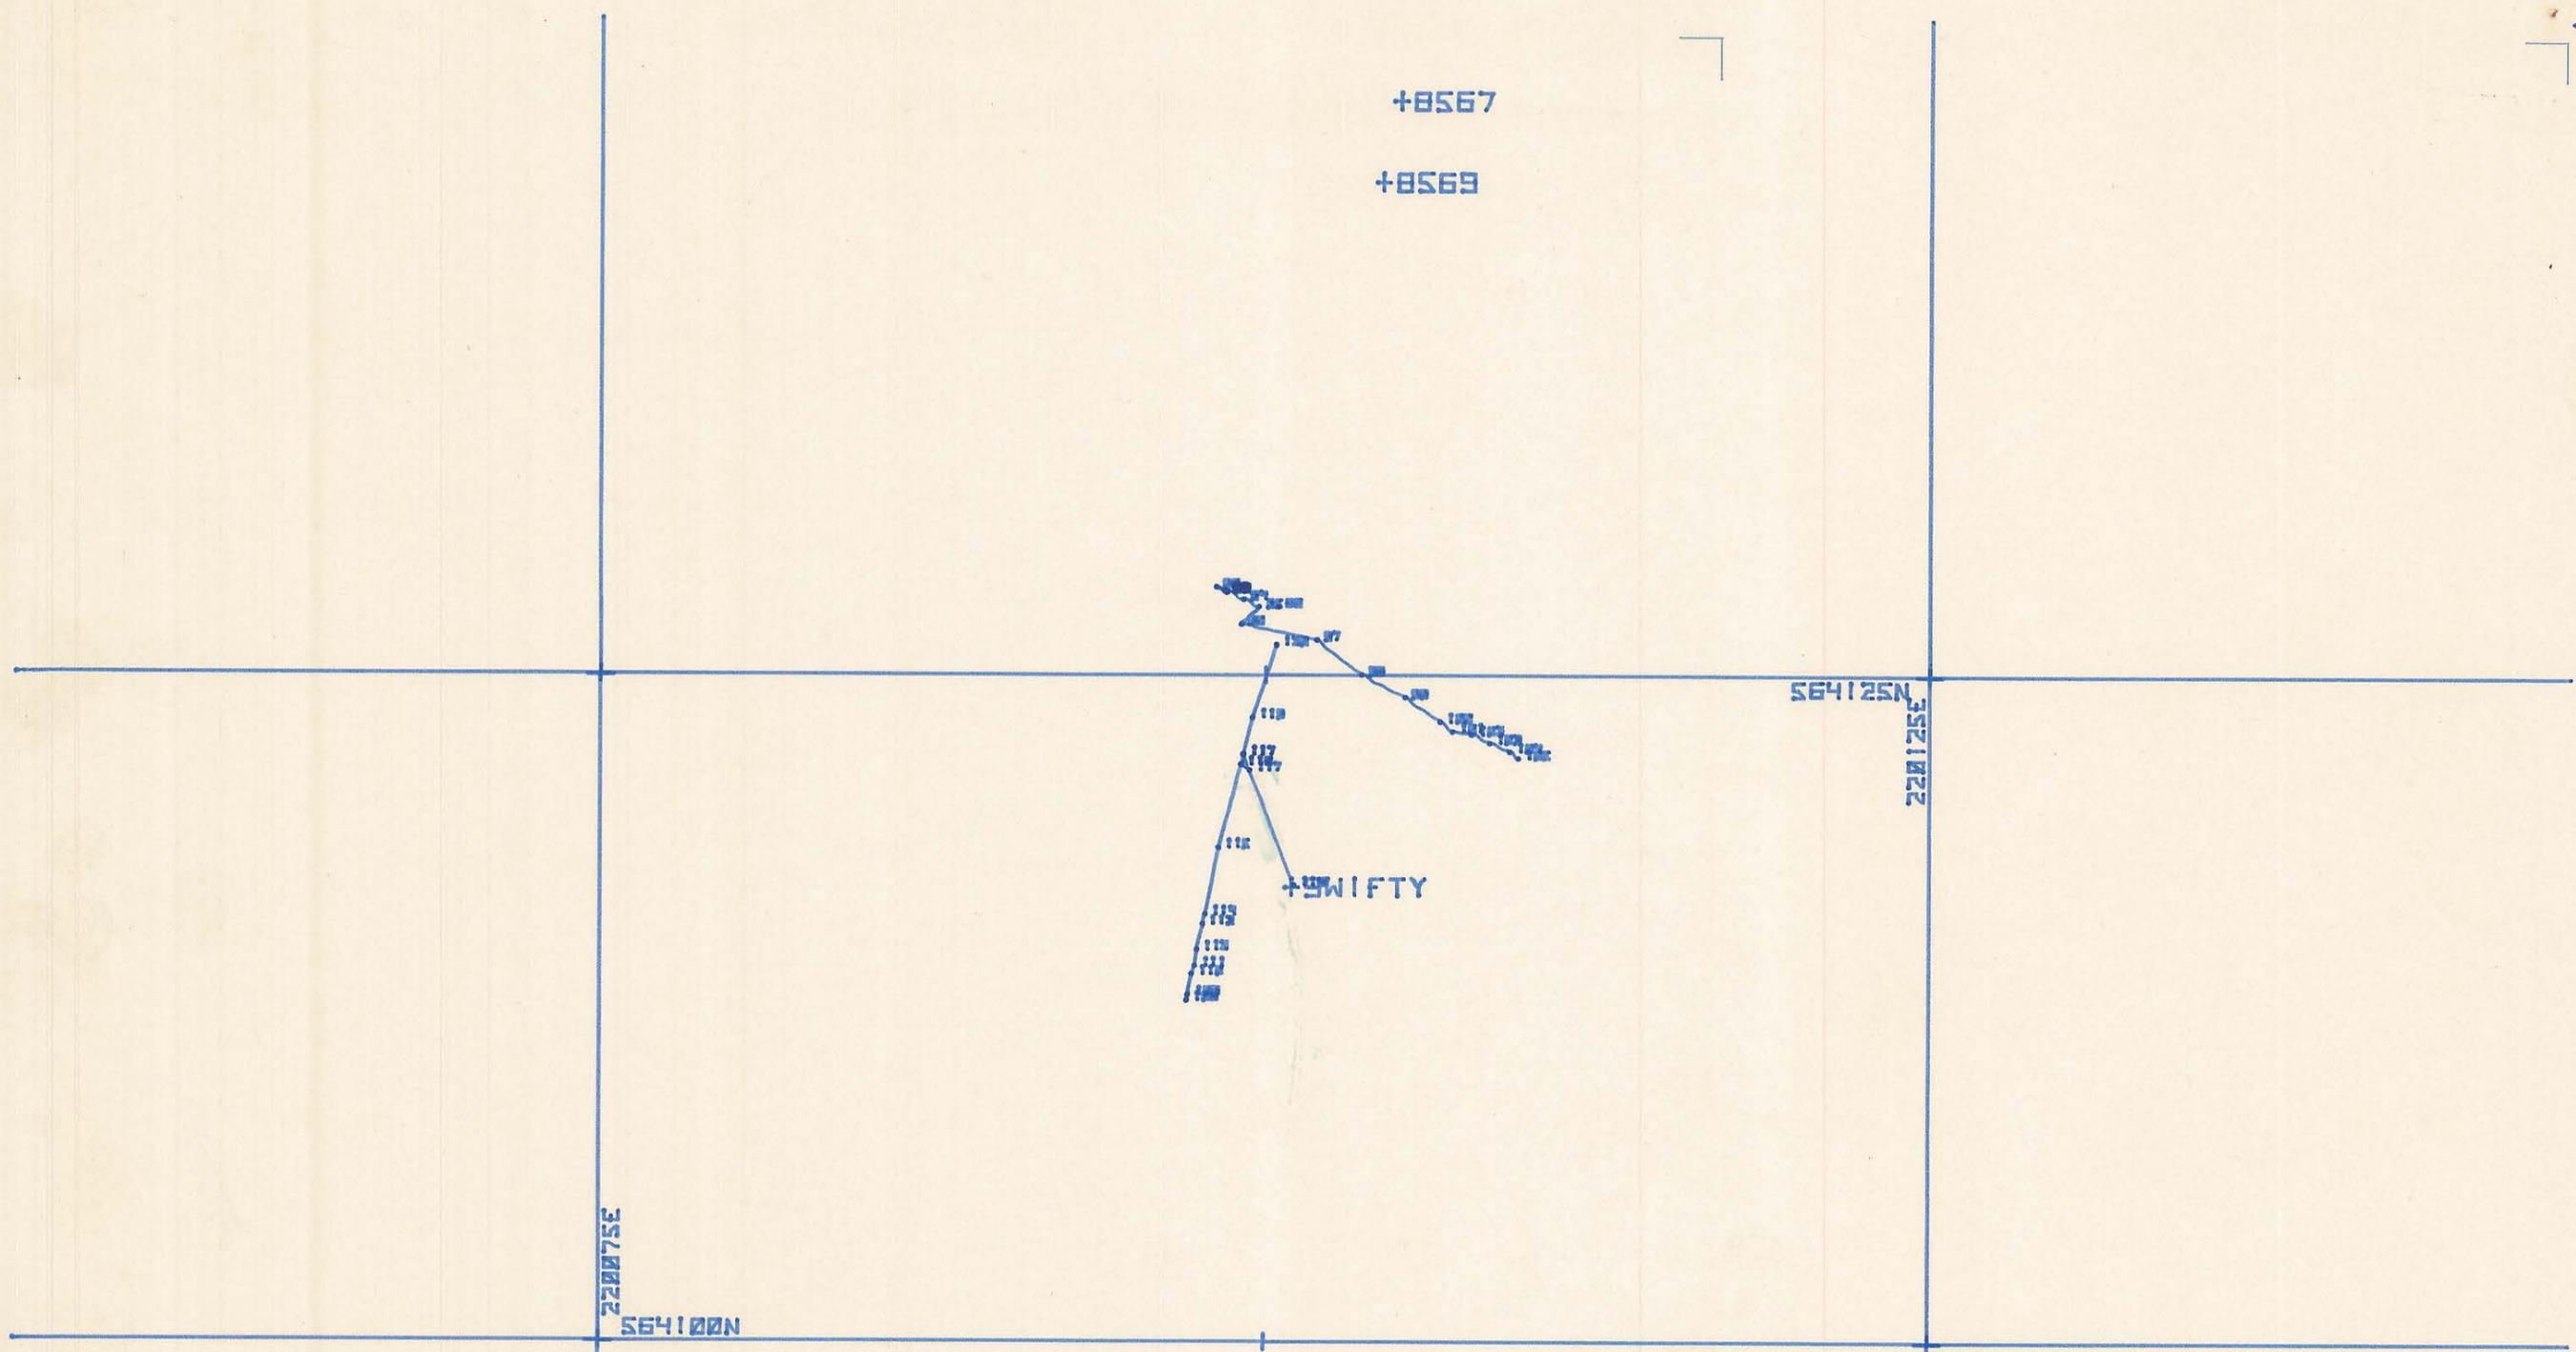

SCALE 1: 250 SHEET 4 of 4

DOLPHIN **CENTRAL STOPE** FATALITY PLAN

FIELD WORK DONE THU 25/2/82 BY MGN/MO/GST/
PLOTTING DONE 0800 FRI 26/2/82 BY MO
COORDS OF SWIFTY • LAT 564117.135, DEP 220101.100, TARK -94.283

FOLD