


FOLD

HEWLETT-PACKARD  
9260-0180  
FOR USE ON HEWLETT-PACKARD RECORDERS

FOLD

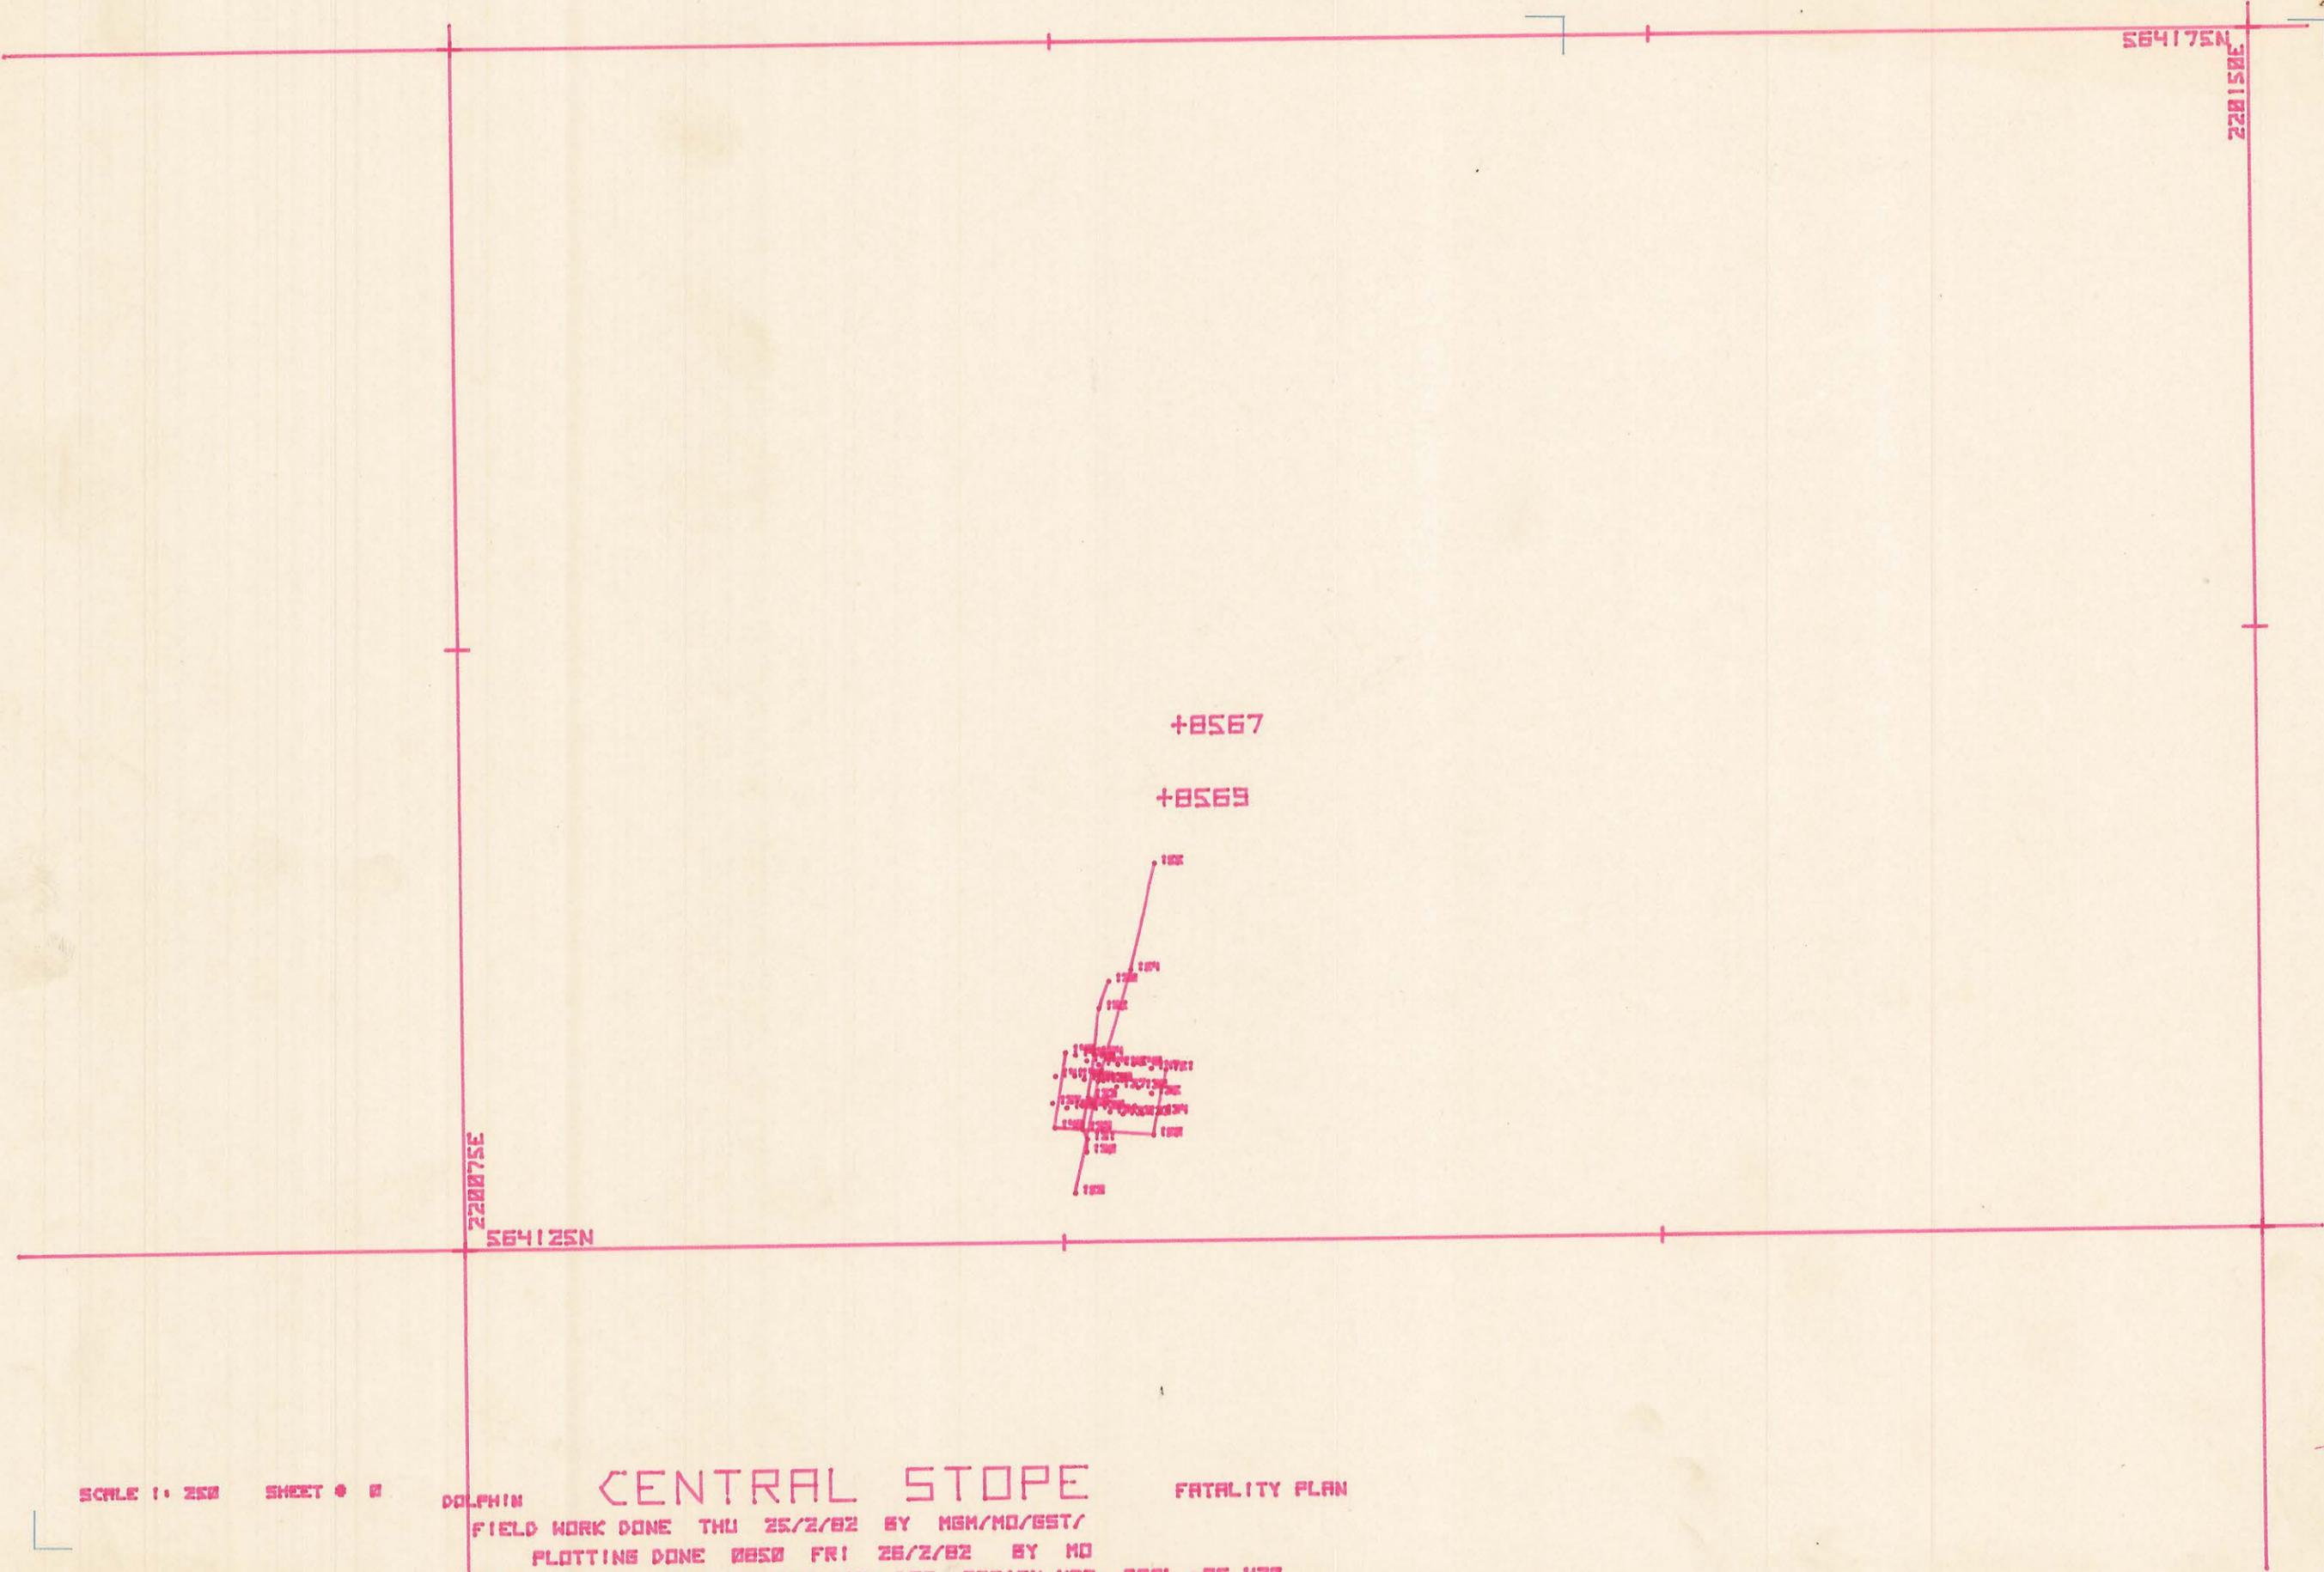

SCALE 1:250 SHEET 0 0

DOLPHIN **CENTRAL STOPE** FATALITY PLAN  
 FIELD WORK DONE THU 25/2/82 BY MGH/MO/GST/  
 PLOTTING DONE 0850 FRI 26/2/82 BY MO  
 COORDS OF 8569 • LAT 564143.513, DEP 220104.493, TARG -96.420