



0374-3684 F

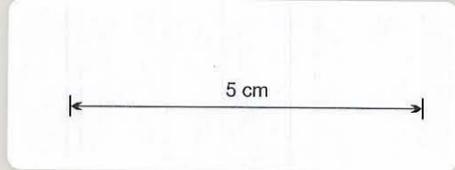

FOLD

HEWLETT-PACKARD
9280-0180
FOR USE ON HEWLETT-PACKARD RECORDERS

FOLD

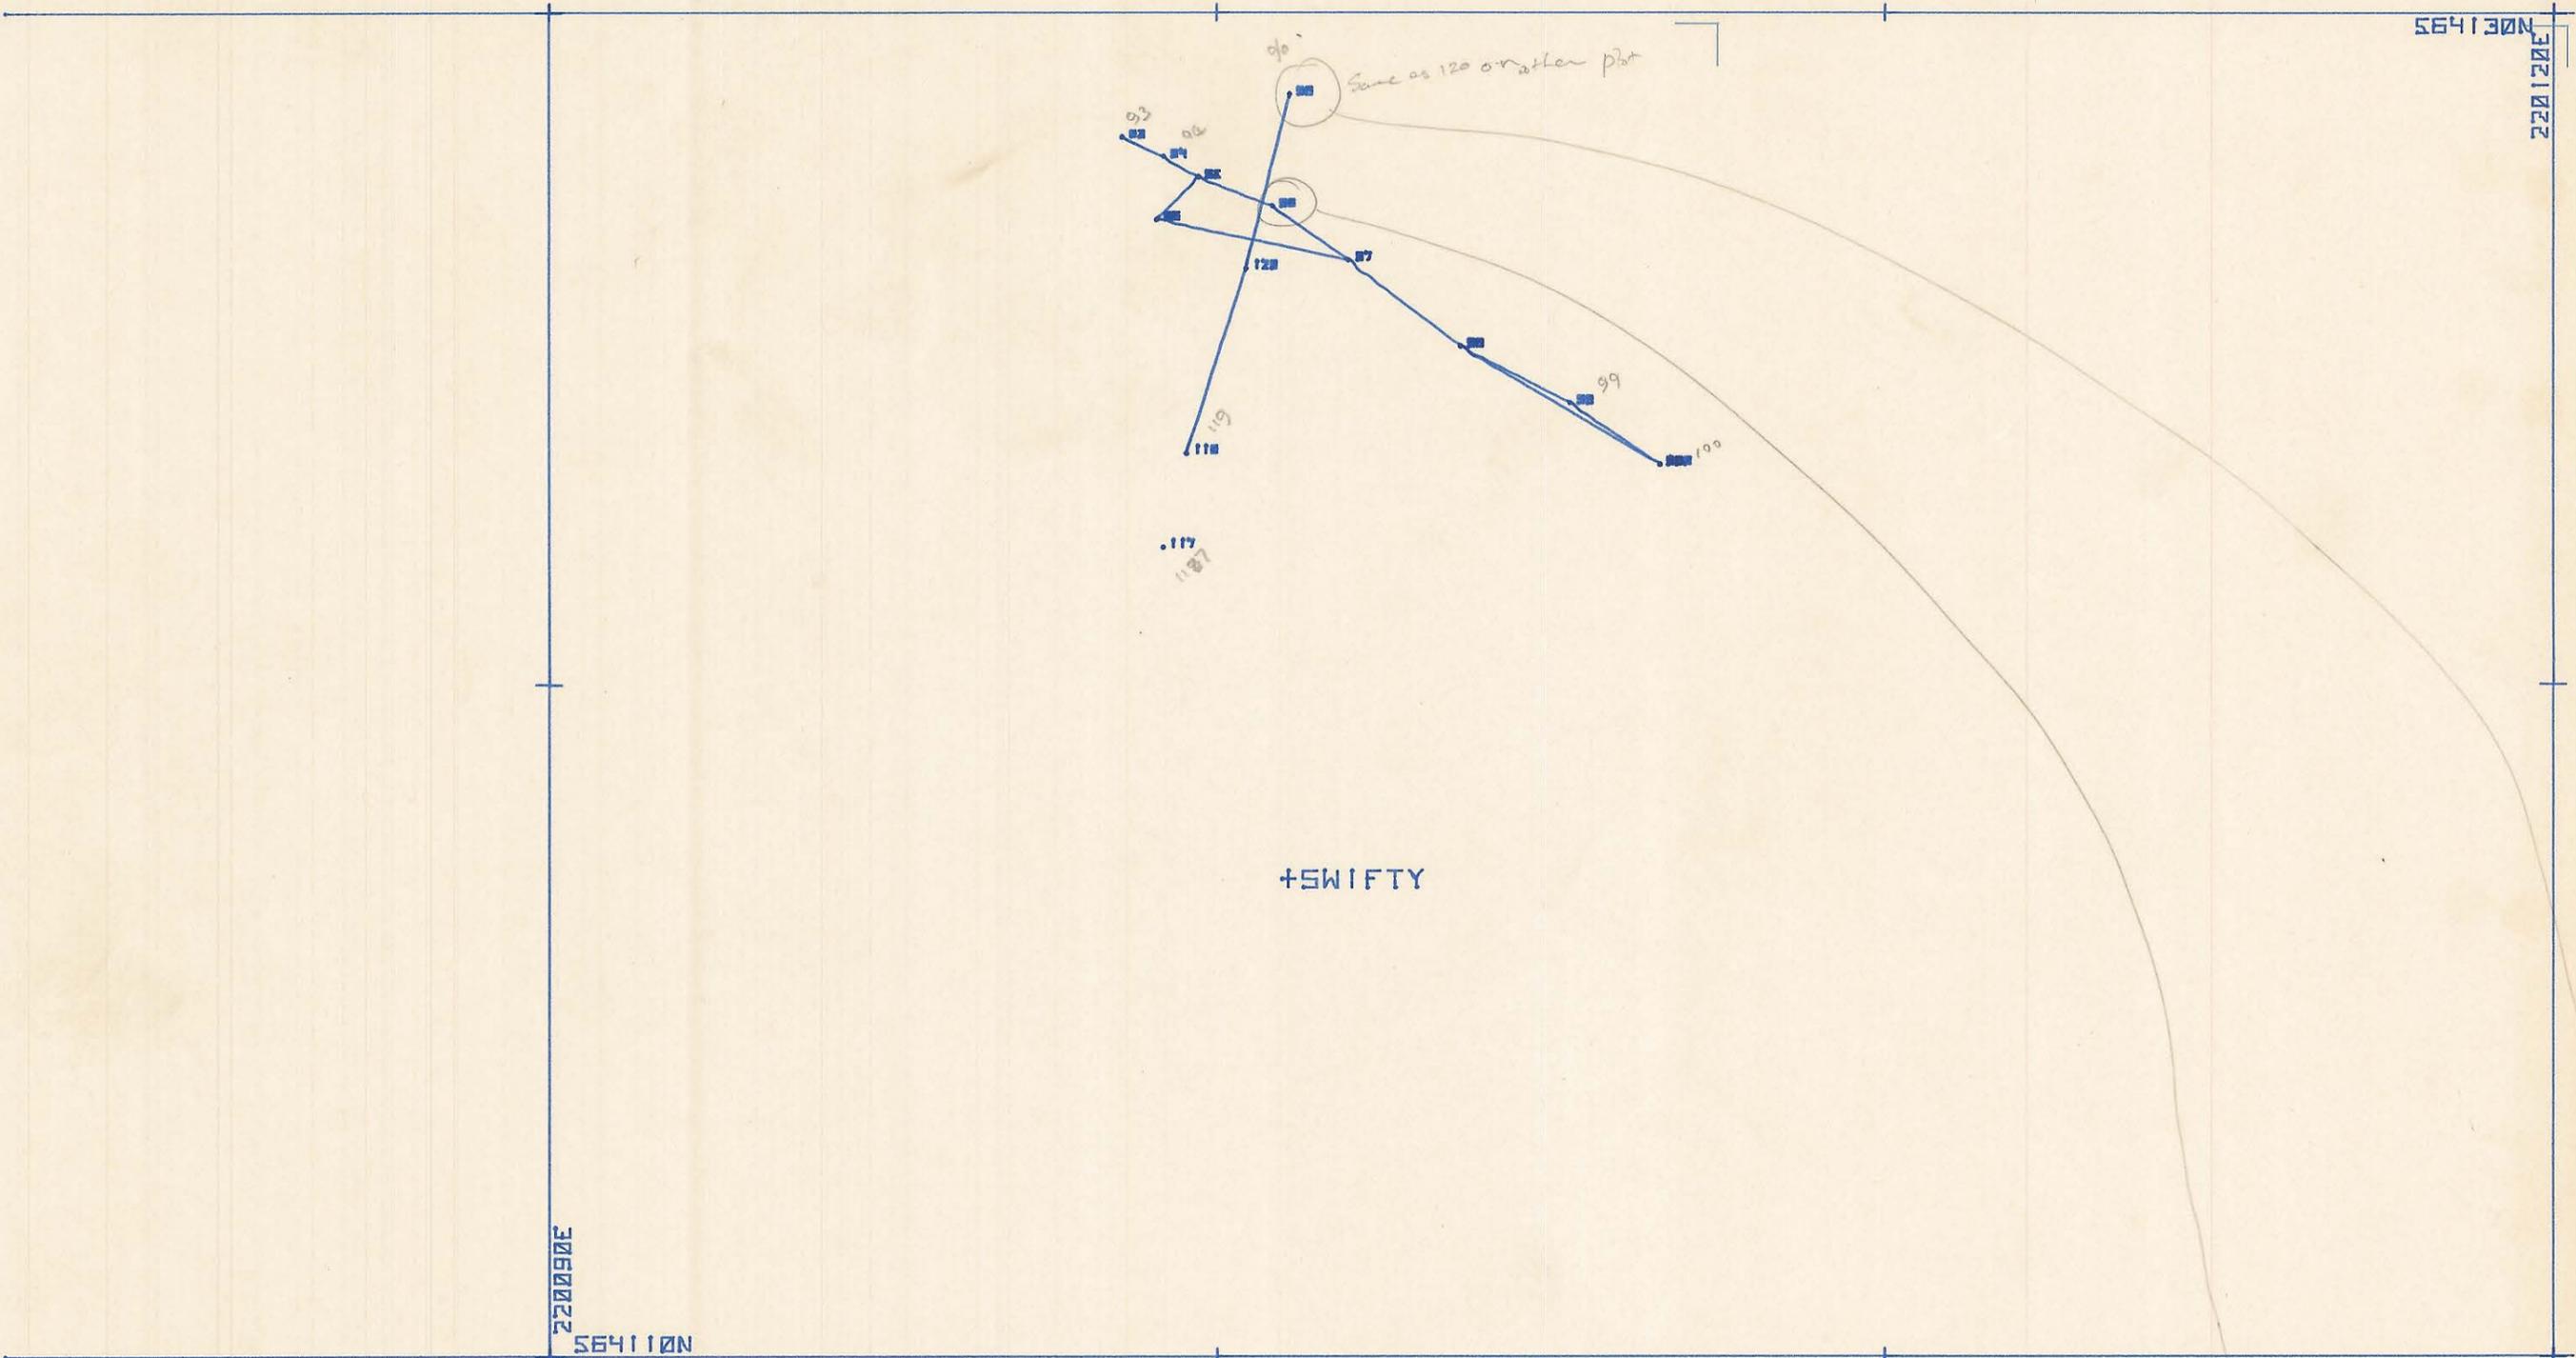

SCALE 1: 100 SHEET 4 0

DOLPHIN **CENTRAL STOPE** FATALITY PLAN
 FIELD WORK DONE THU 25/2/82 BY MGM/MQ/MGM/
 PLOTTING DONE 1217 WED 3/3/82 BY MGM
 COORDE OF SWIFTY • LAT 564117.135, DEP 220101.100, TARR -100.203

117
118
119
200