


0374\_3688

5 cm

Meridian from Marine Dept  
Beacons.  
Datum Pier Beacon to Lightfoots  
Beacon  $305^{\circ}10'40''$

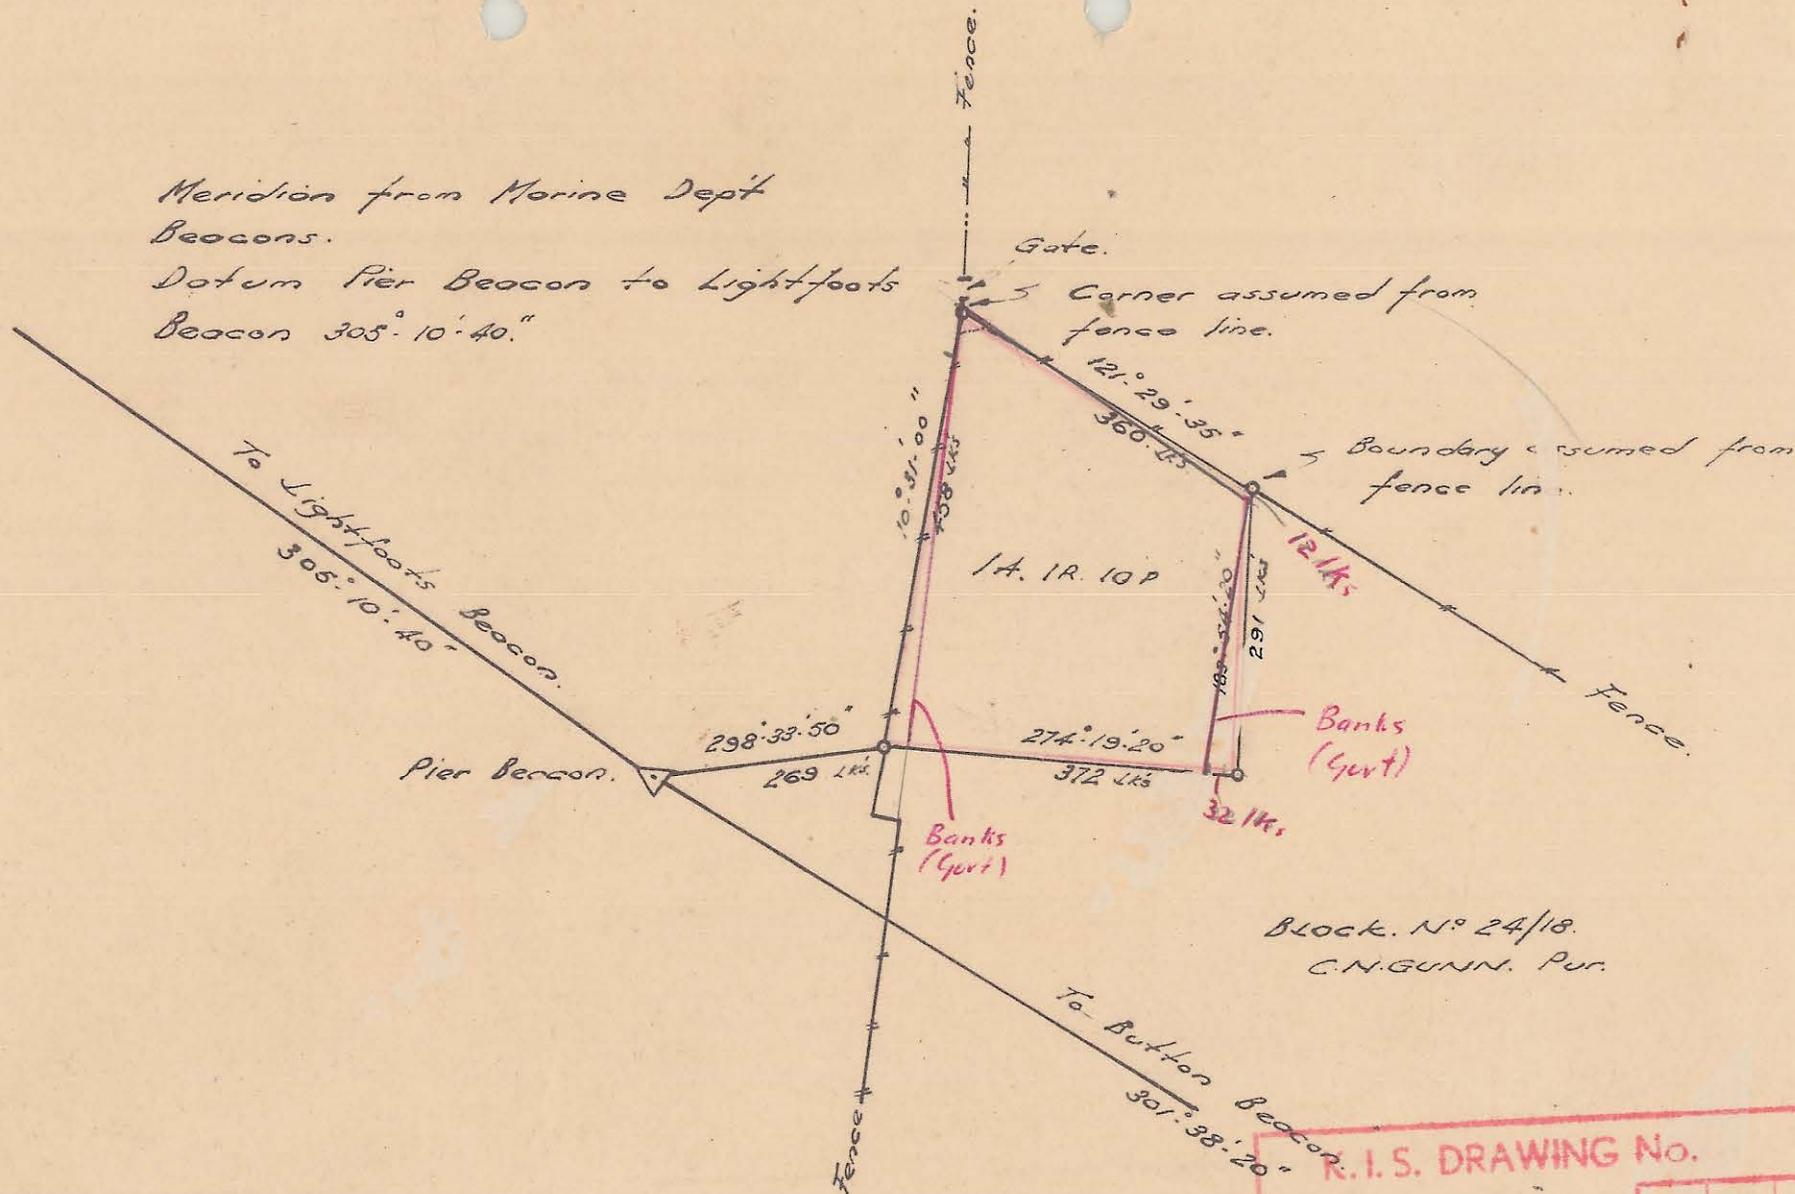

Block. No 24/18.  
C.N. GUNN. Pur.

R.I.S. DRAWING No.	
156	
SCALE	DATE OF RECEIPT

Adjustment to lease diagram in Blue