


5 cm

0374_3689

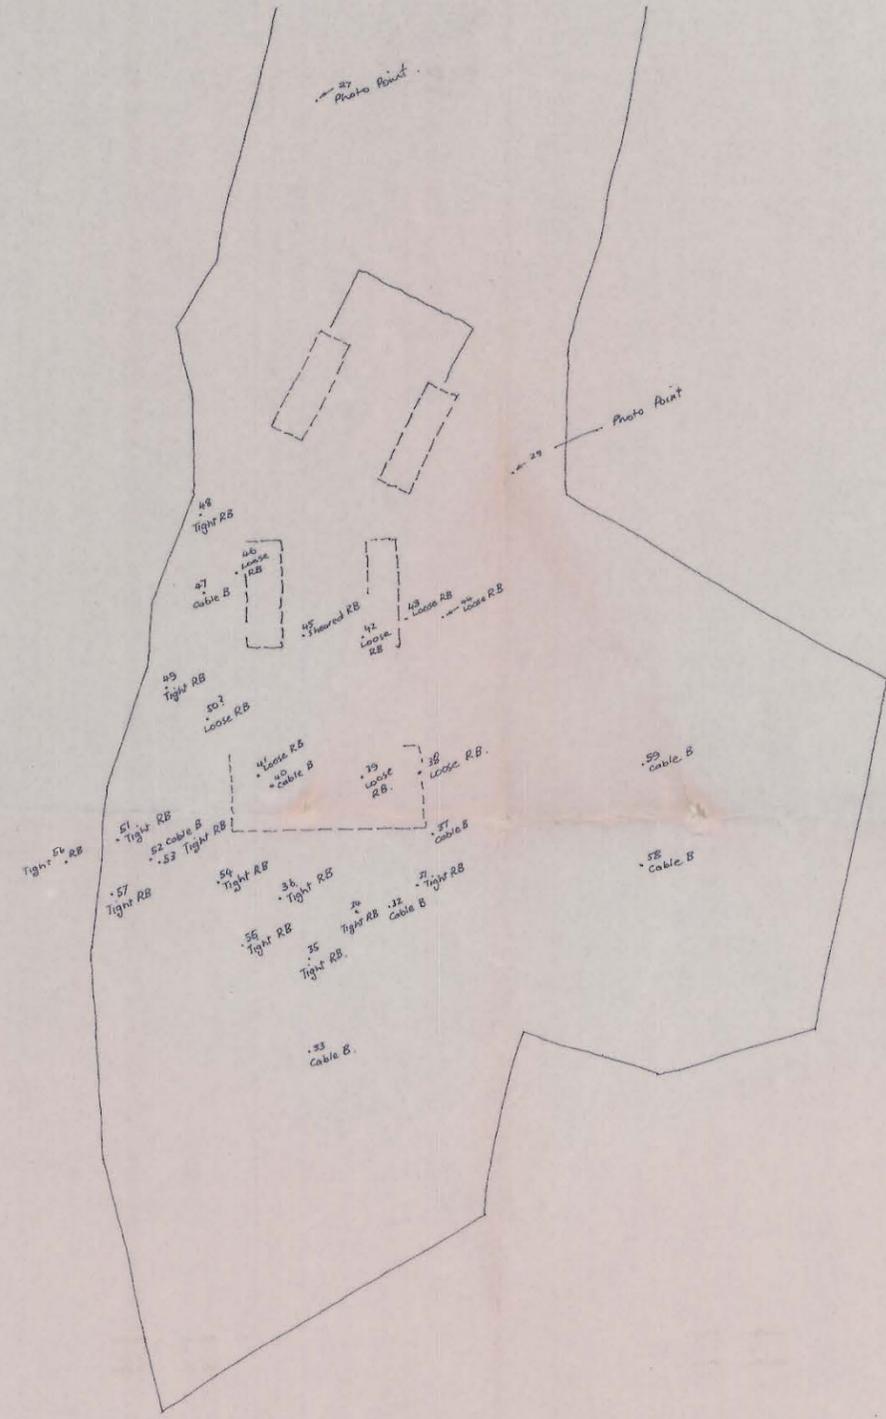

LEGEND:

-
-
-
-



GEOPEKO LIMITED
KING ISLAND

Scale: _____ NO K

DATE:
 GEOL:
 DWN:
 CHKD: