


SKETCH PLAN OF
SURVEY OF BLOCK 8 & PART BLOCK 9
GRASSY TOWNSHIP

SCALE: 40' to 1"

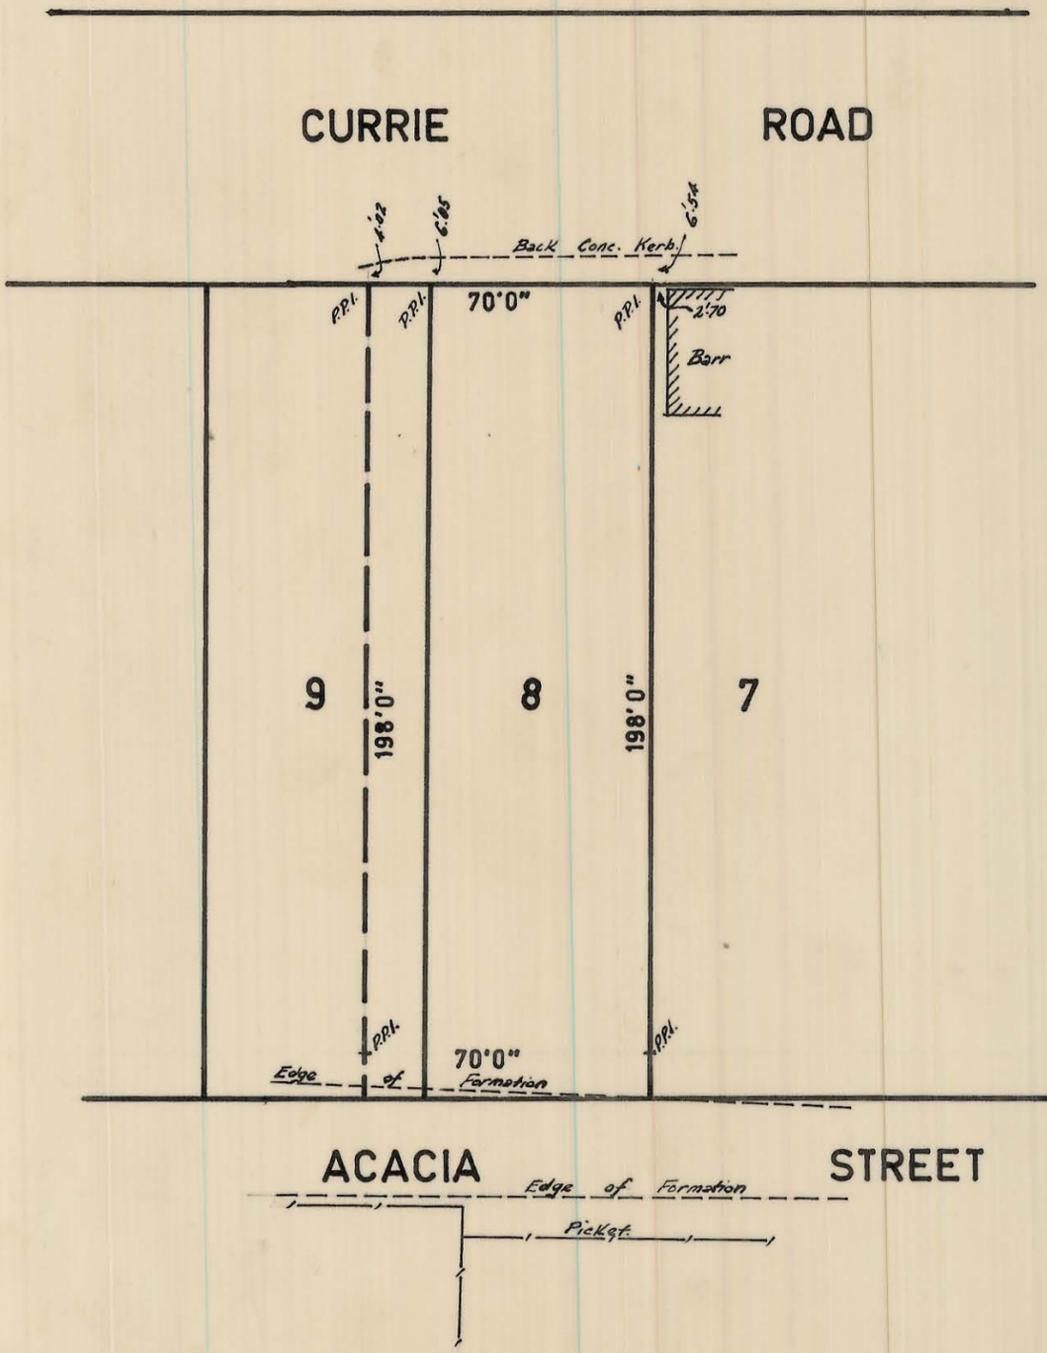

1-T-7

T 109

imc 29/12/69