


06 AG2-06-160 E

0374-370

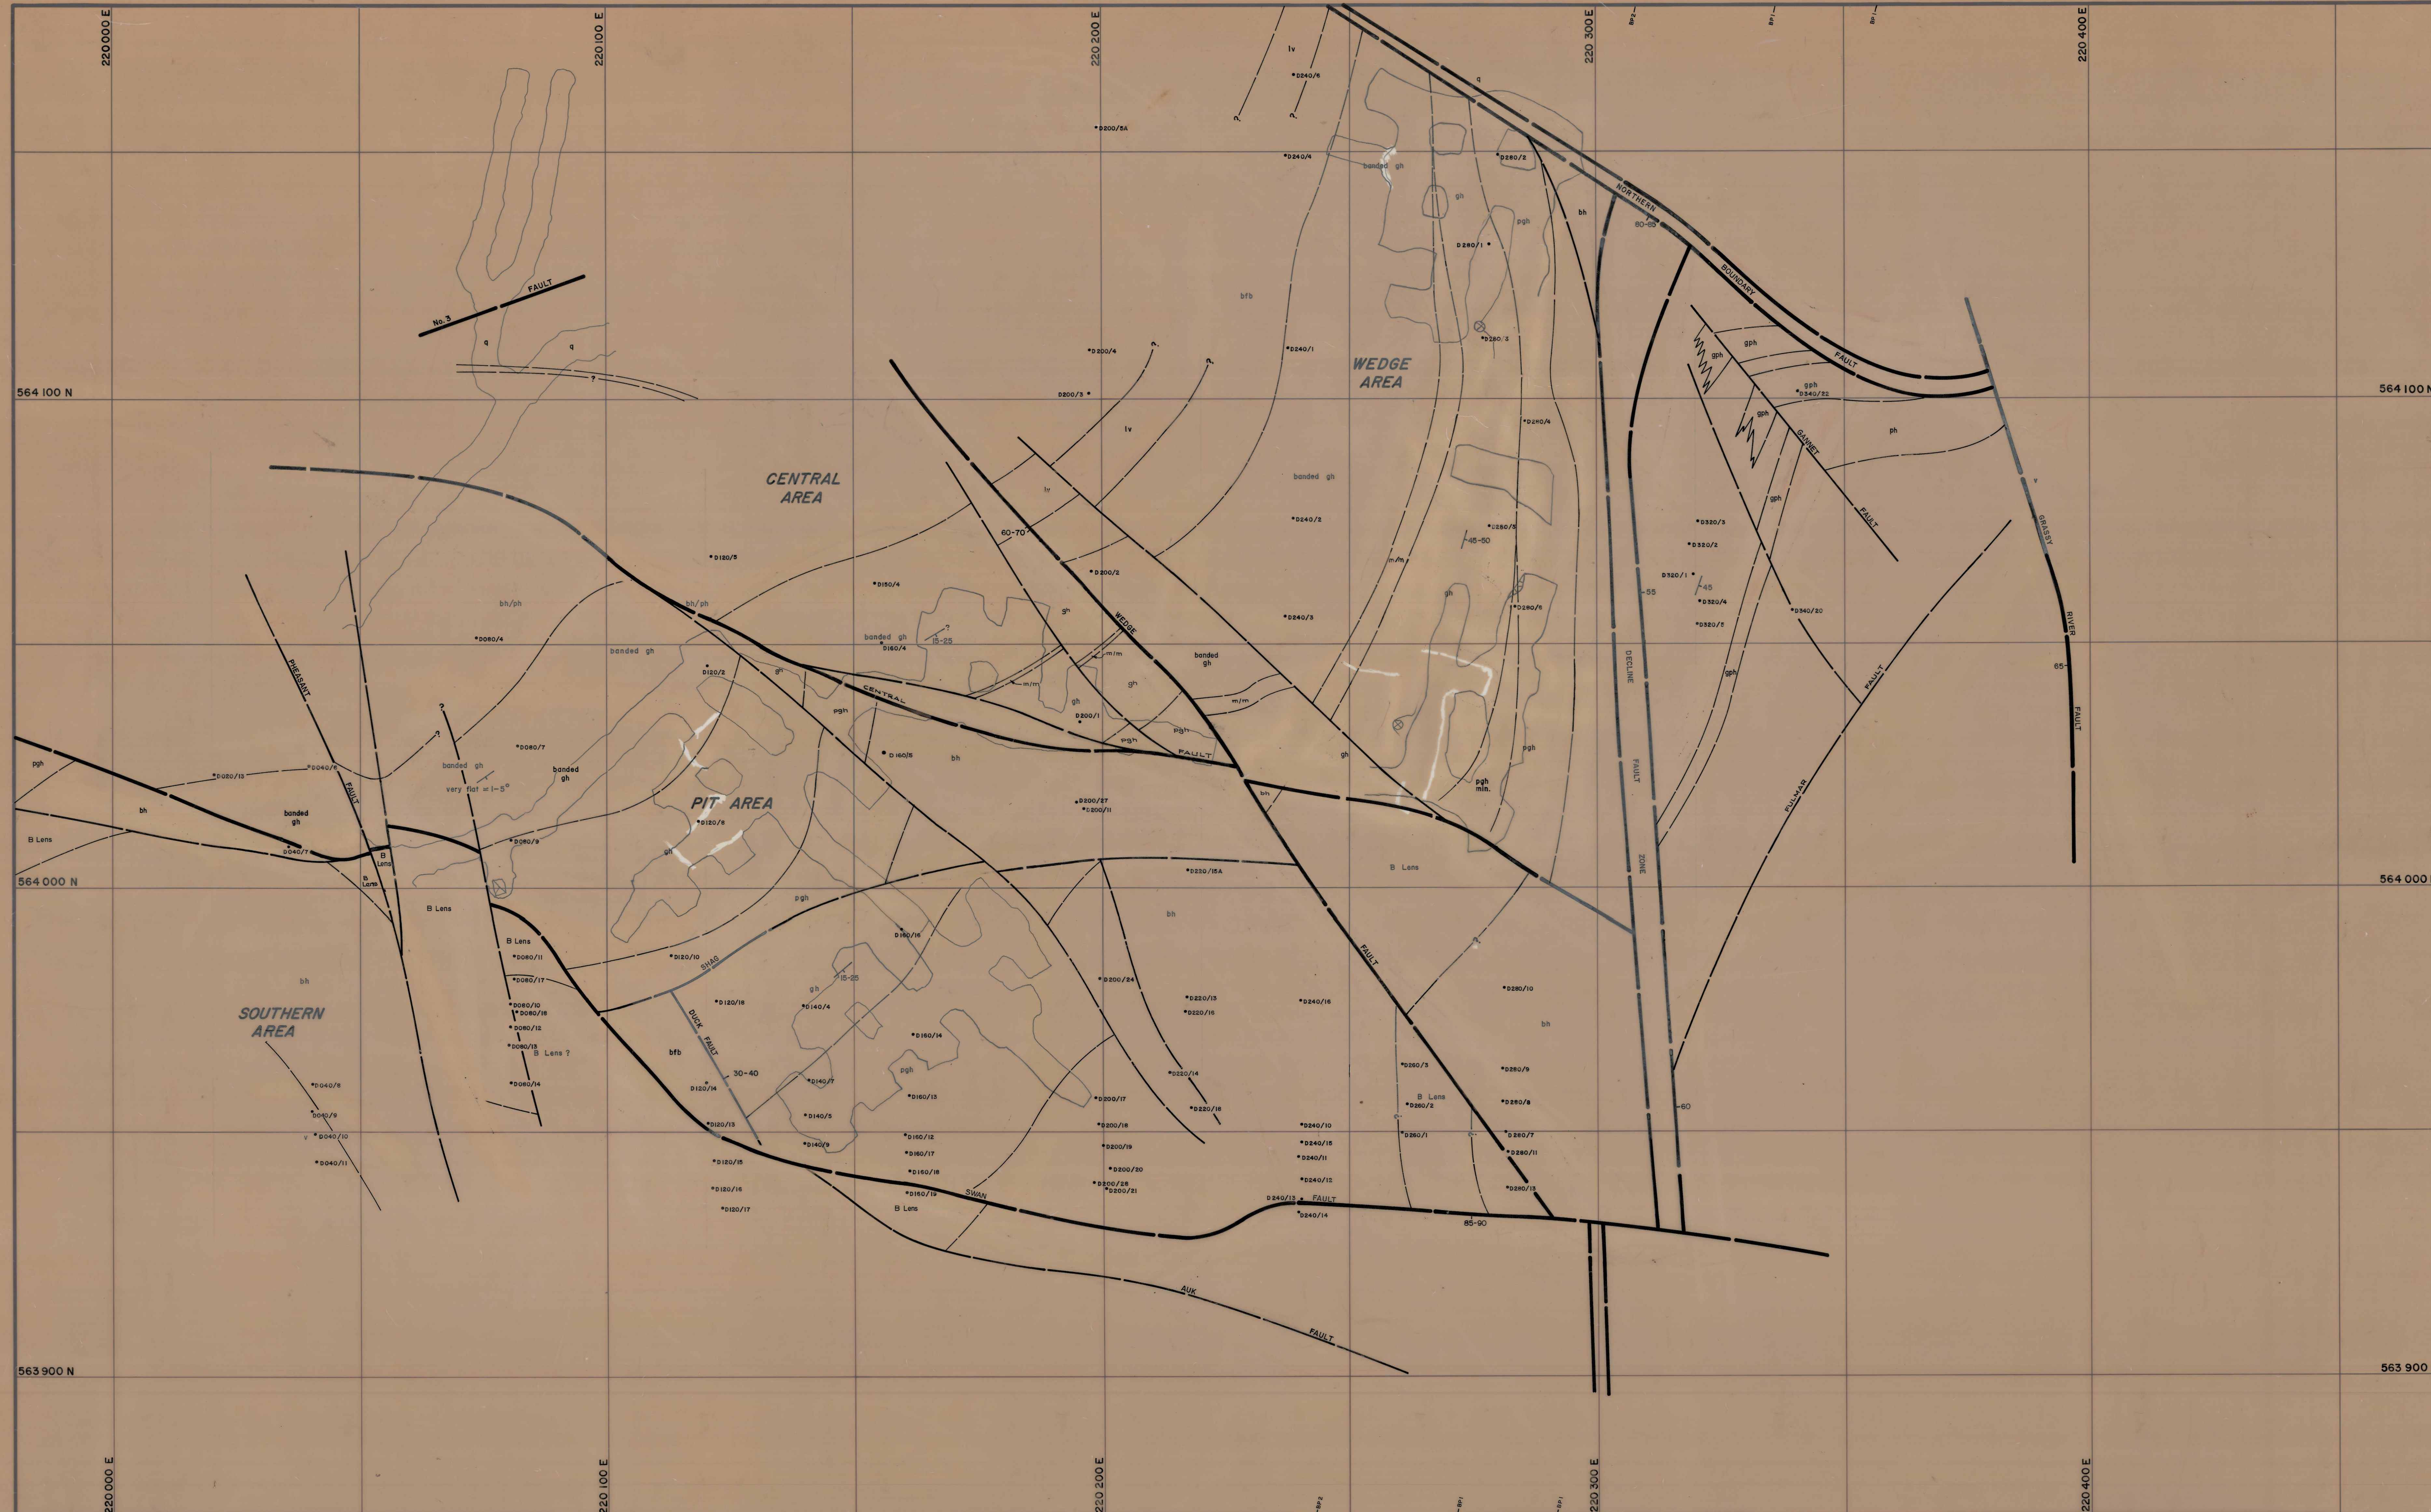

LEGEND:			
y	Upper metavolcanics	bph	Banded footwall beds
ph/bh	Banded hornfels	lv	Lower metavolcanics
ch	Marble	q	Quartzite
bh	Biotite hornfels	ap	Aplite
pgh	Pyroxene garnet hornfels	ad	Adamellite
gh	Garnet hornfels		
60	Strike and dip		
27	Joint, inclined		
lv	Joint, vertical		
—	Fault		
R-127.3	Roadway R.L. -127.3m.		

DATE: JULY 1987
GEOLOGIST: S.G.B.
DRAWN:
CHECKED:

KING ISLAND SCHEELITE

SCALE: 1:500

No. KG2-06-160E

DOLPHIN MINE

GEOLOGICAL LEVEL PLAN

- 160m R.L.

5 cm