



0374_3763

5 cm

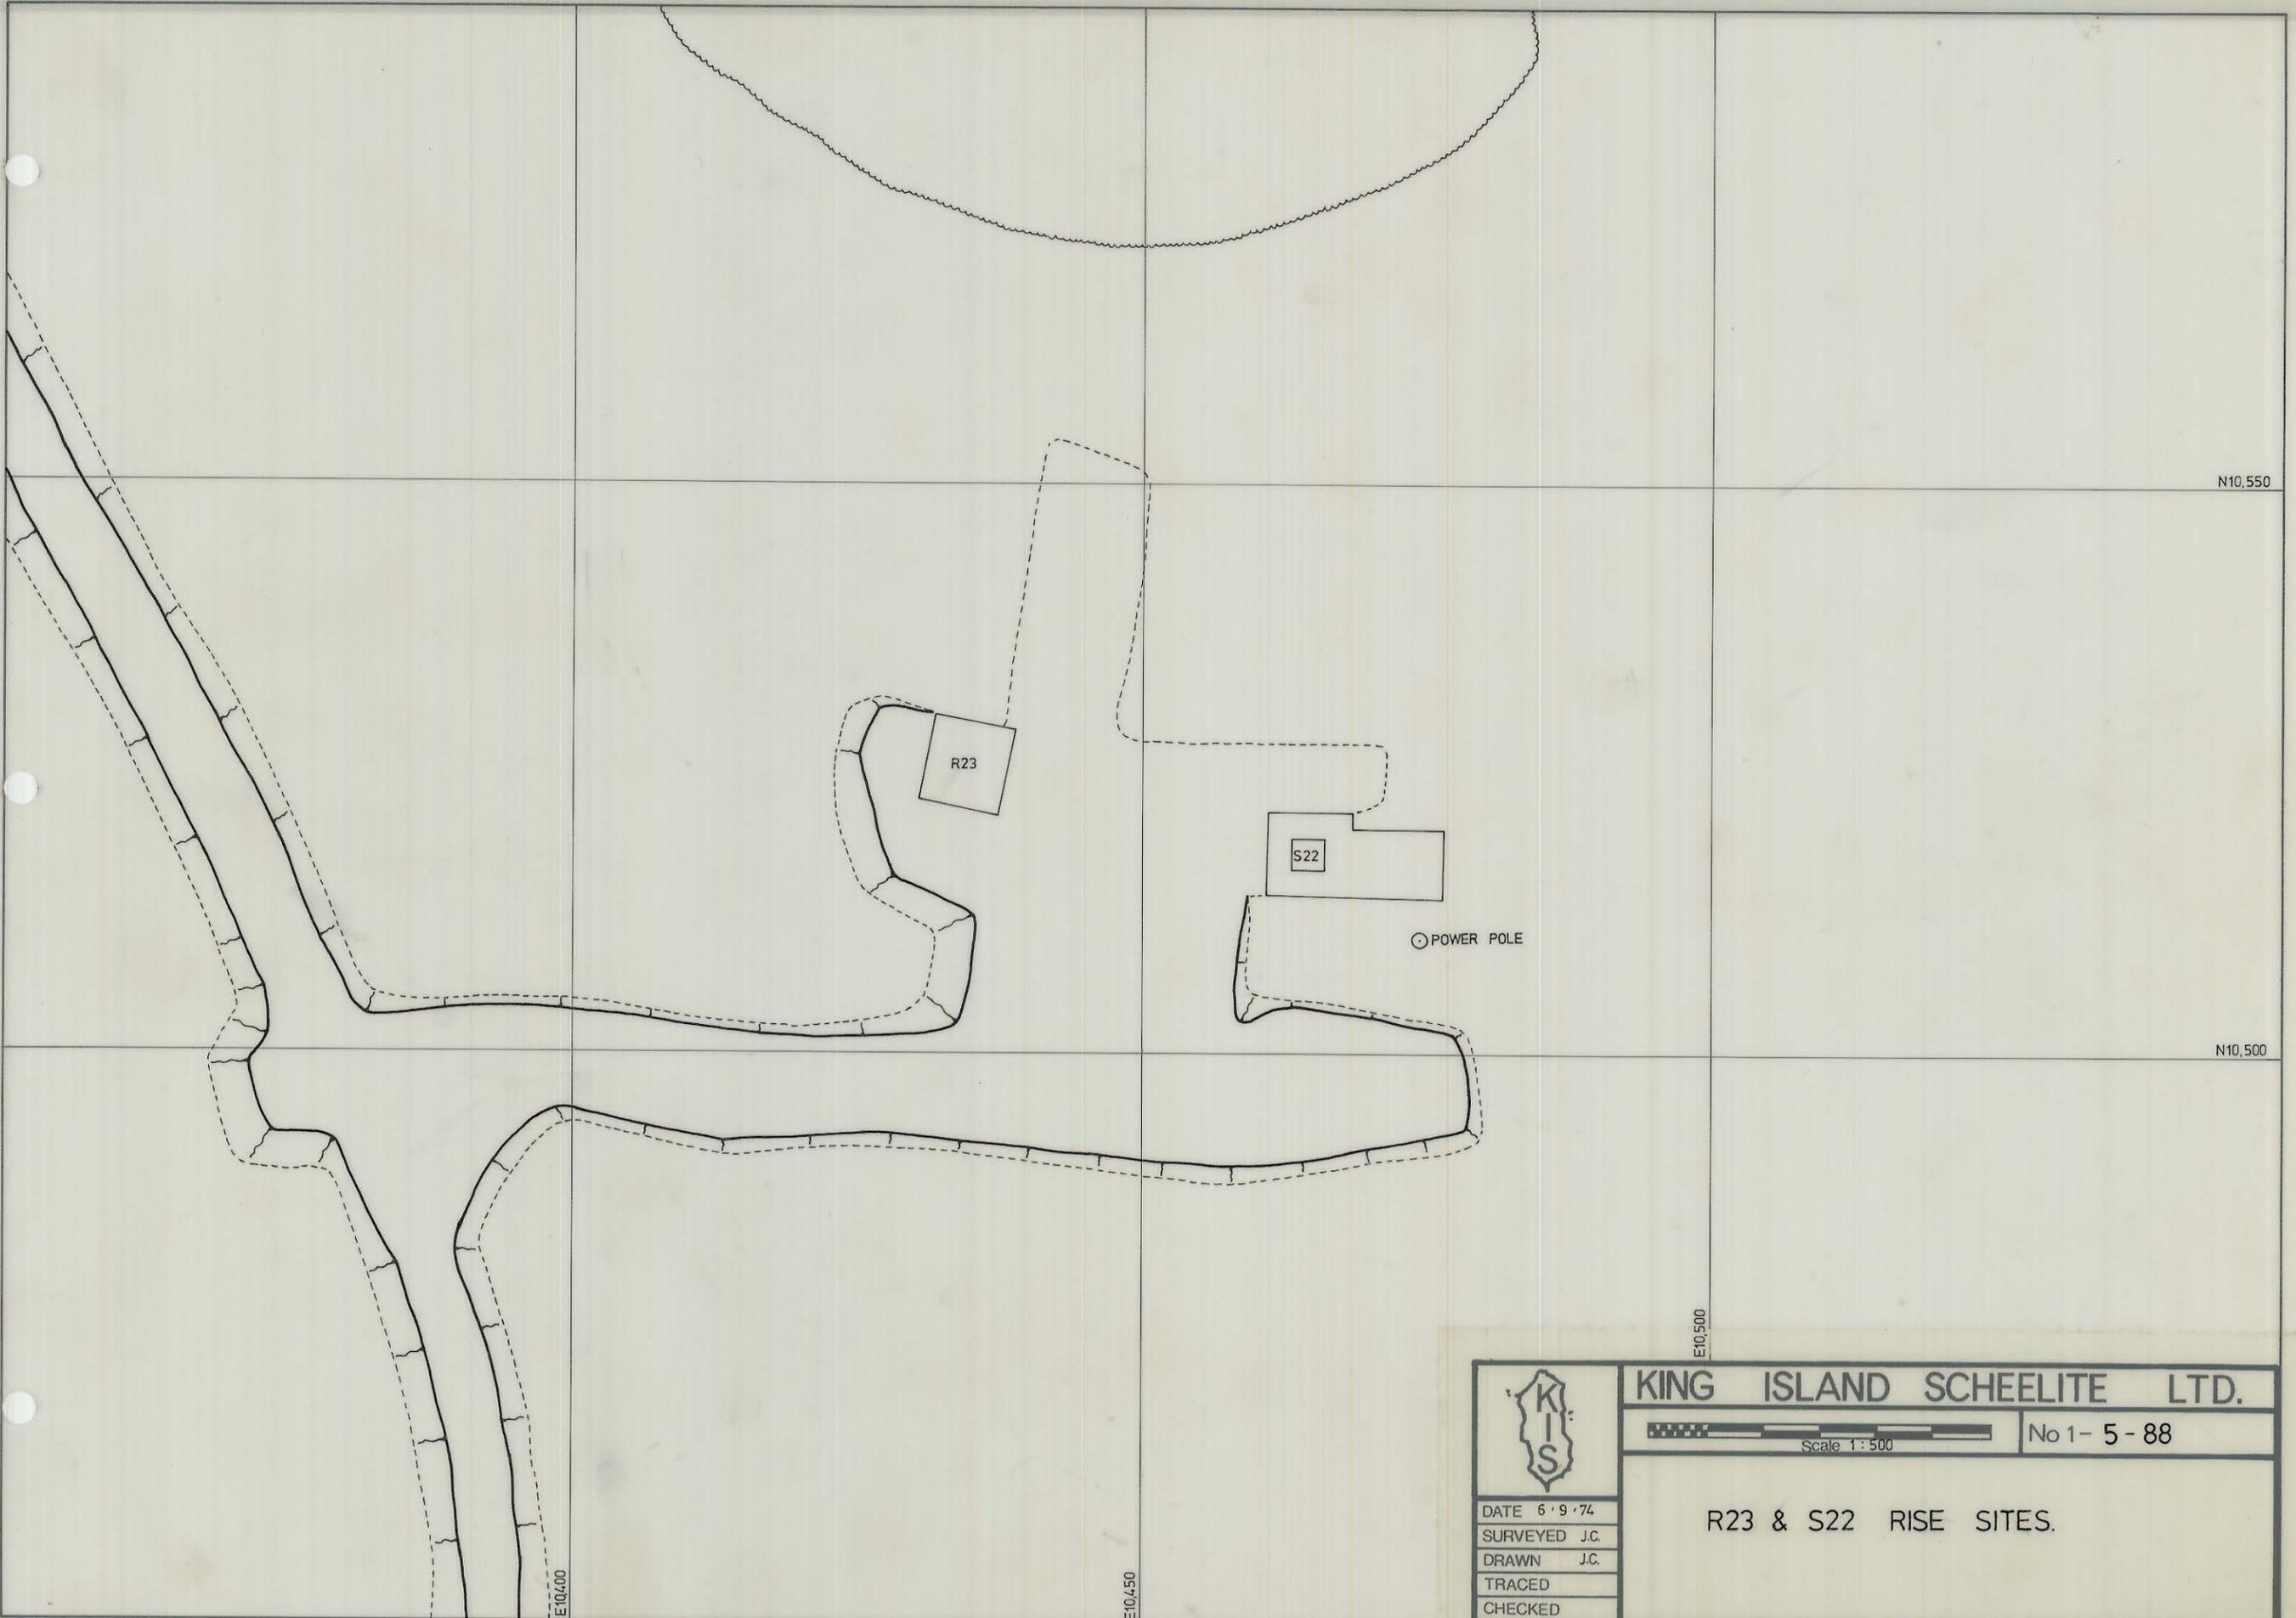

KING ISLAND SCHEELITE LTD.

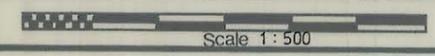

No 1- 5 - 88

DATE	6.9.74
SURVEYED	J.C.
DRAWN	J.C.
TRACED	
CHECKED	

R23 & S22 RISE SITES.