


5 cm

E10.325


E10.350

050

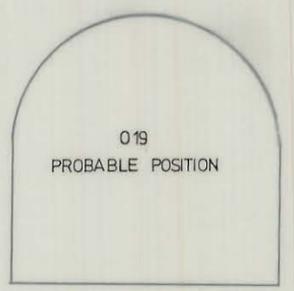

RL1040

RL1030

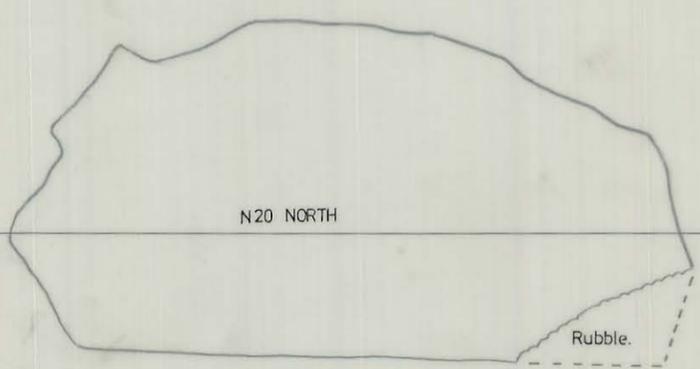

	DATE 19 SEP 74
	SURVEYED J.C.
	DRAWN J.C.
	TRACED
	CHECKED

KING ISLAND SCHEELITE LTD.	
SCALE 1:100	No 1-5-91
BOLD HEAD N20NORTH	
SECTION N10.500	