

5 cm




E 10,325

E10,350

.050

RL1040

RL1030

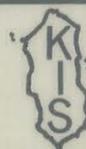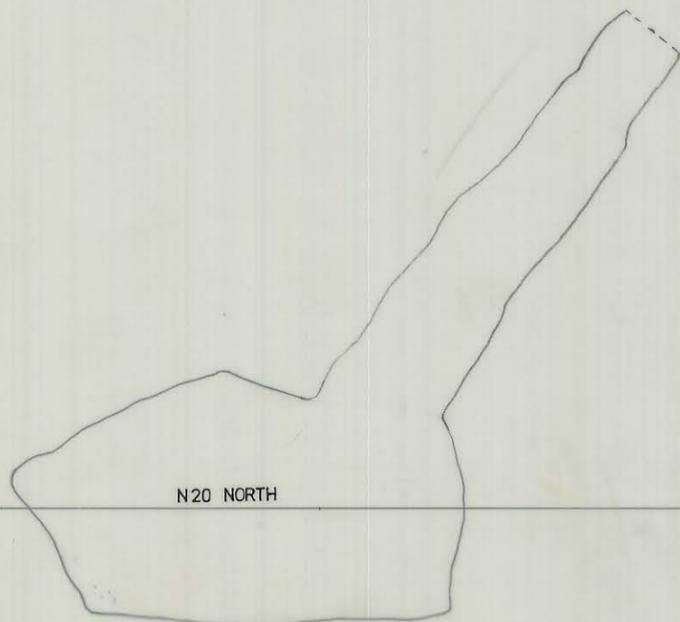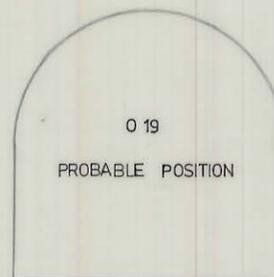

KING ISLAND SCHEELITE LTD.

SCALE 1 : 100

No 1-5-90

DATE 19 SEP 74

SURVEYED J.C.

DRAWN J.C.

TRACED

CHECKED

BOLD HEAD
N20NORTH

SECTION N10,490