


0374_3768

5 cm

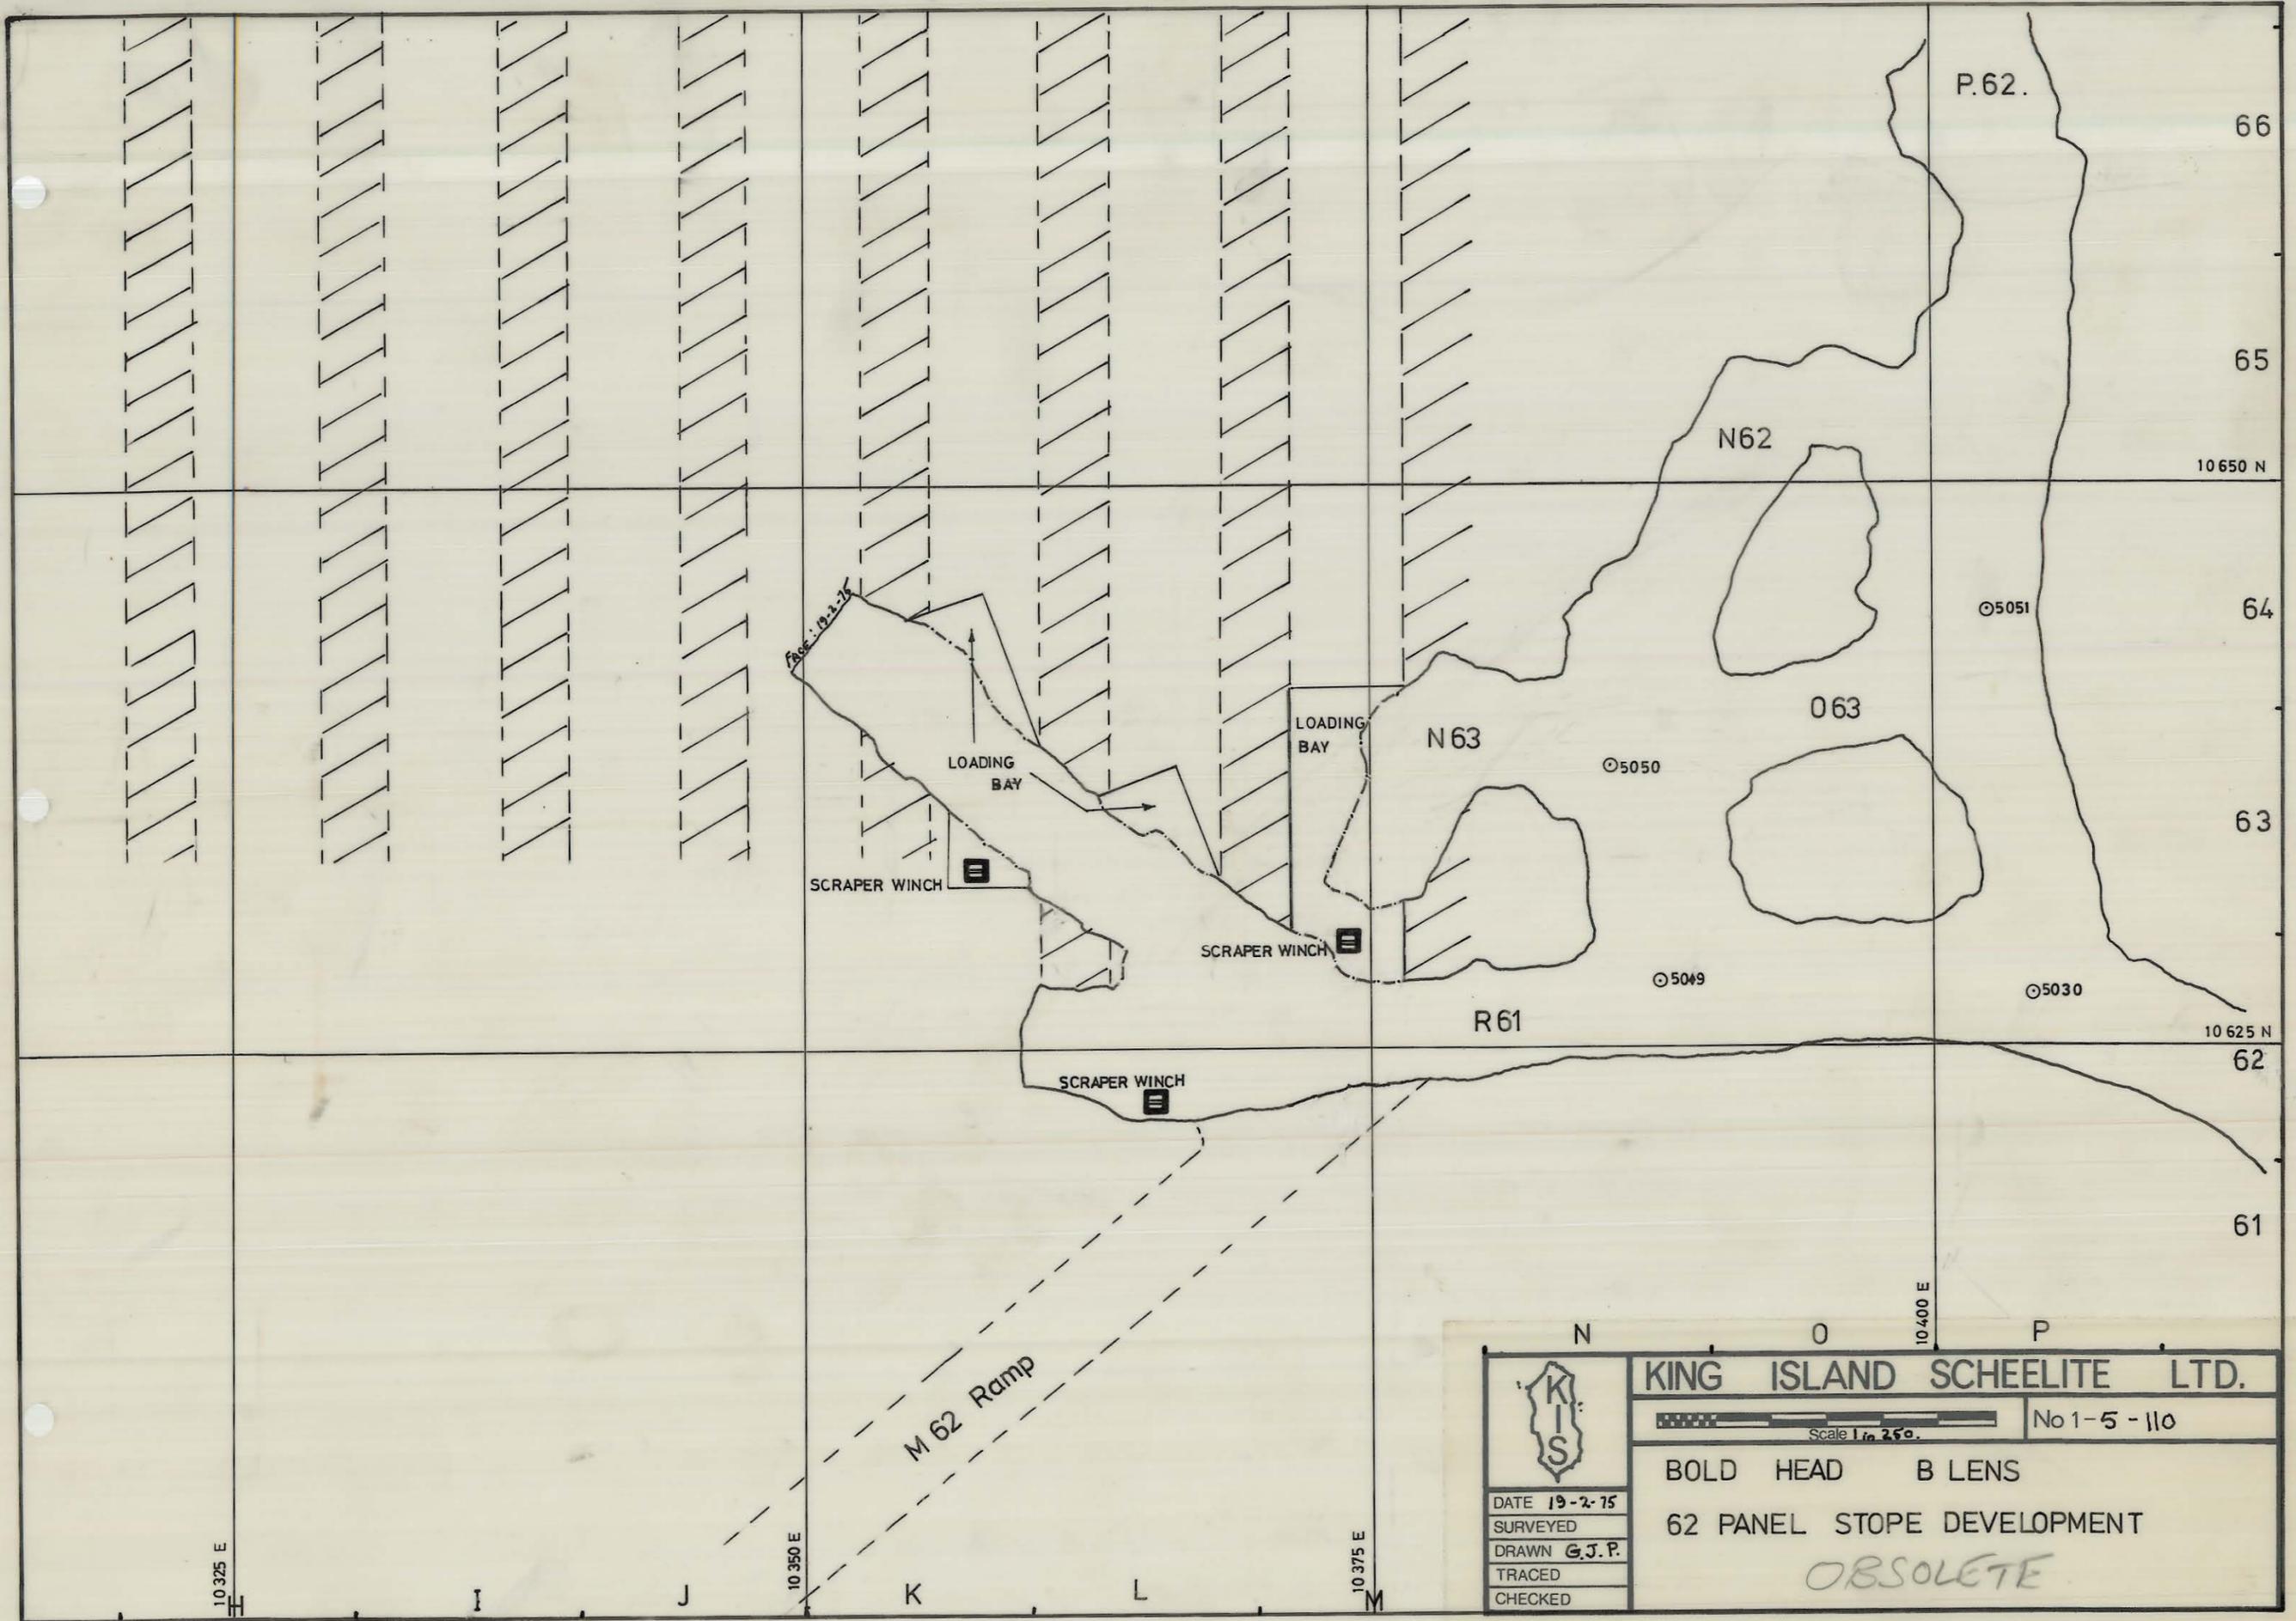

 DATE 19-2-75 SURVEYED DRAWN G.J.P. TRACED CHECKED	KING ISLAND SCHEELITE LTD. No 1-5-110 Scale 1 in 250.	
	BOLD HEAD B LENS 62 PANEL STOPE DEVELOPMENT <i>OBSOLETE</i>	