



5 cm

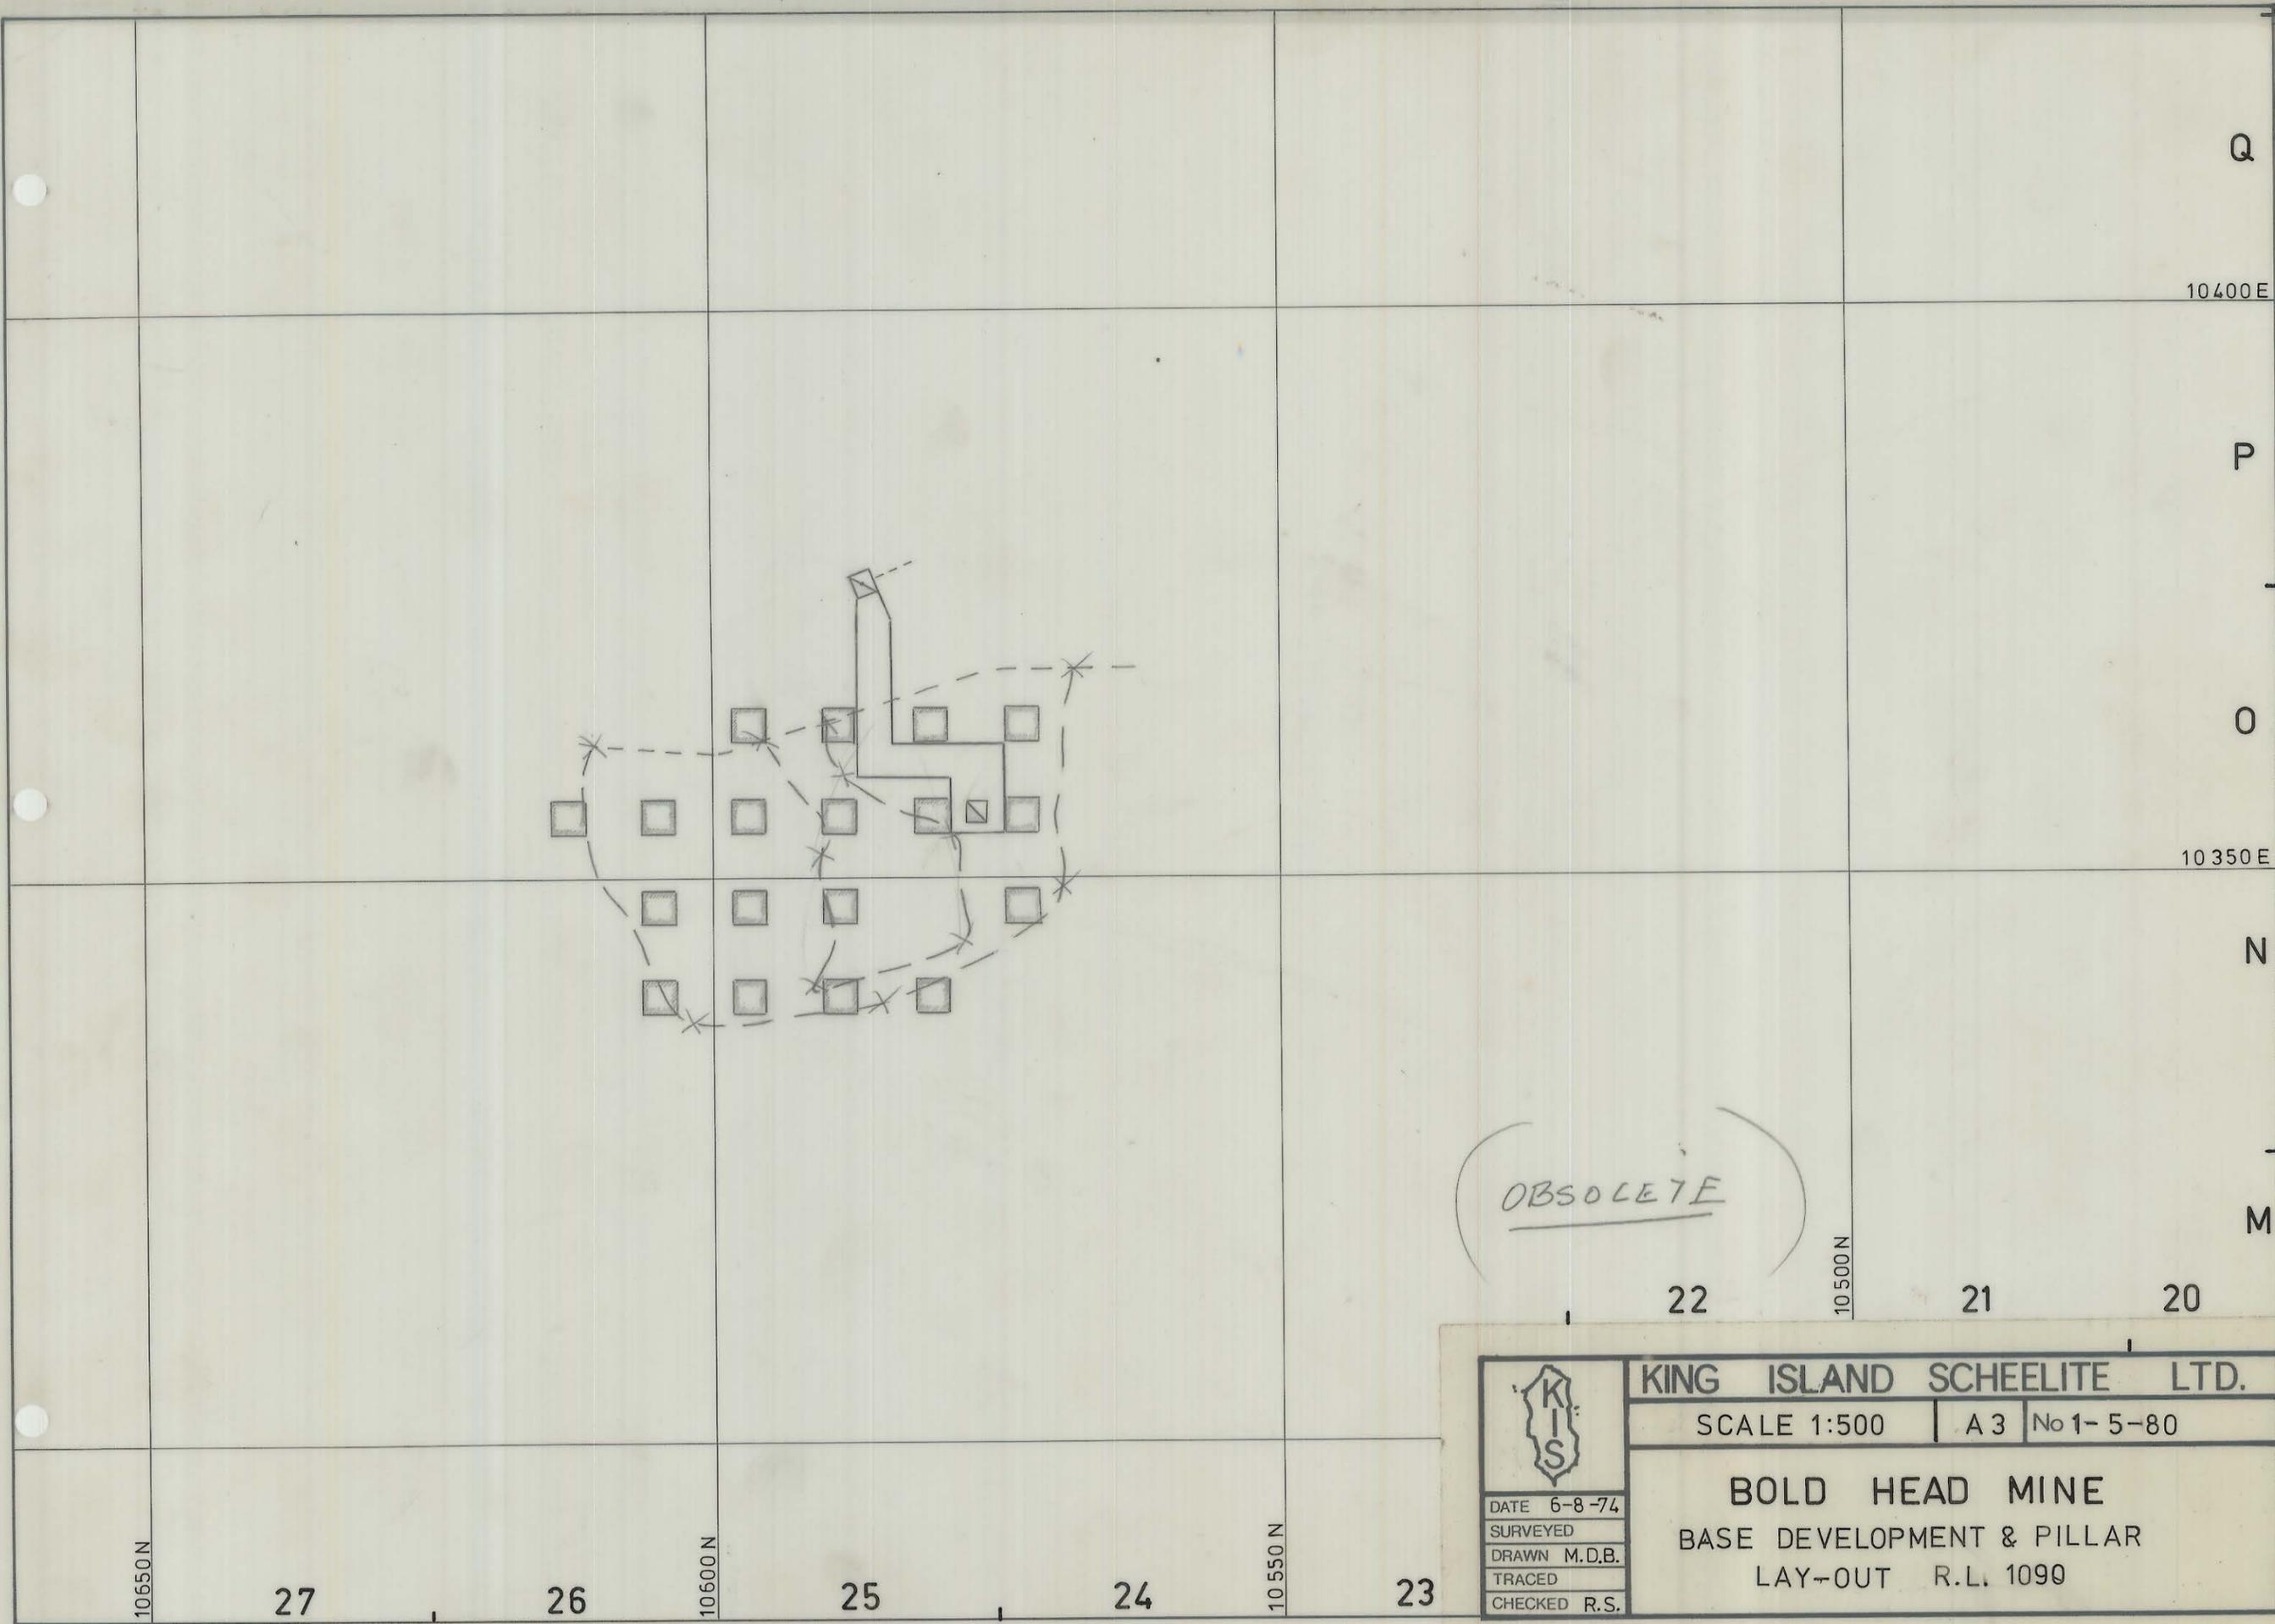

OBSOLETE

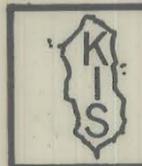

KING ISLAND SCHEELITE LTD.

SCALE 1:500 | A3 | No 1-5-80

BOLD HEAD MINE
BASE DEVELOPMENT & PILLAR
LAY-OUT R.L. 1090

DATE 6-8-74
SURVEYED
DRAWN M.D.B.
TRACED
CHECKED R.S.

10550 N

27

26

10600 N

25

24

10550 N

23

22

10500 N

21

20

Q

10400 E

P

O

10350 E

N

M