


5 cm



OBSOLETE

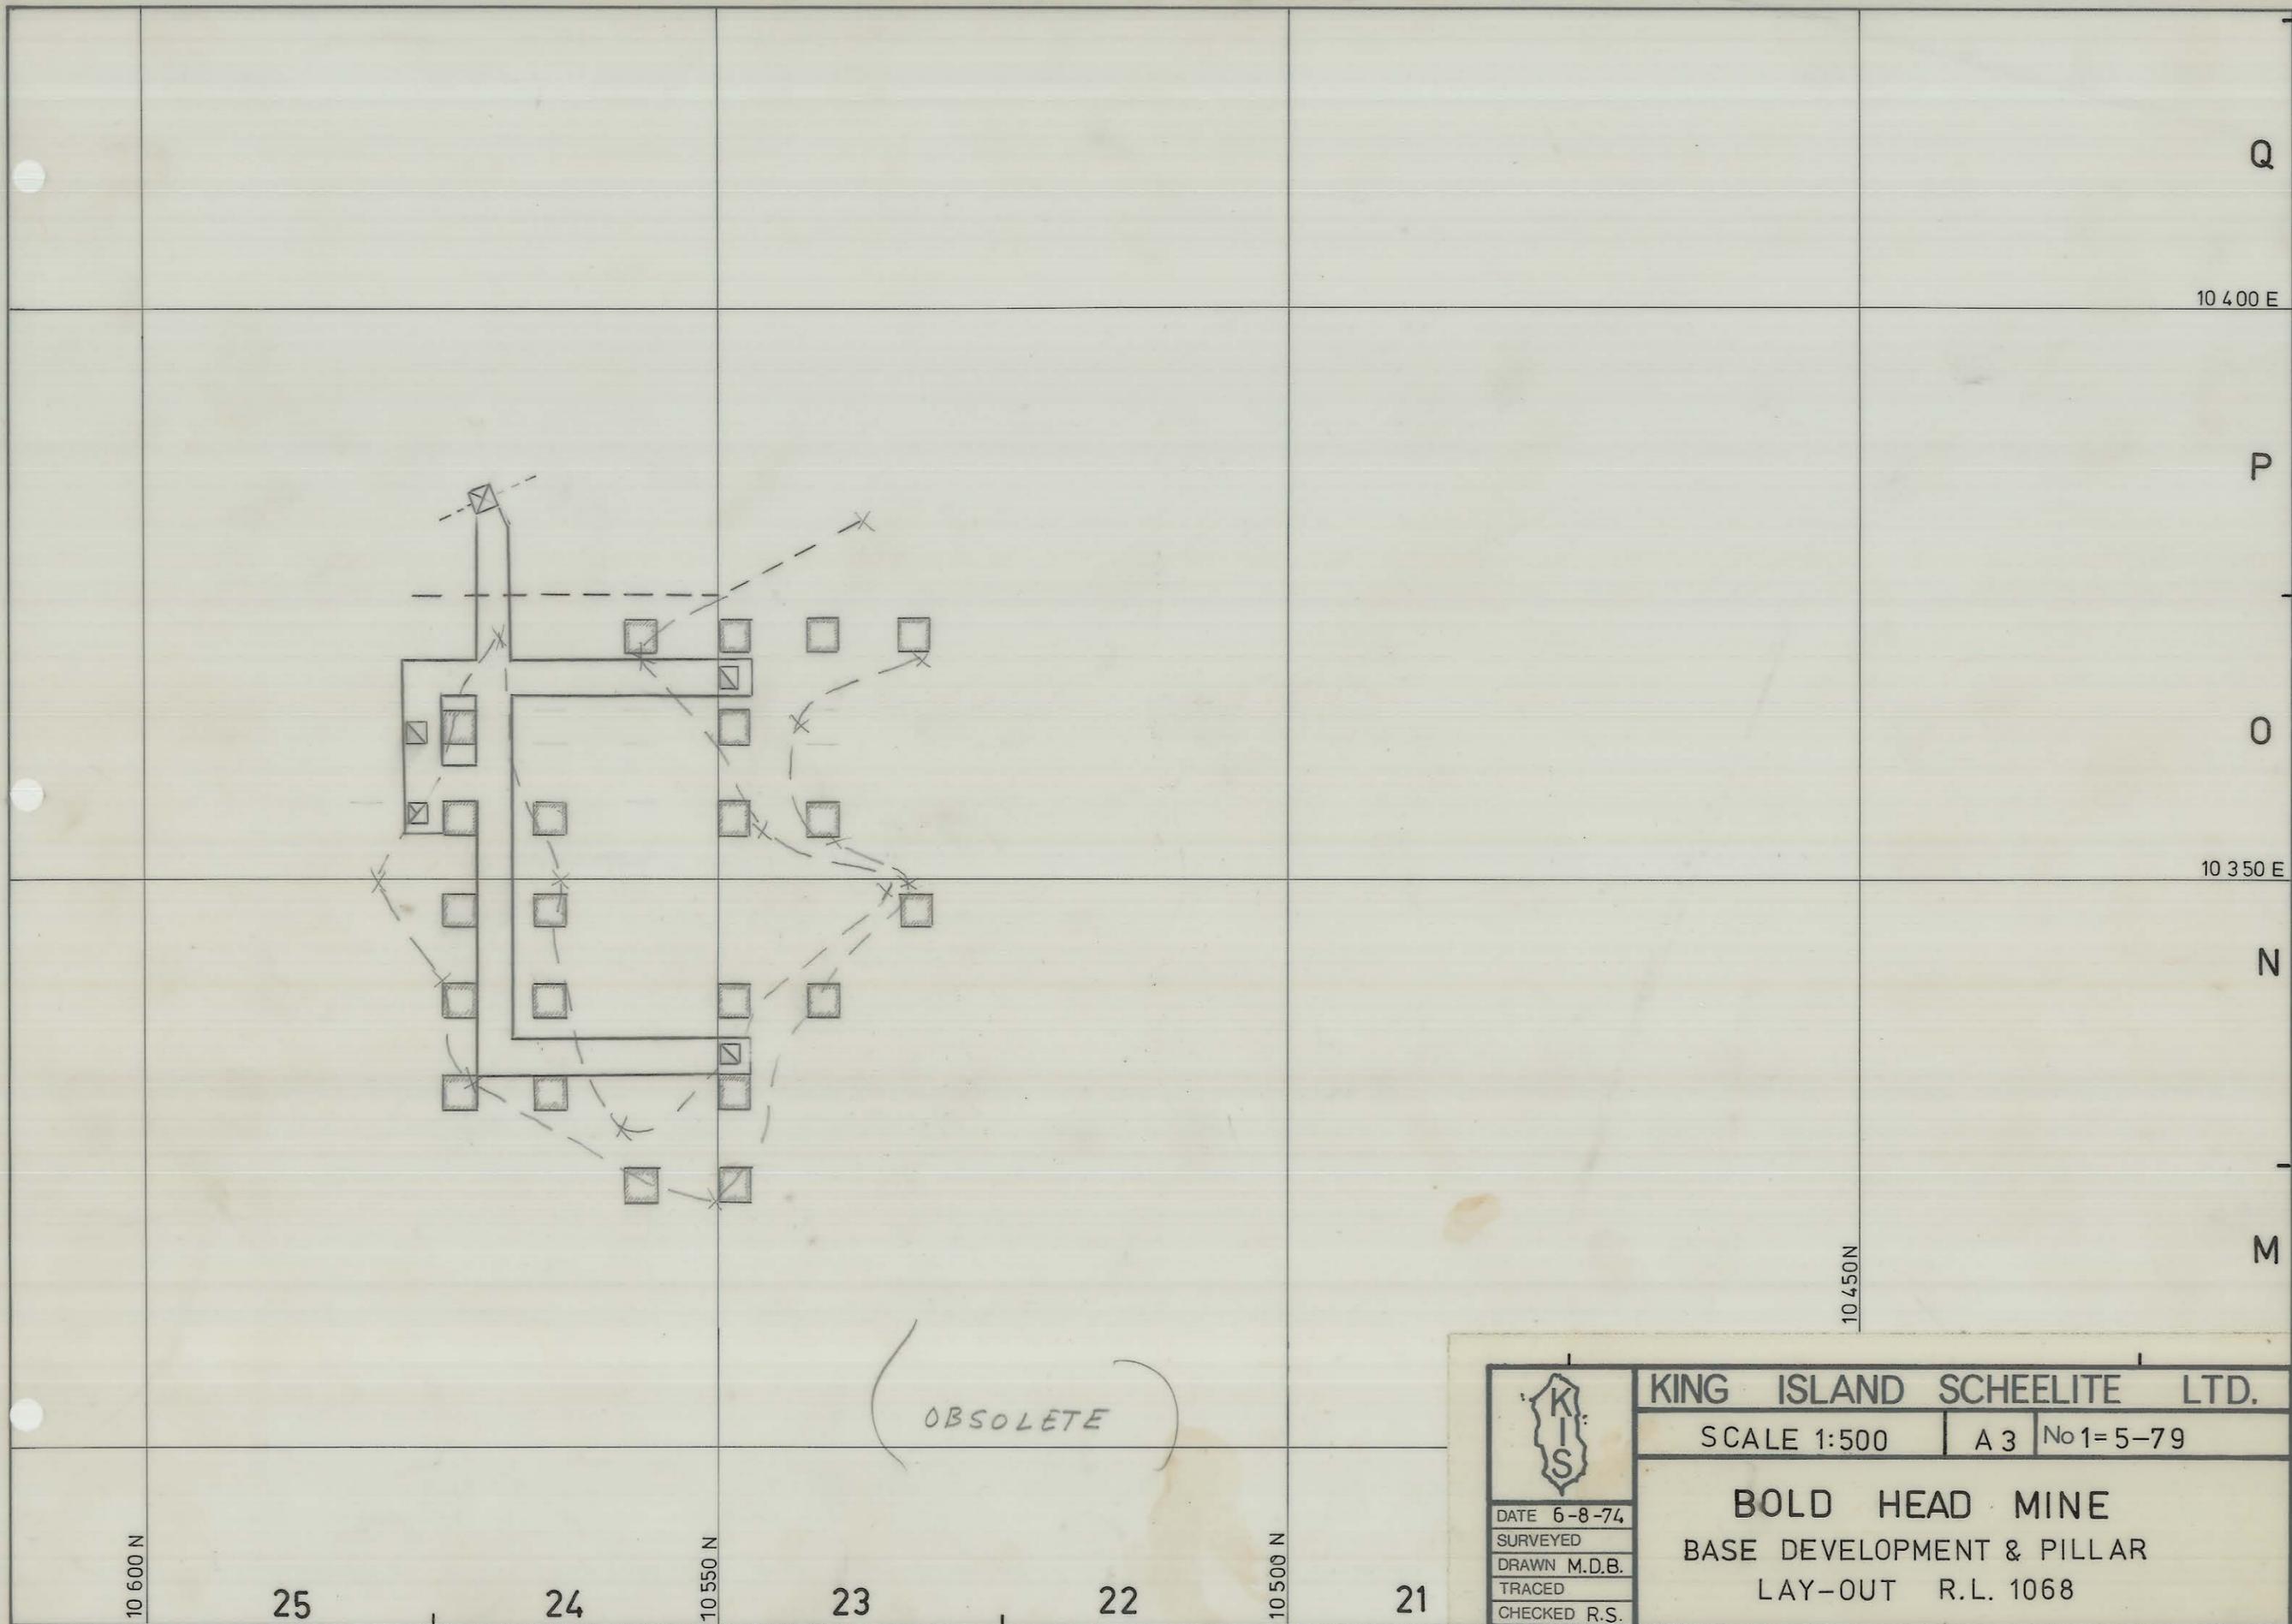

DATE 6-8-74
 SURVEYED
 DRAWN M.D.B.
 TRACED
 CHECKED R.S.

KING ISLAND SCHEELITE LTD.

SCALE 1:500 A 3 No 1=5-79

BOLD HEAD MINE
 BASE DEVELOPMENT & PILLAR
 LAY-OUT R.L. 1068