
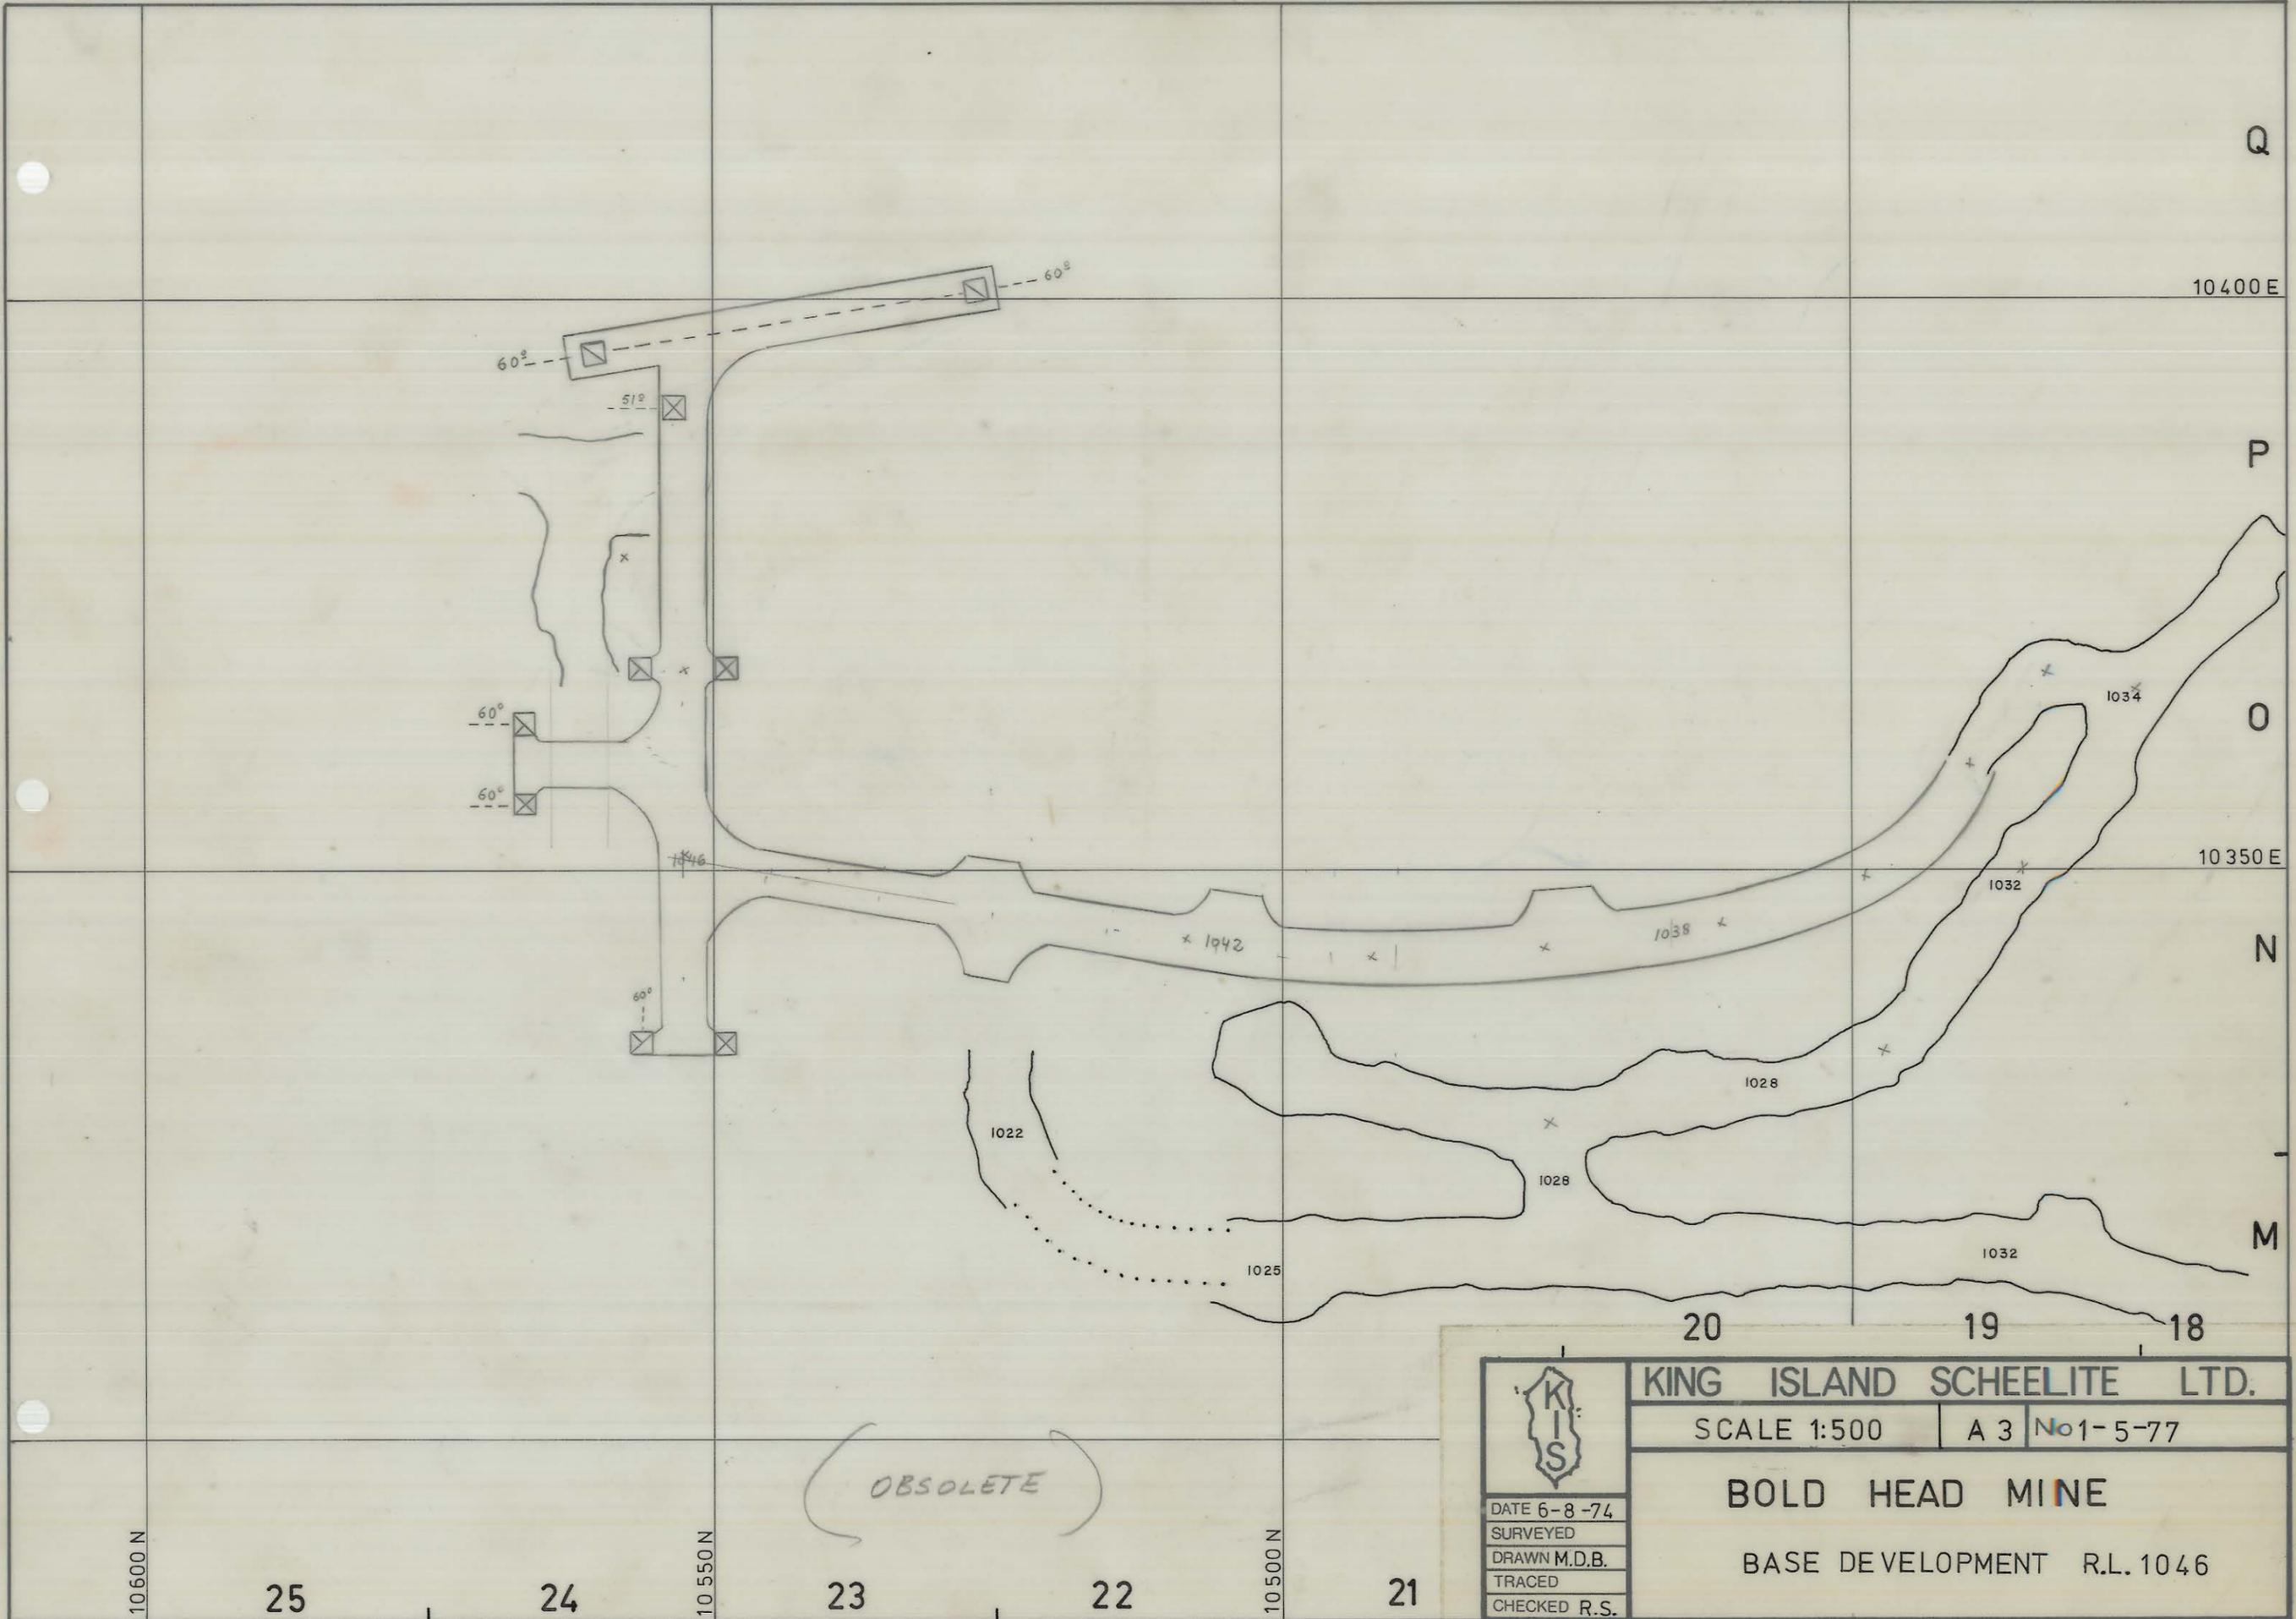


5 cm

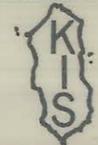

*OBSOLETE*

  
 DATE 6-8-74  
 SURVEYED  
 DRAWN M.D.B.  
 TRACED  
 CHECKED R.S.

KING ISLAND SCHEELITE LTD.		
SCALE 1:500	A 3	No 1-5-77
<b>BOLD HEAD MINE</b>		
BASE DEVELOPMENT R.L. 1046		