
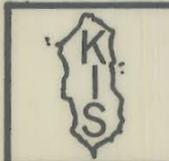


5 cm

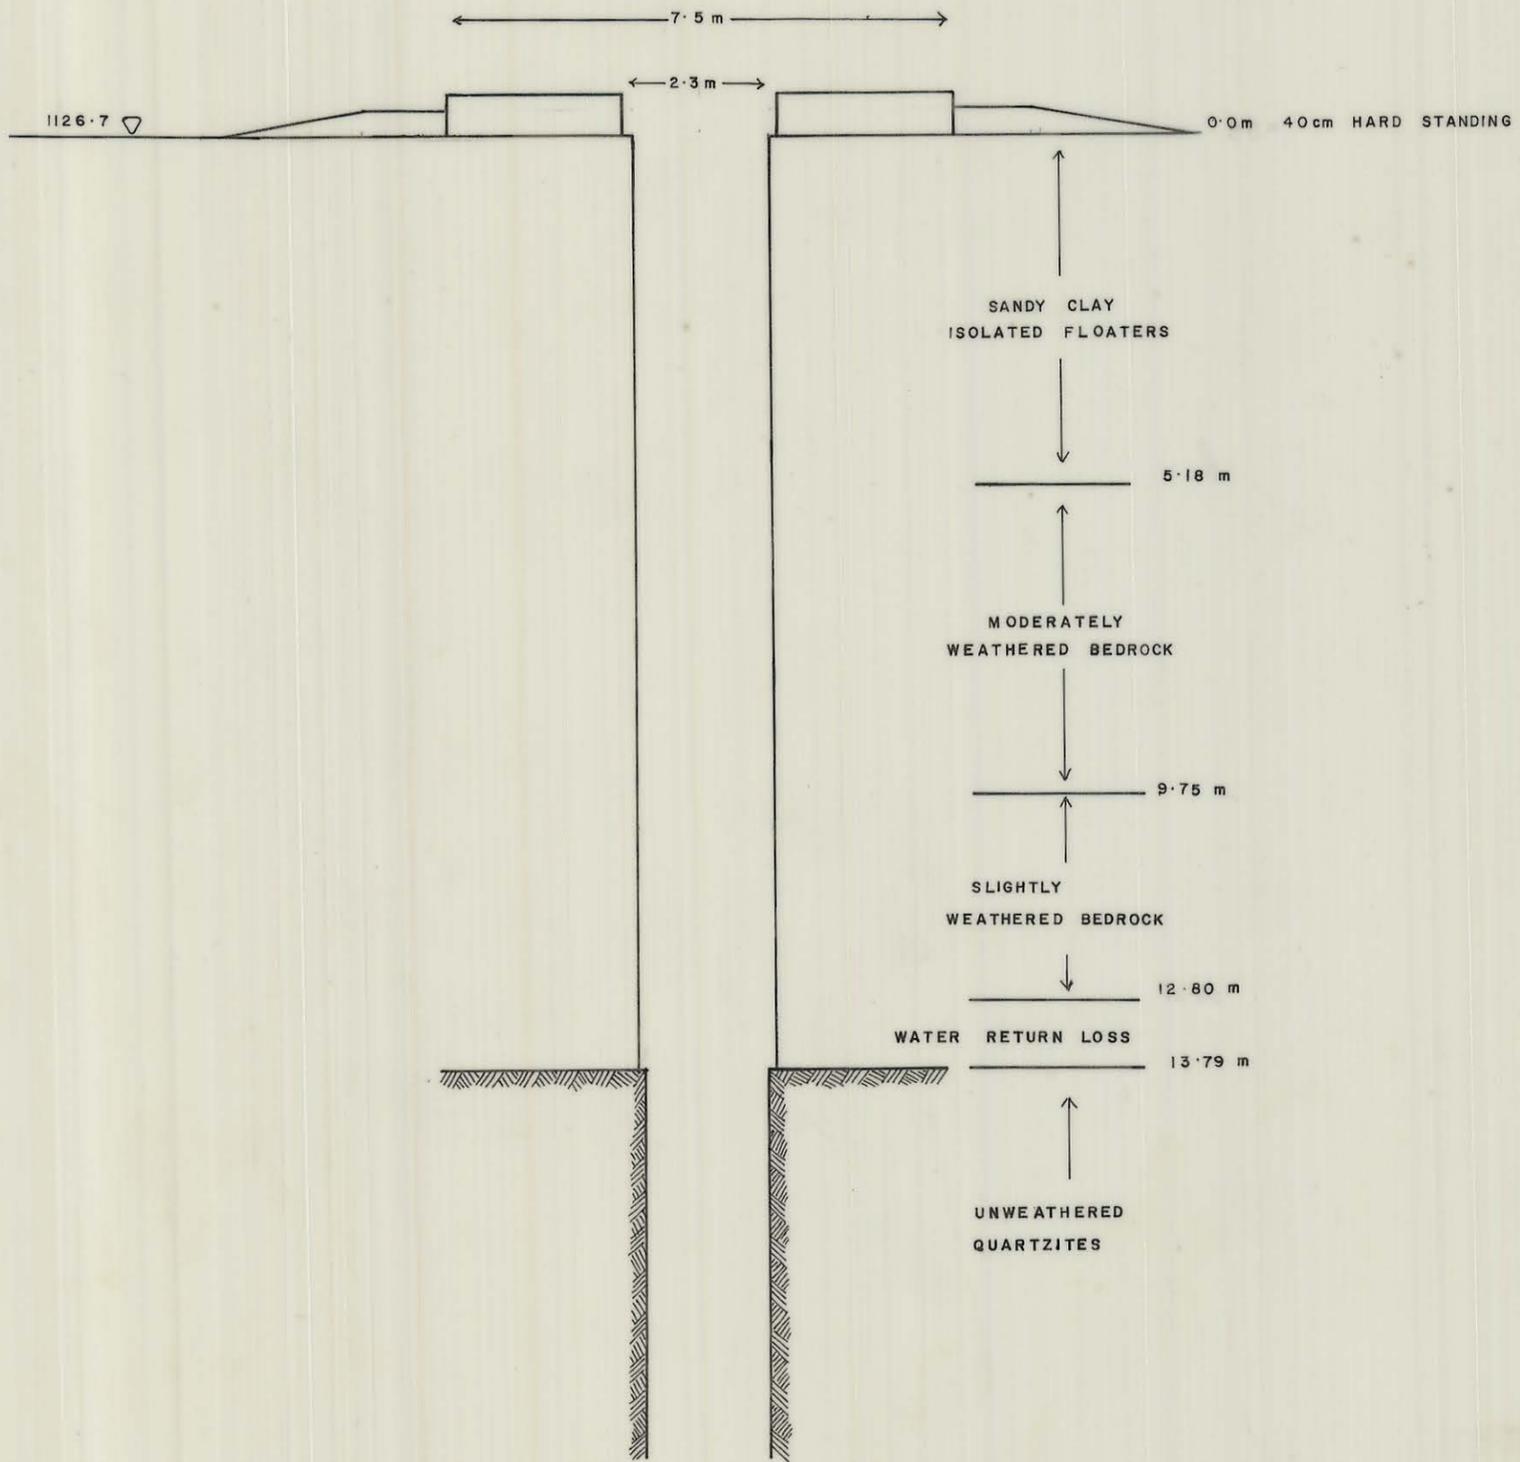

KING ISLAND SCHEELITE LTD.

SCALE 1:100

No 1-5-74

DATE 11-7-74
SURVEYED
DRAWN M.D.B.
TRACED
CHECKED R.S.

BOLD HEAD MINE

MANWAY OVERBURDEN SECTION

0374_3774